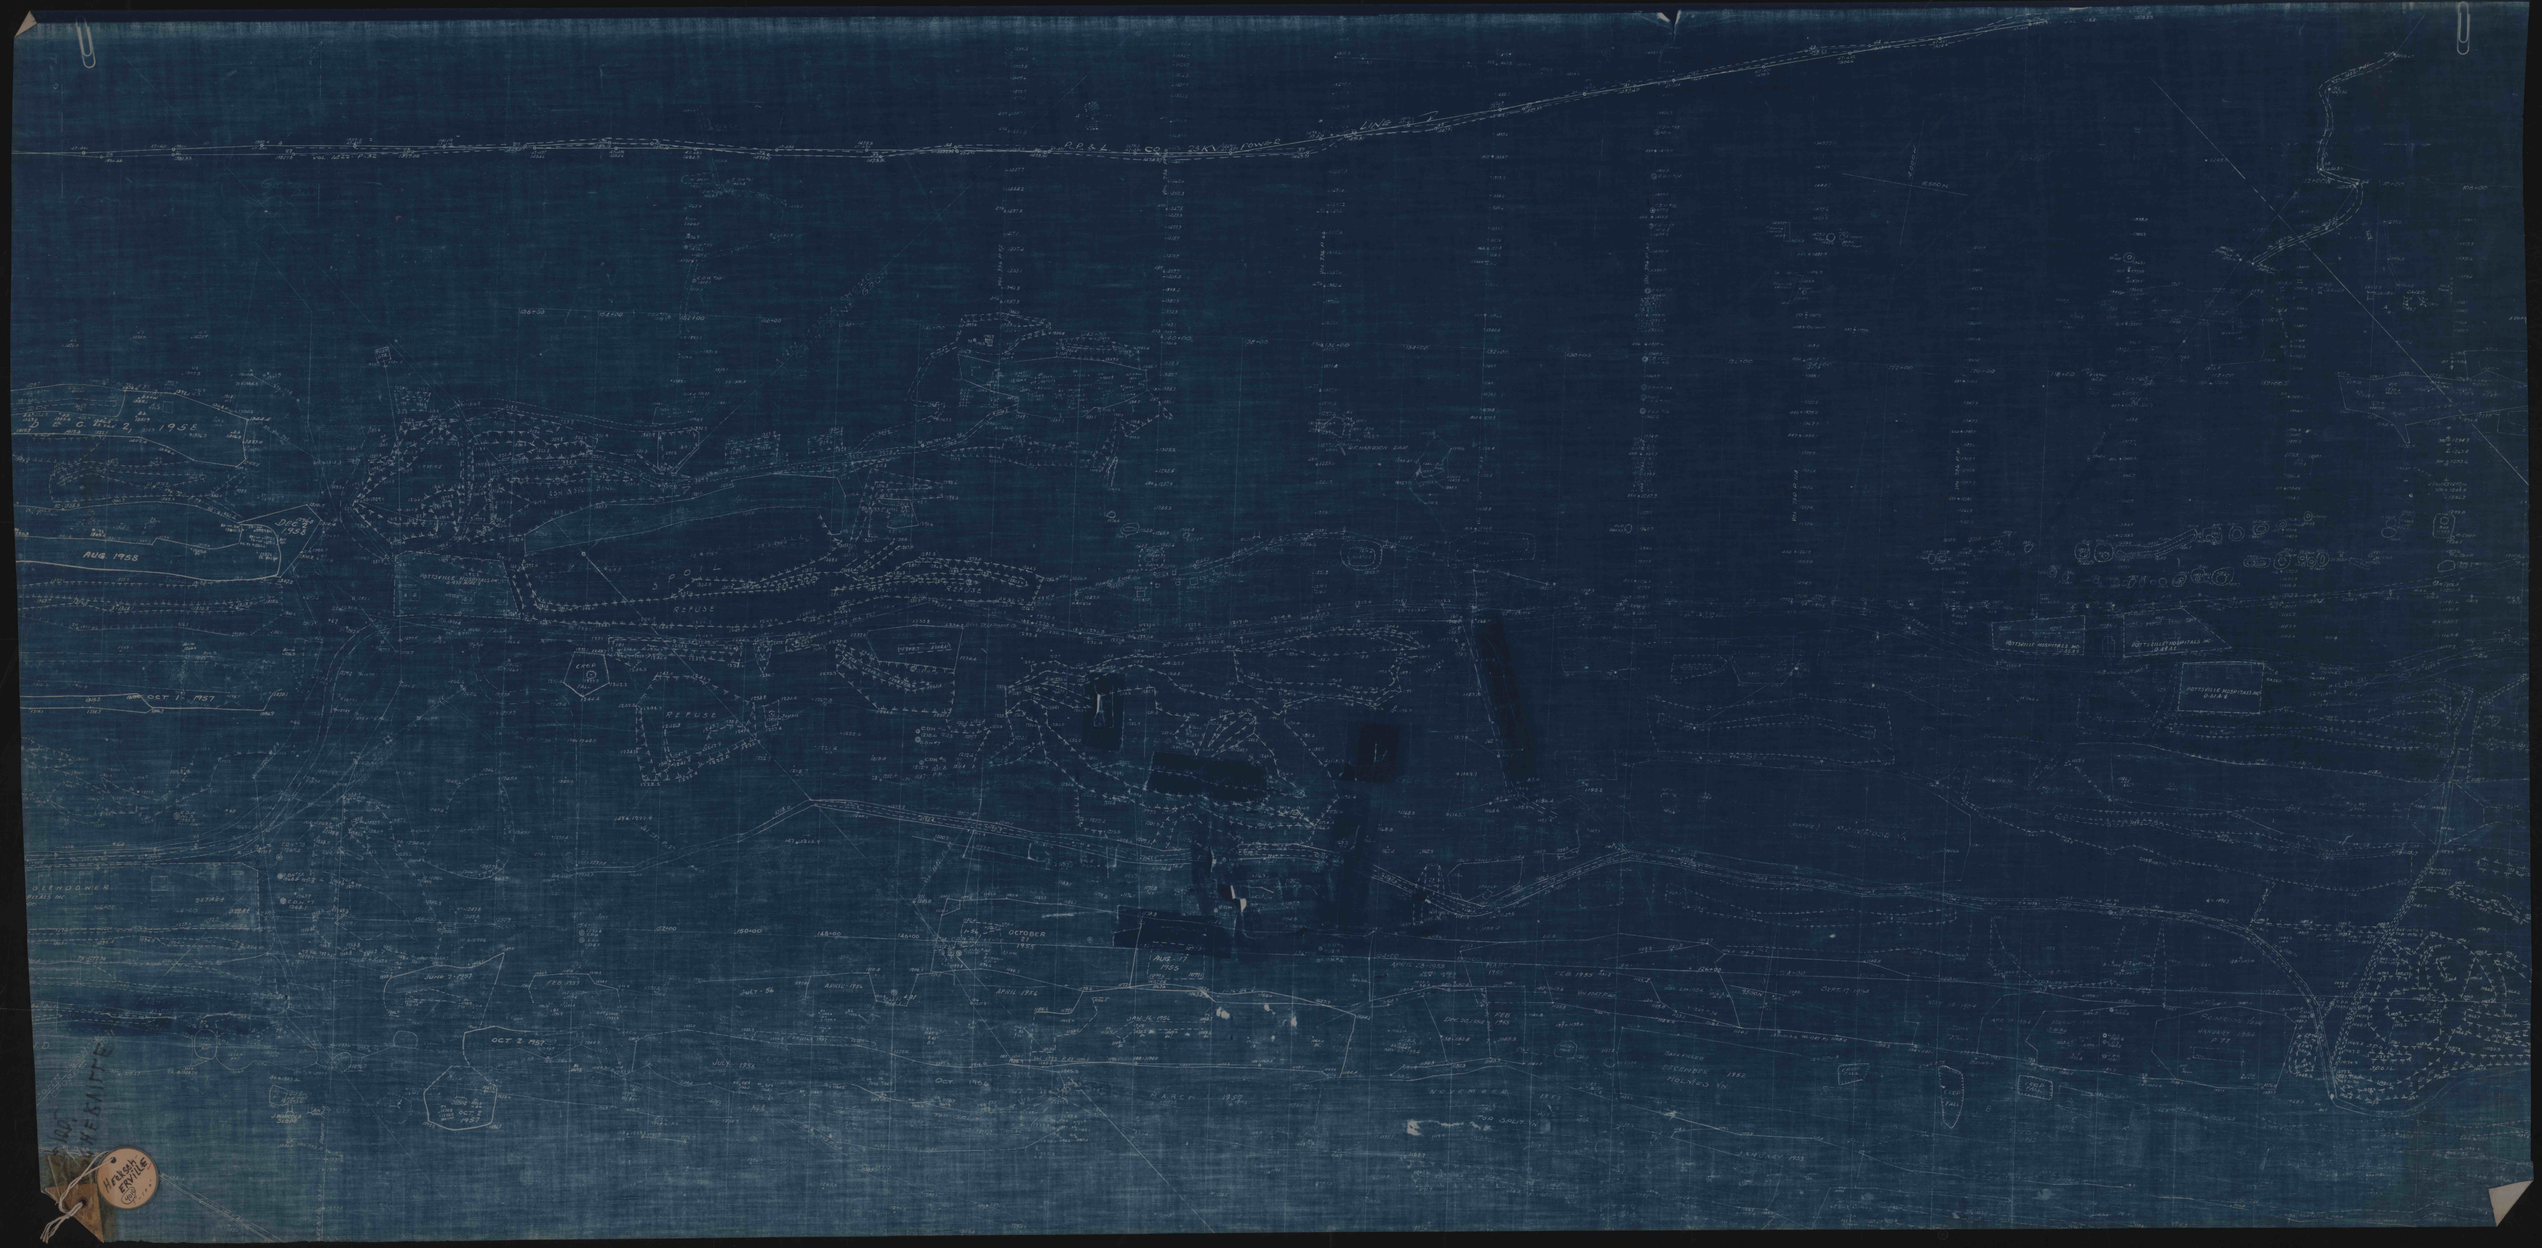
P.P.&L. CO. 22KV TOWER
LINE NO. 1
DEC. 2, 1958
AUG 1958
DEC 2 1958
POTTSVILLE HOSPITAL
REFUSE
POLL
OCT 7 1957
POTTSVILLE HOSPITALS INC.
POTTSVILLE HOSPITALS INC. GARAGE
OLENDOWER PICKLES INC.
OCTOBER 21 1958
AUG 17 1955
APRIL 1956
JULY 1956
OCT 2 1957
MARCH 1957
NOVEMBER 1957
JANUARY 1957
FEB 1957
OCT 1956
DECEMBER 1956
HOLMES VA.
WEIMERSDORF DAM
RUN OF MINE
LINE 1