


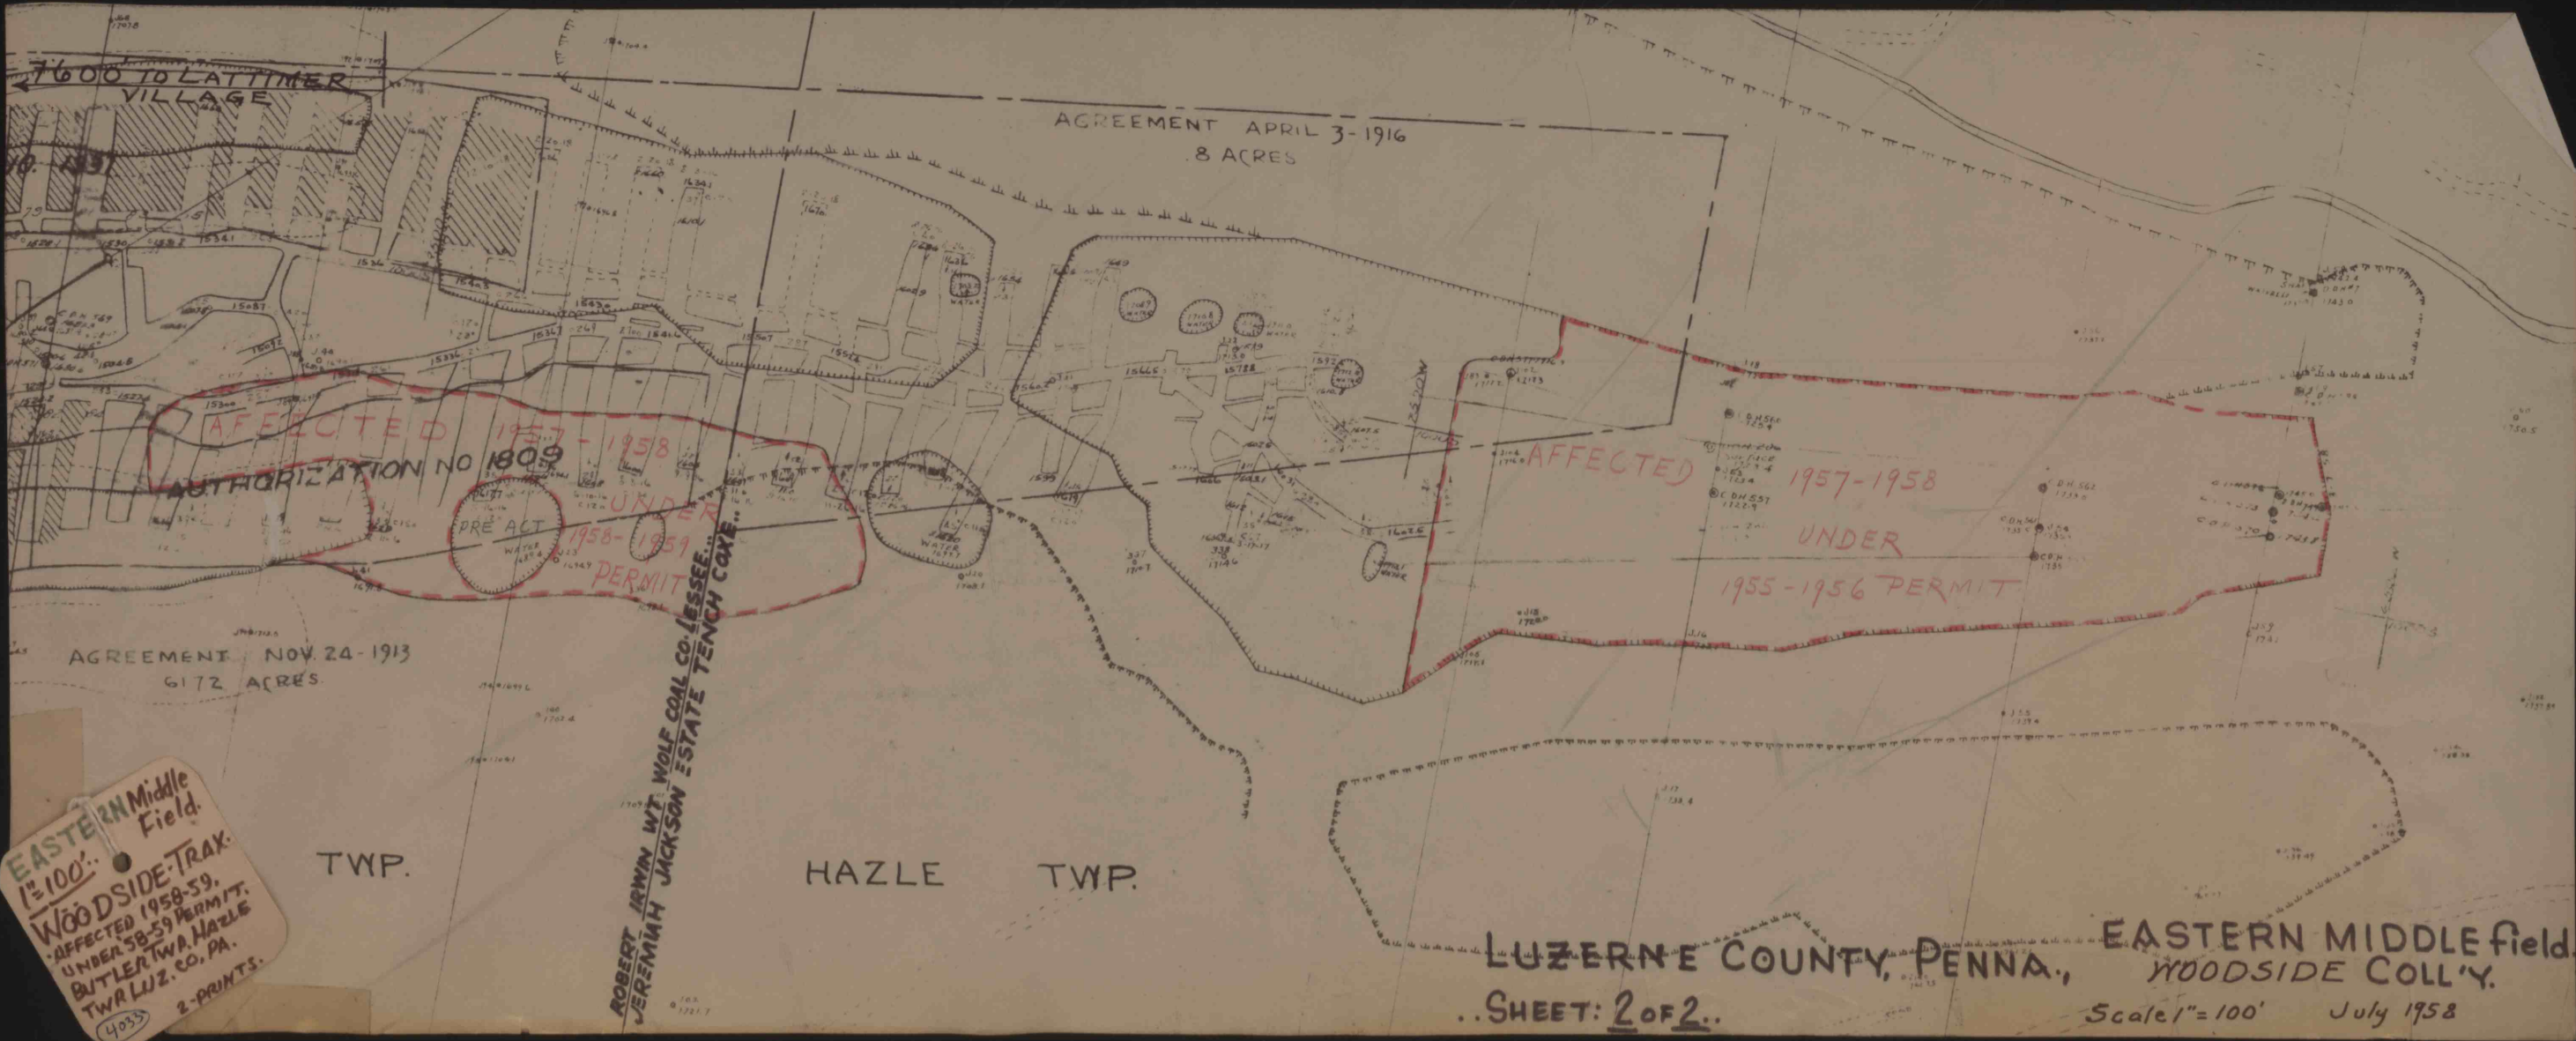

EASTERN Middle Field.
12=100'.
WOODSIDE-TRAX.
AFFECTED 1958-59.
UNDER 58-59 PERMIT.
BUTLER TWP. HAZLE TWP. LUZ. CO. PA.
4033 2-PRINTS.

ROBERT IRWIN WT. WOLF COAL CO. LESSEE
JEREMIAH JACKSON ESTATE TENCH COKE

LUZERNE COUNTY, PENNA., EASTERN MIDDLE field.
WOODSIDE COLL'Y.
SHEET: 2 OF 2. Scale 1"=100' July 1958