
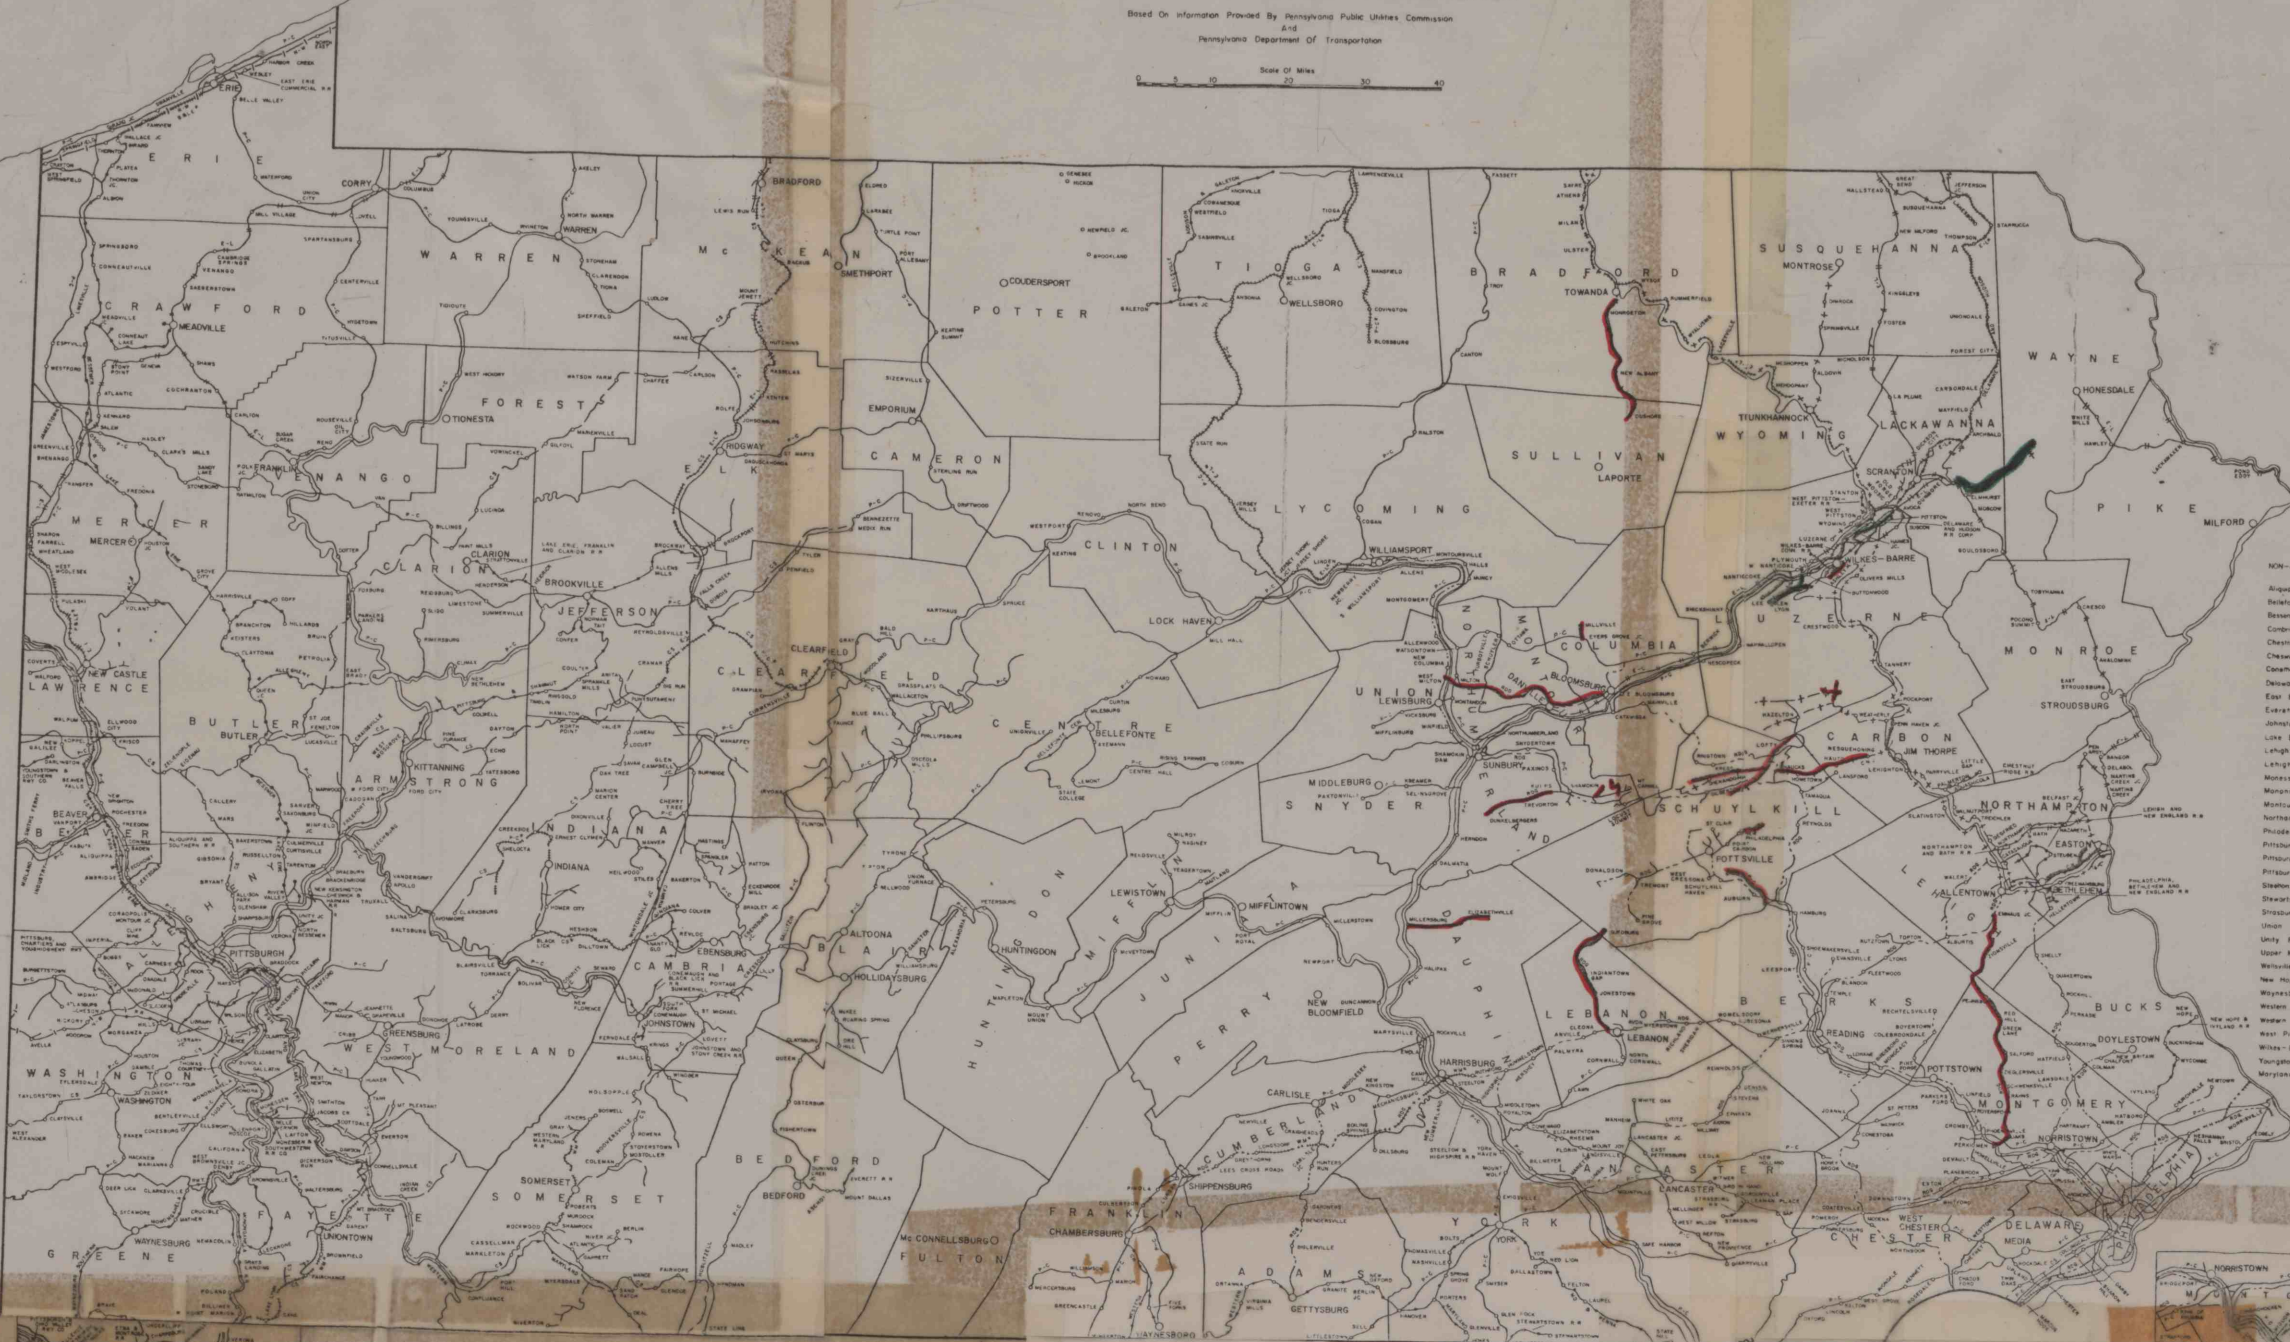


PREPARED BY OFFICE OF STATE PLANNING AND DEVELOPMENT

Based On Information Provided By Pennsylvania Public Utilities Commission  
And  
Pennsylvania Department Of Transportation

 

- — — — — ● PENN CENTRAL
- — — — — CHESSIE SYSTEM B & O
- - - - - ● READING COMPANY
- — — — — ● ERIE LACKAWANNA
- + - + - ● LEHIGH VALLEY - CENTRAL OF N. J.
- | - | - NORFOLK AND WESTERN
- — — — — ● NON - AFFILIATED

~~\_\_\_\_\_~~ Penn (Centa), Reading, Lehigh Valley  
~~\_\_\_\_\_~~ Erie Lockawana

Railroads With Trackage Rights  
Shown With Asterisk (\*)

