


RAILROADS OF PENNSYLVANIA

PREPARED BY OFFICE OF STATE PLANNING AND DEVELOPMENT

Based on information provided by Pennsylvania Public Utilities Commission
and
Pennsylvania Department of Transportation

Scale of Miles
0 10 20 30 40

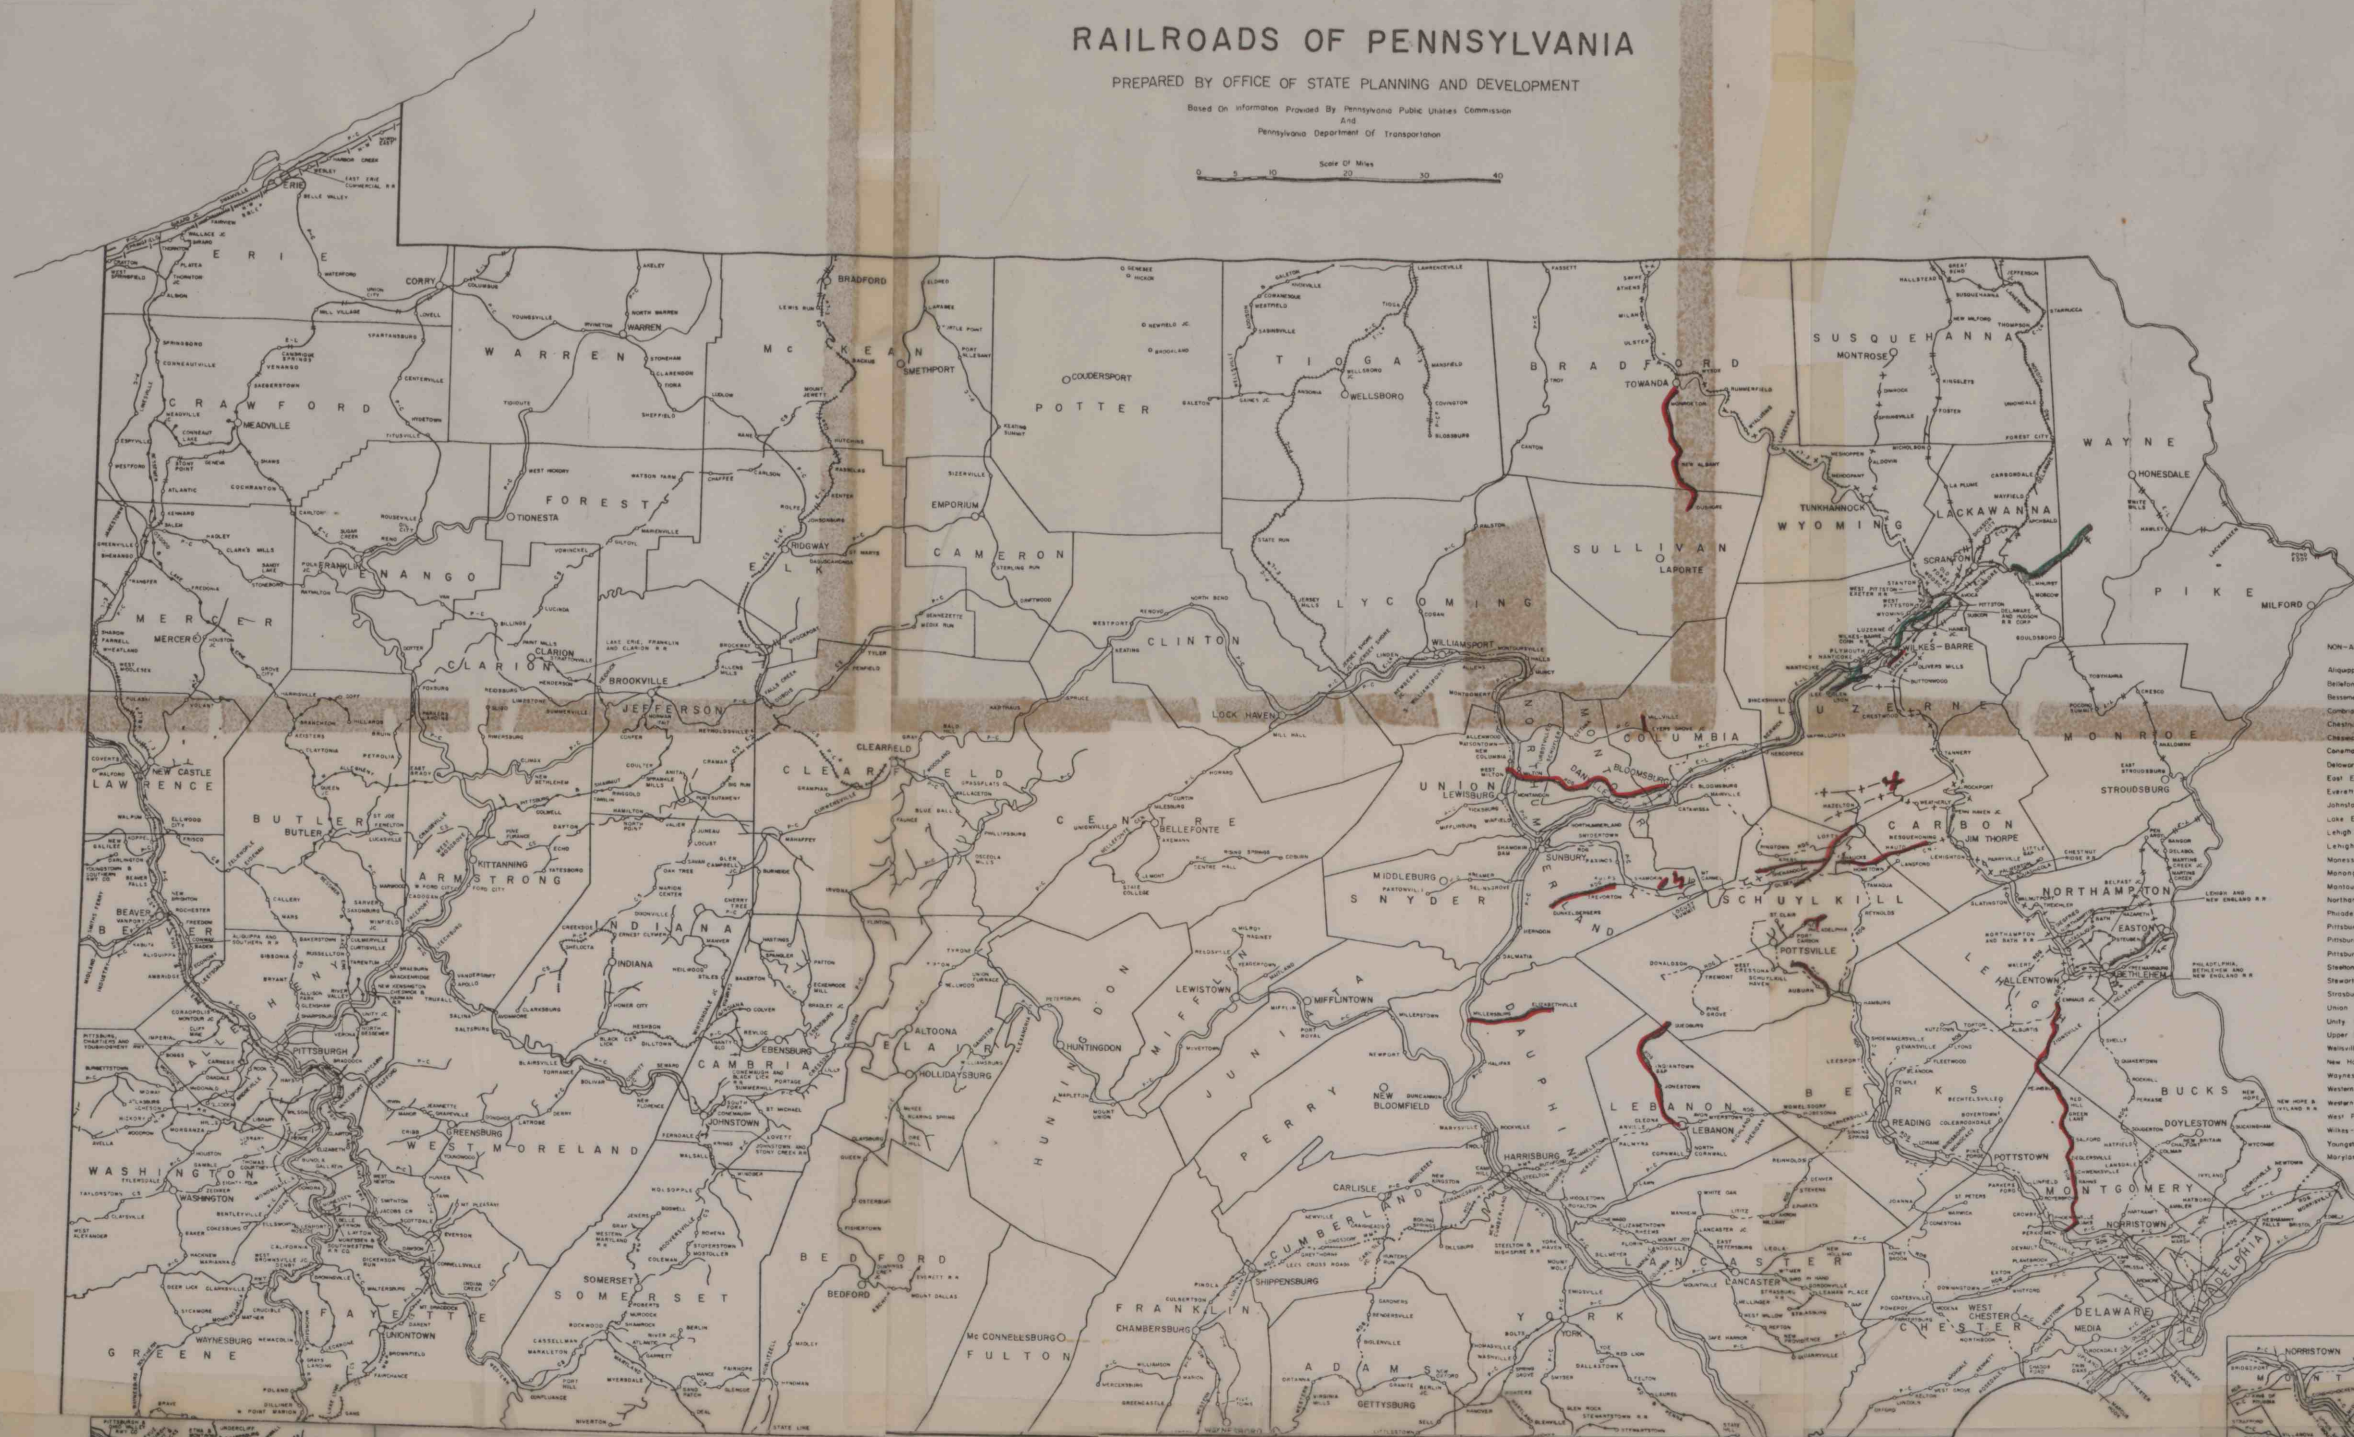

NON-AFFILIATED RAILROADS OPERATING IN PENNSYLVANIA

- Allegheny & Southern R.R. Co.
- Allegheny Central R.R. Co.
- Baltimore & Lake Erie R.R. Co.
- Cambria & Indiana R.R. Co.
- Chester & Delaware R.R. Co.
- Chester & Hudson River R.R. Co.
- Chester & York R.R. Co.
- Delaware & Hudson R.R. Corp.
- East Erie Commercial R.R.
- East Erie R.R. Co.
- Johnstown & Stony Creek R.R. Co.
- Lake Erie, Frank & Canon R.R. Co.
- Lehigh & Hudson River R.R. Co.
- Lehigh & New England R.R. Co.
- Monongahela & York R.R. Co.
- Monongahela R.R. Co.
- Montour R.R. Co.
- Northampton & Bath R.R. Co.
- Philadelphia, Germantown & New England R.R. Co.
- Pittsburgh, Chartiers & Tuguehany R.R.
- Pittsburgh & Lake Erie R.R. Co.
- Pittsburgh & Shawmut R.R. Co.
- Shawmut & Highgate R.R. Co.
- Stewartson R.R.
- Stroudsburg R.R.
- Union R.R. Co.
- Unity R.R. Co.
- Upper Merion & Plymouth R.R. Co.
- Warrington, Addison & Gettysburg R.R. Corp.
- New Hope & Lyndale R.R.
- Waynesburg Southern R.R.
- Western Maryland R.R. Co.
- Western Maryland R.R. Co.
- West Potomac-Erie R.R. Co.
- Wilkes-Barre Connecting R.R. Co.
- Youngstown & Southern R.R. Co.
- Maryland & Pennsylvania R.R. Co.




LEGEND

- PENN CENTRAL
- CHESSIE SYSTEM B&O
- READING COMPANY
- ERIE LACKAWANNA
- LEHIGH VALLEY - CENTRAL OF N. J.
- NORFOLK AND WESTERN
- NON-AFFILIATED

—•—•— Penn Cental, Reading, Lehigh Valley
—•—•— Erie Lackawanna

Railroads With Trackage Rights
Shown With Asterisk (*)

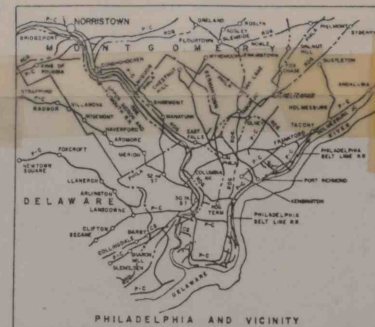

March 1974