


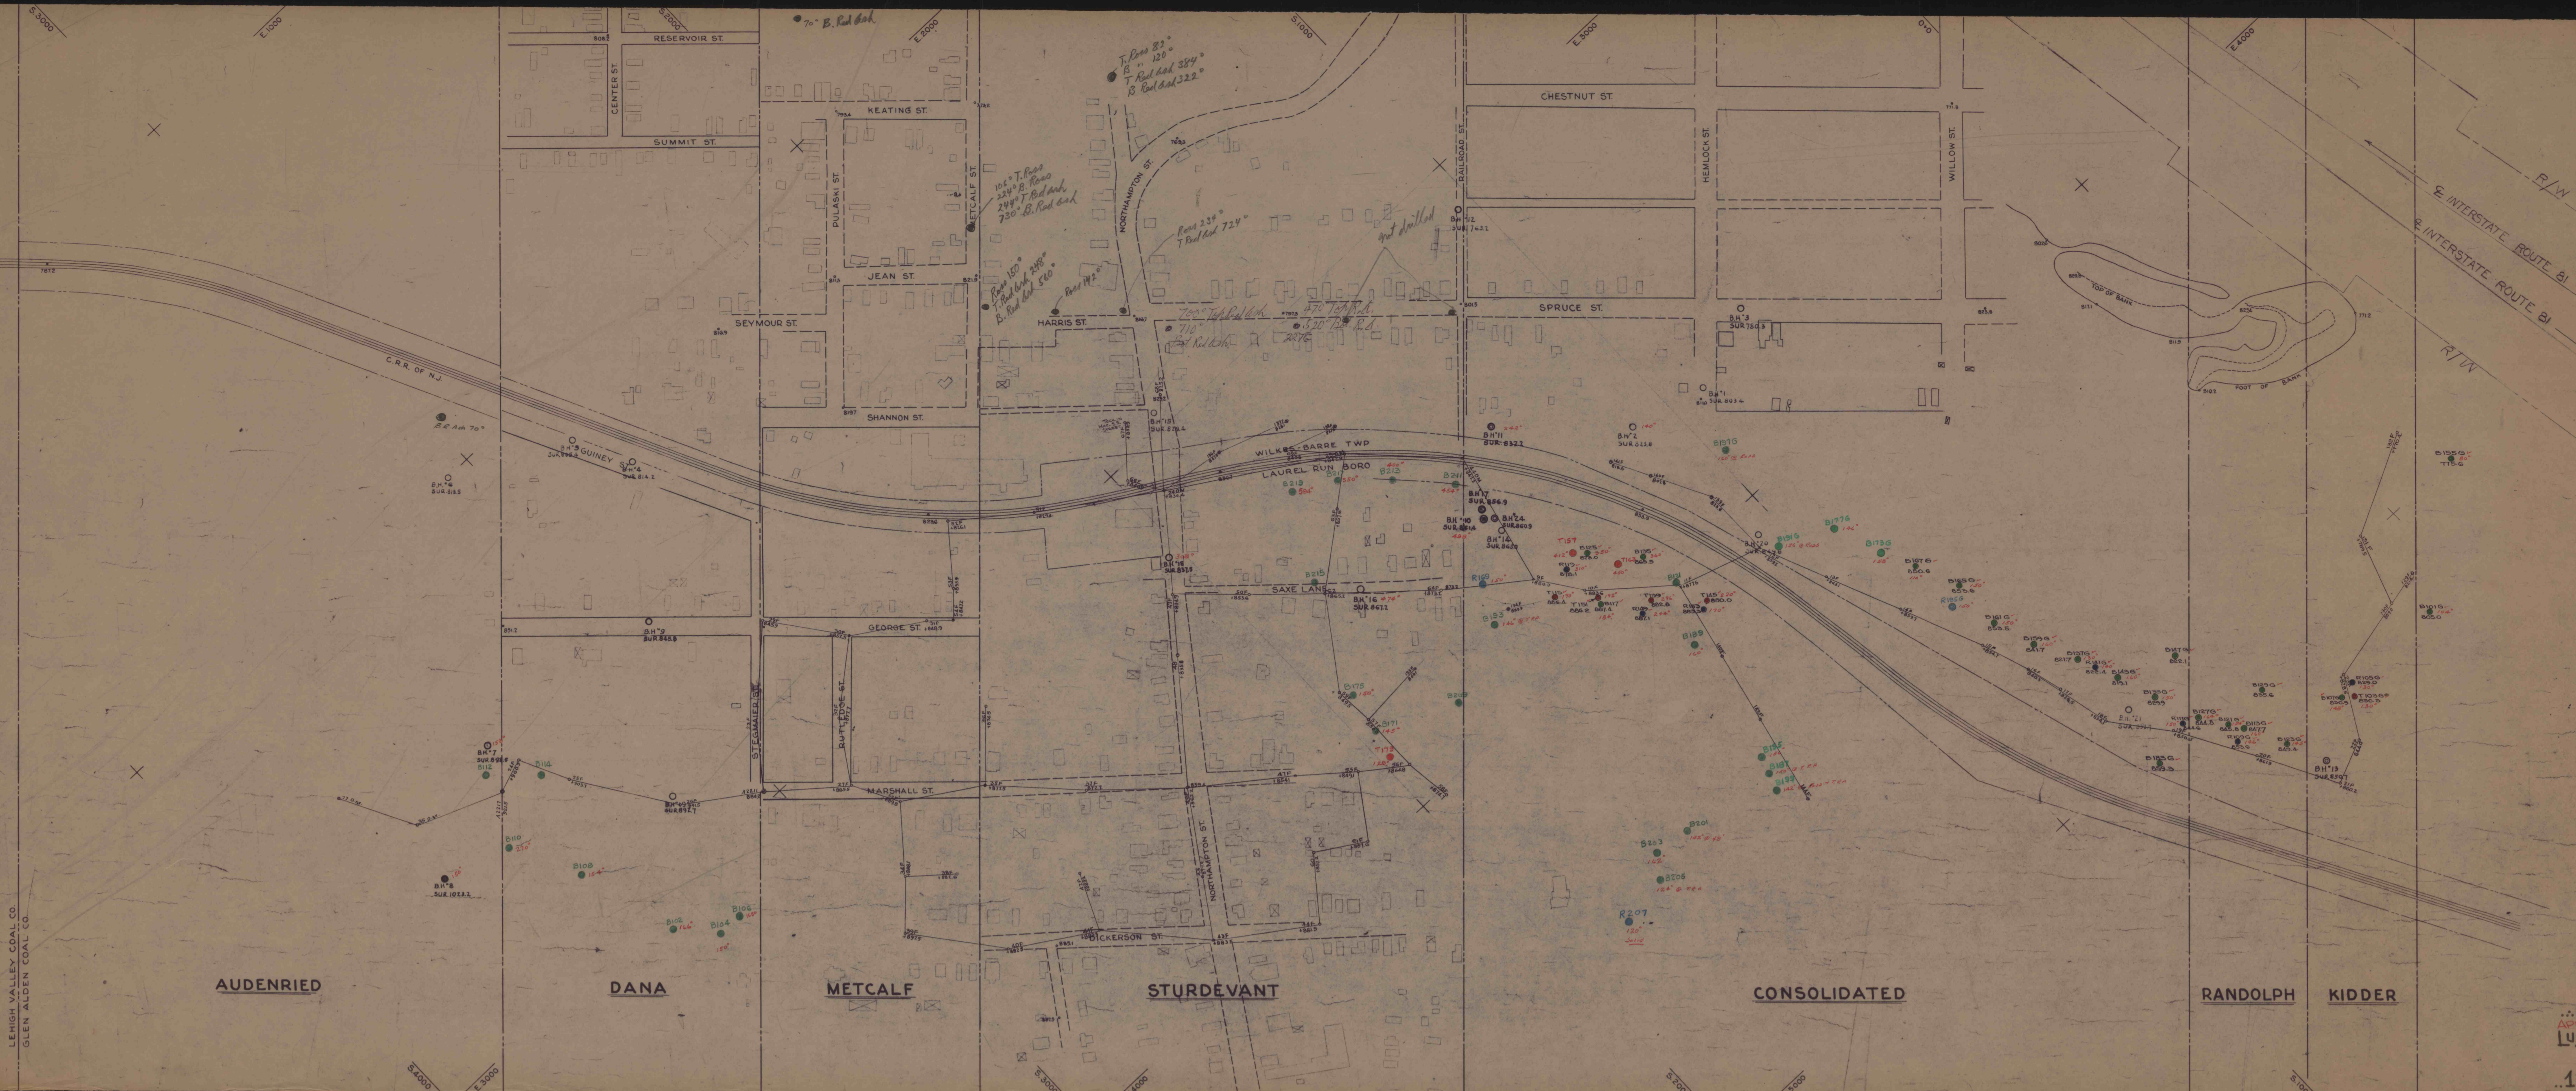

LEHIGH VALLEY COAL CO
GLEN ALDEN COAL CO

AUDENRIED

DANA

METCALF

STURDEVANT

CONSOLIDATED

RANDOLPH

KIDDER

HOLLENBACK
NORTHERN FIELD
APPALACHIAN MINE FIRE CONTROL PROJECT N-1
LUZERNE COUNTY
SCALE: 1"=100' W-B, PA. G-T-90
1 of 5