


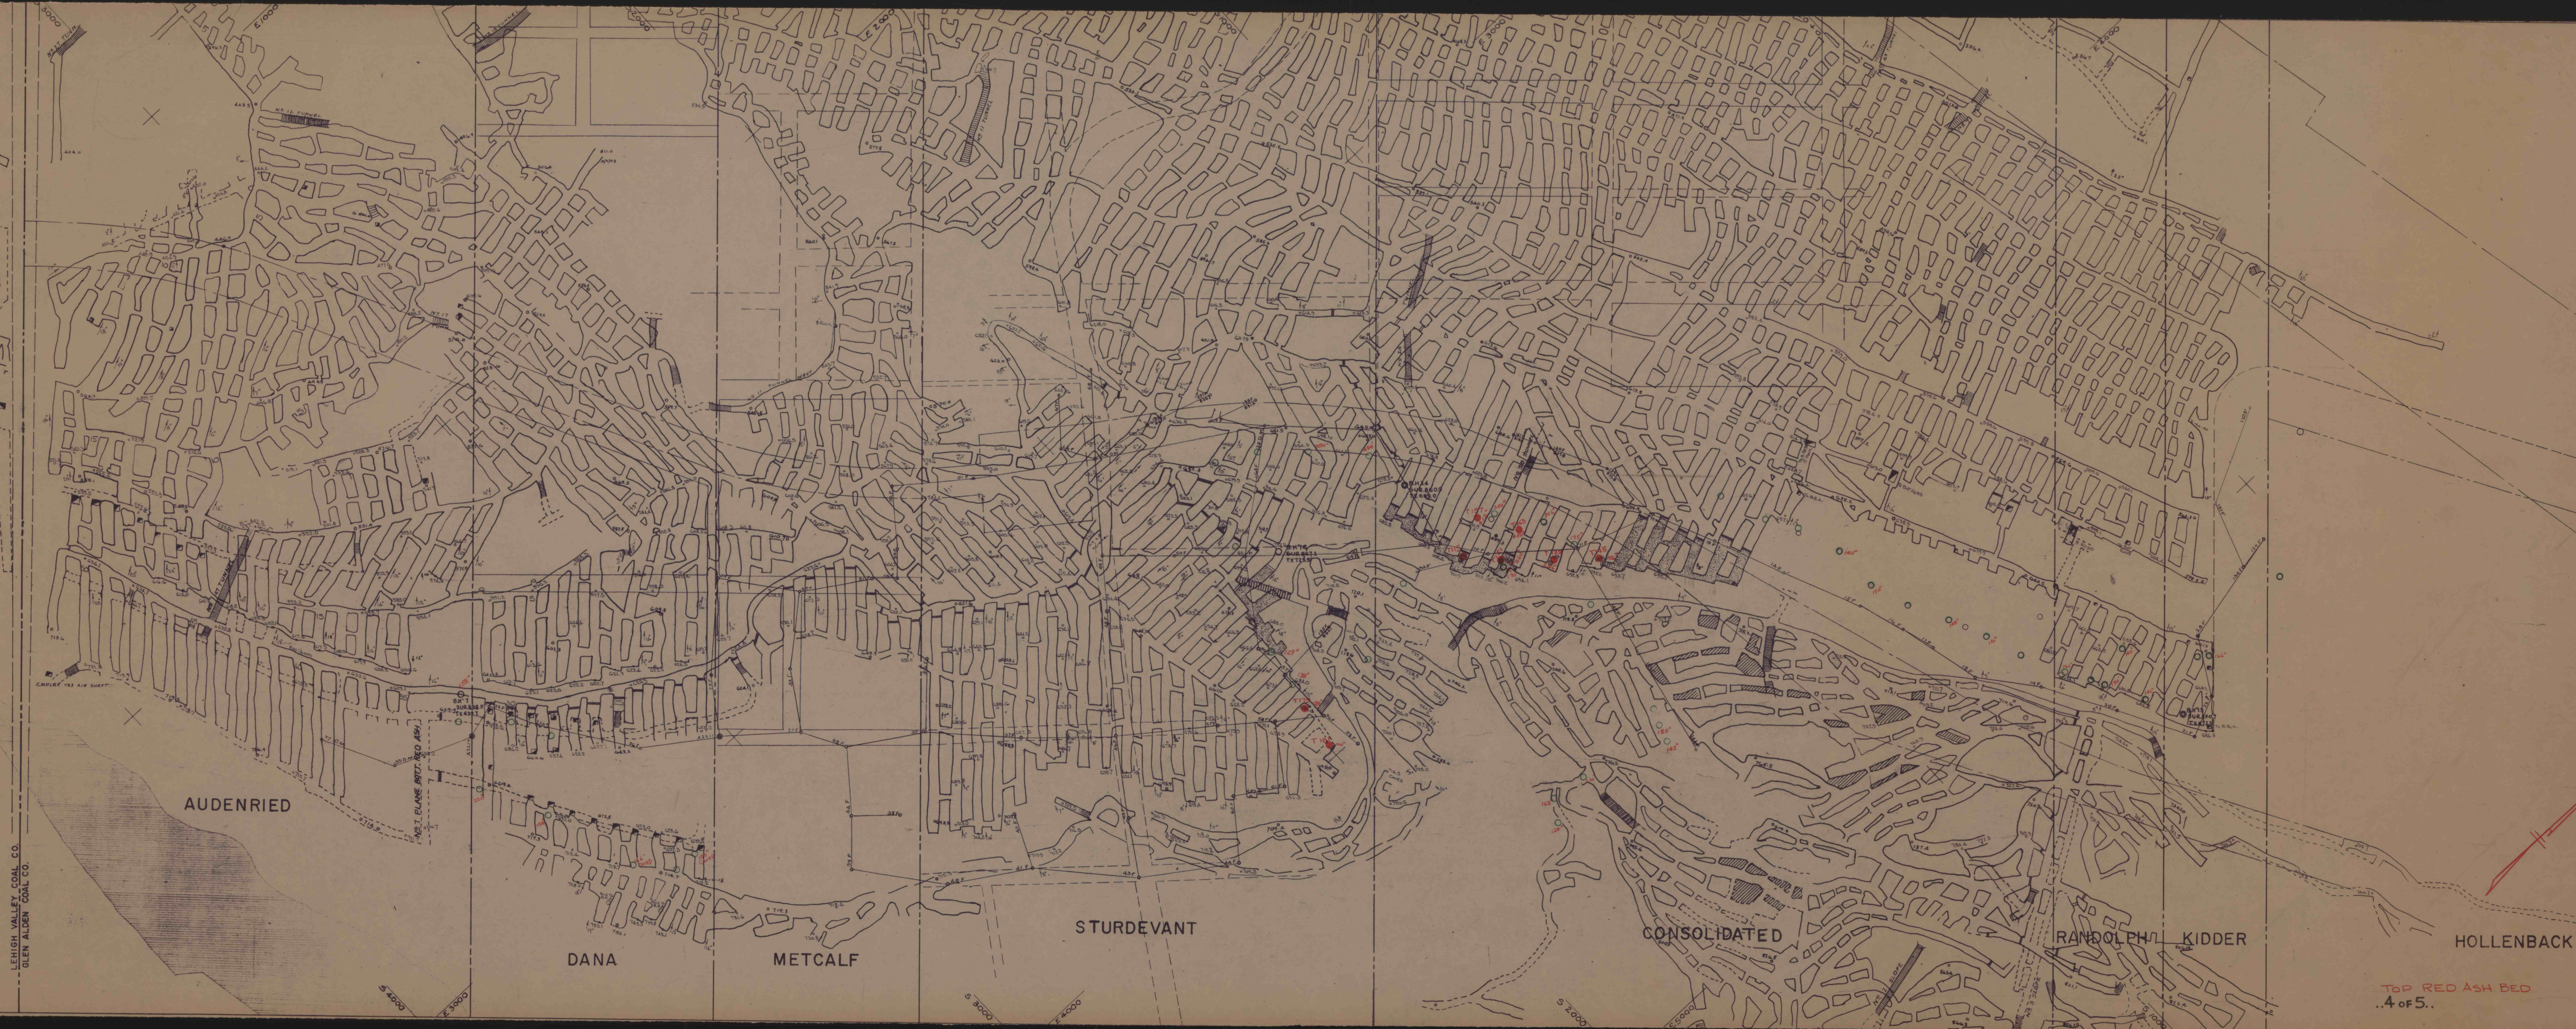

LEHIGH VALLEY COAL CO.
GLEN ALDEN COAL CO.