


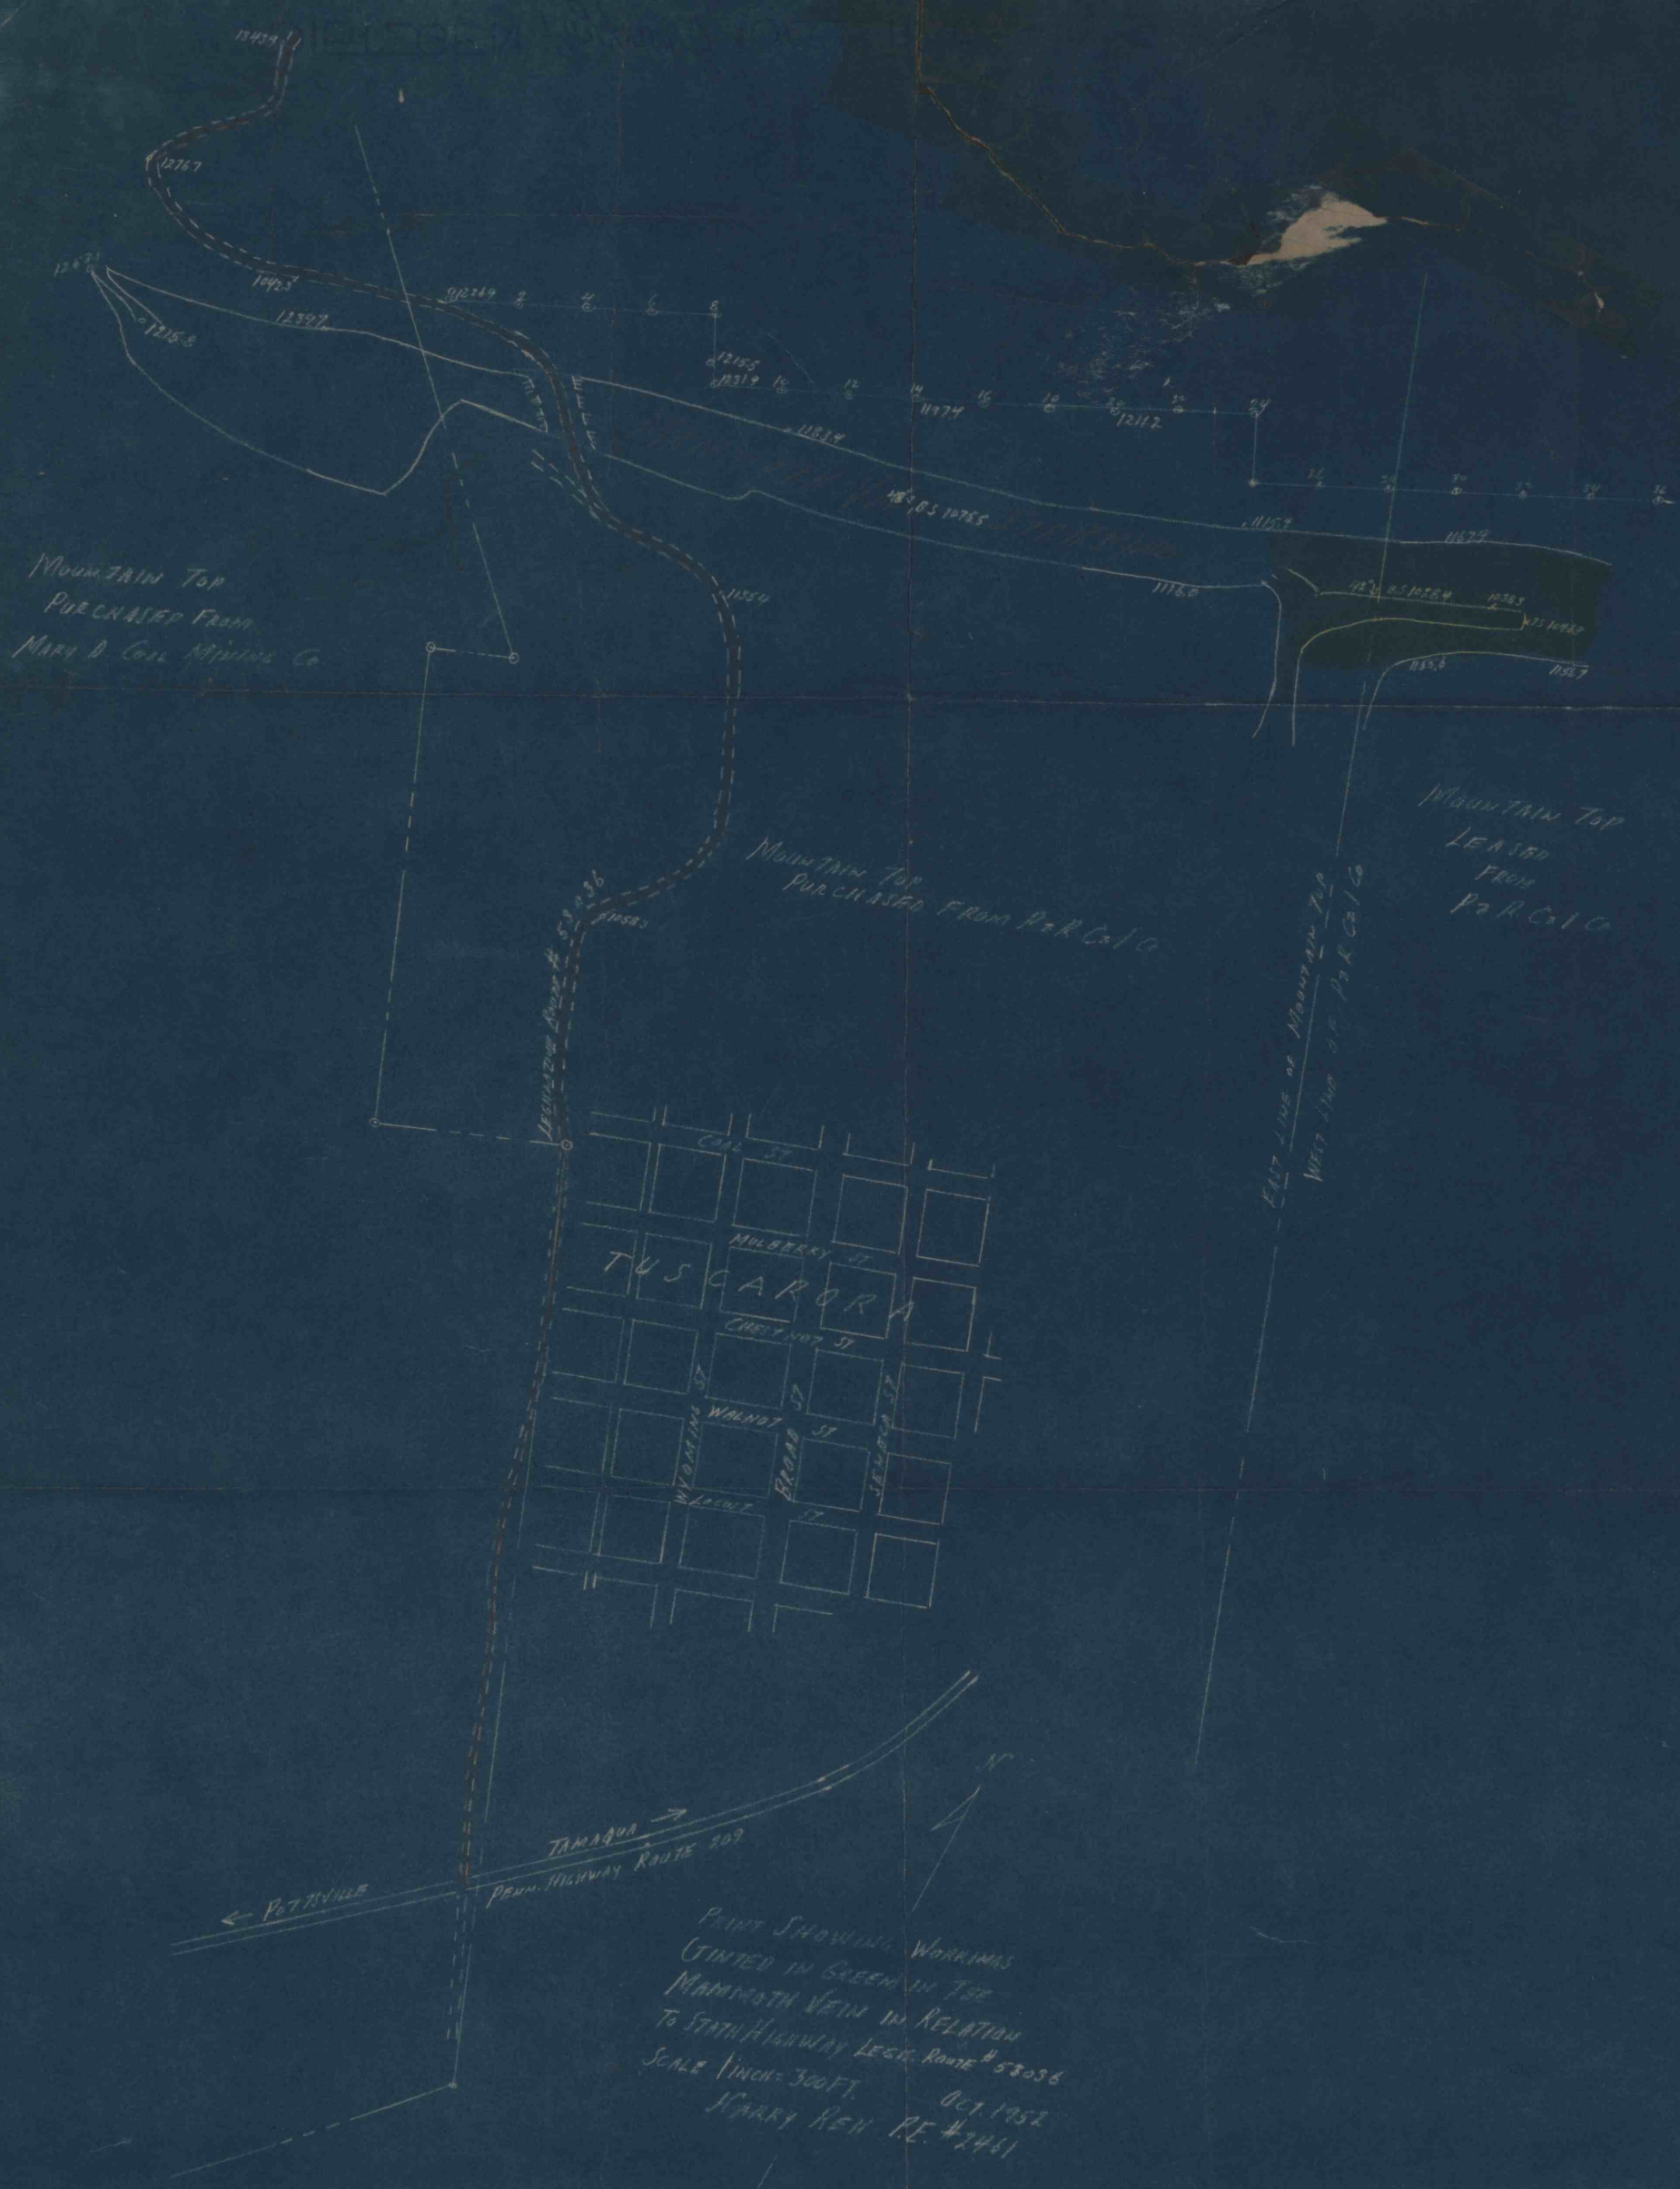

Mary D. Striping
Schuylkill Twp., Pa.

southern field 1"=300'
Mary D. Striping
Mammoth vein stripping
Schuylkill twp., county Pa.
October 1952, 1 print.
4004