


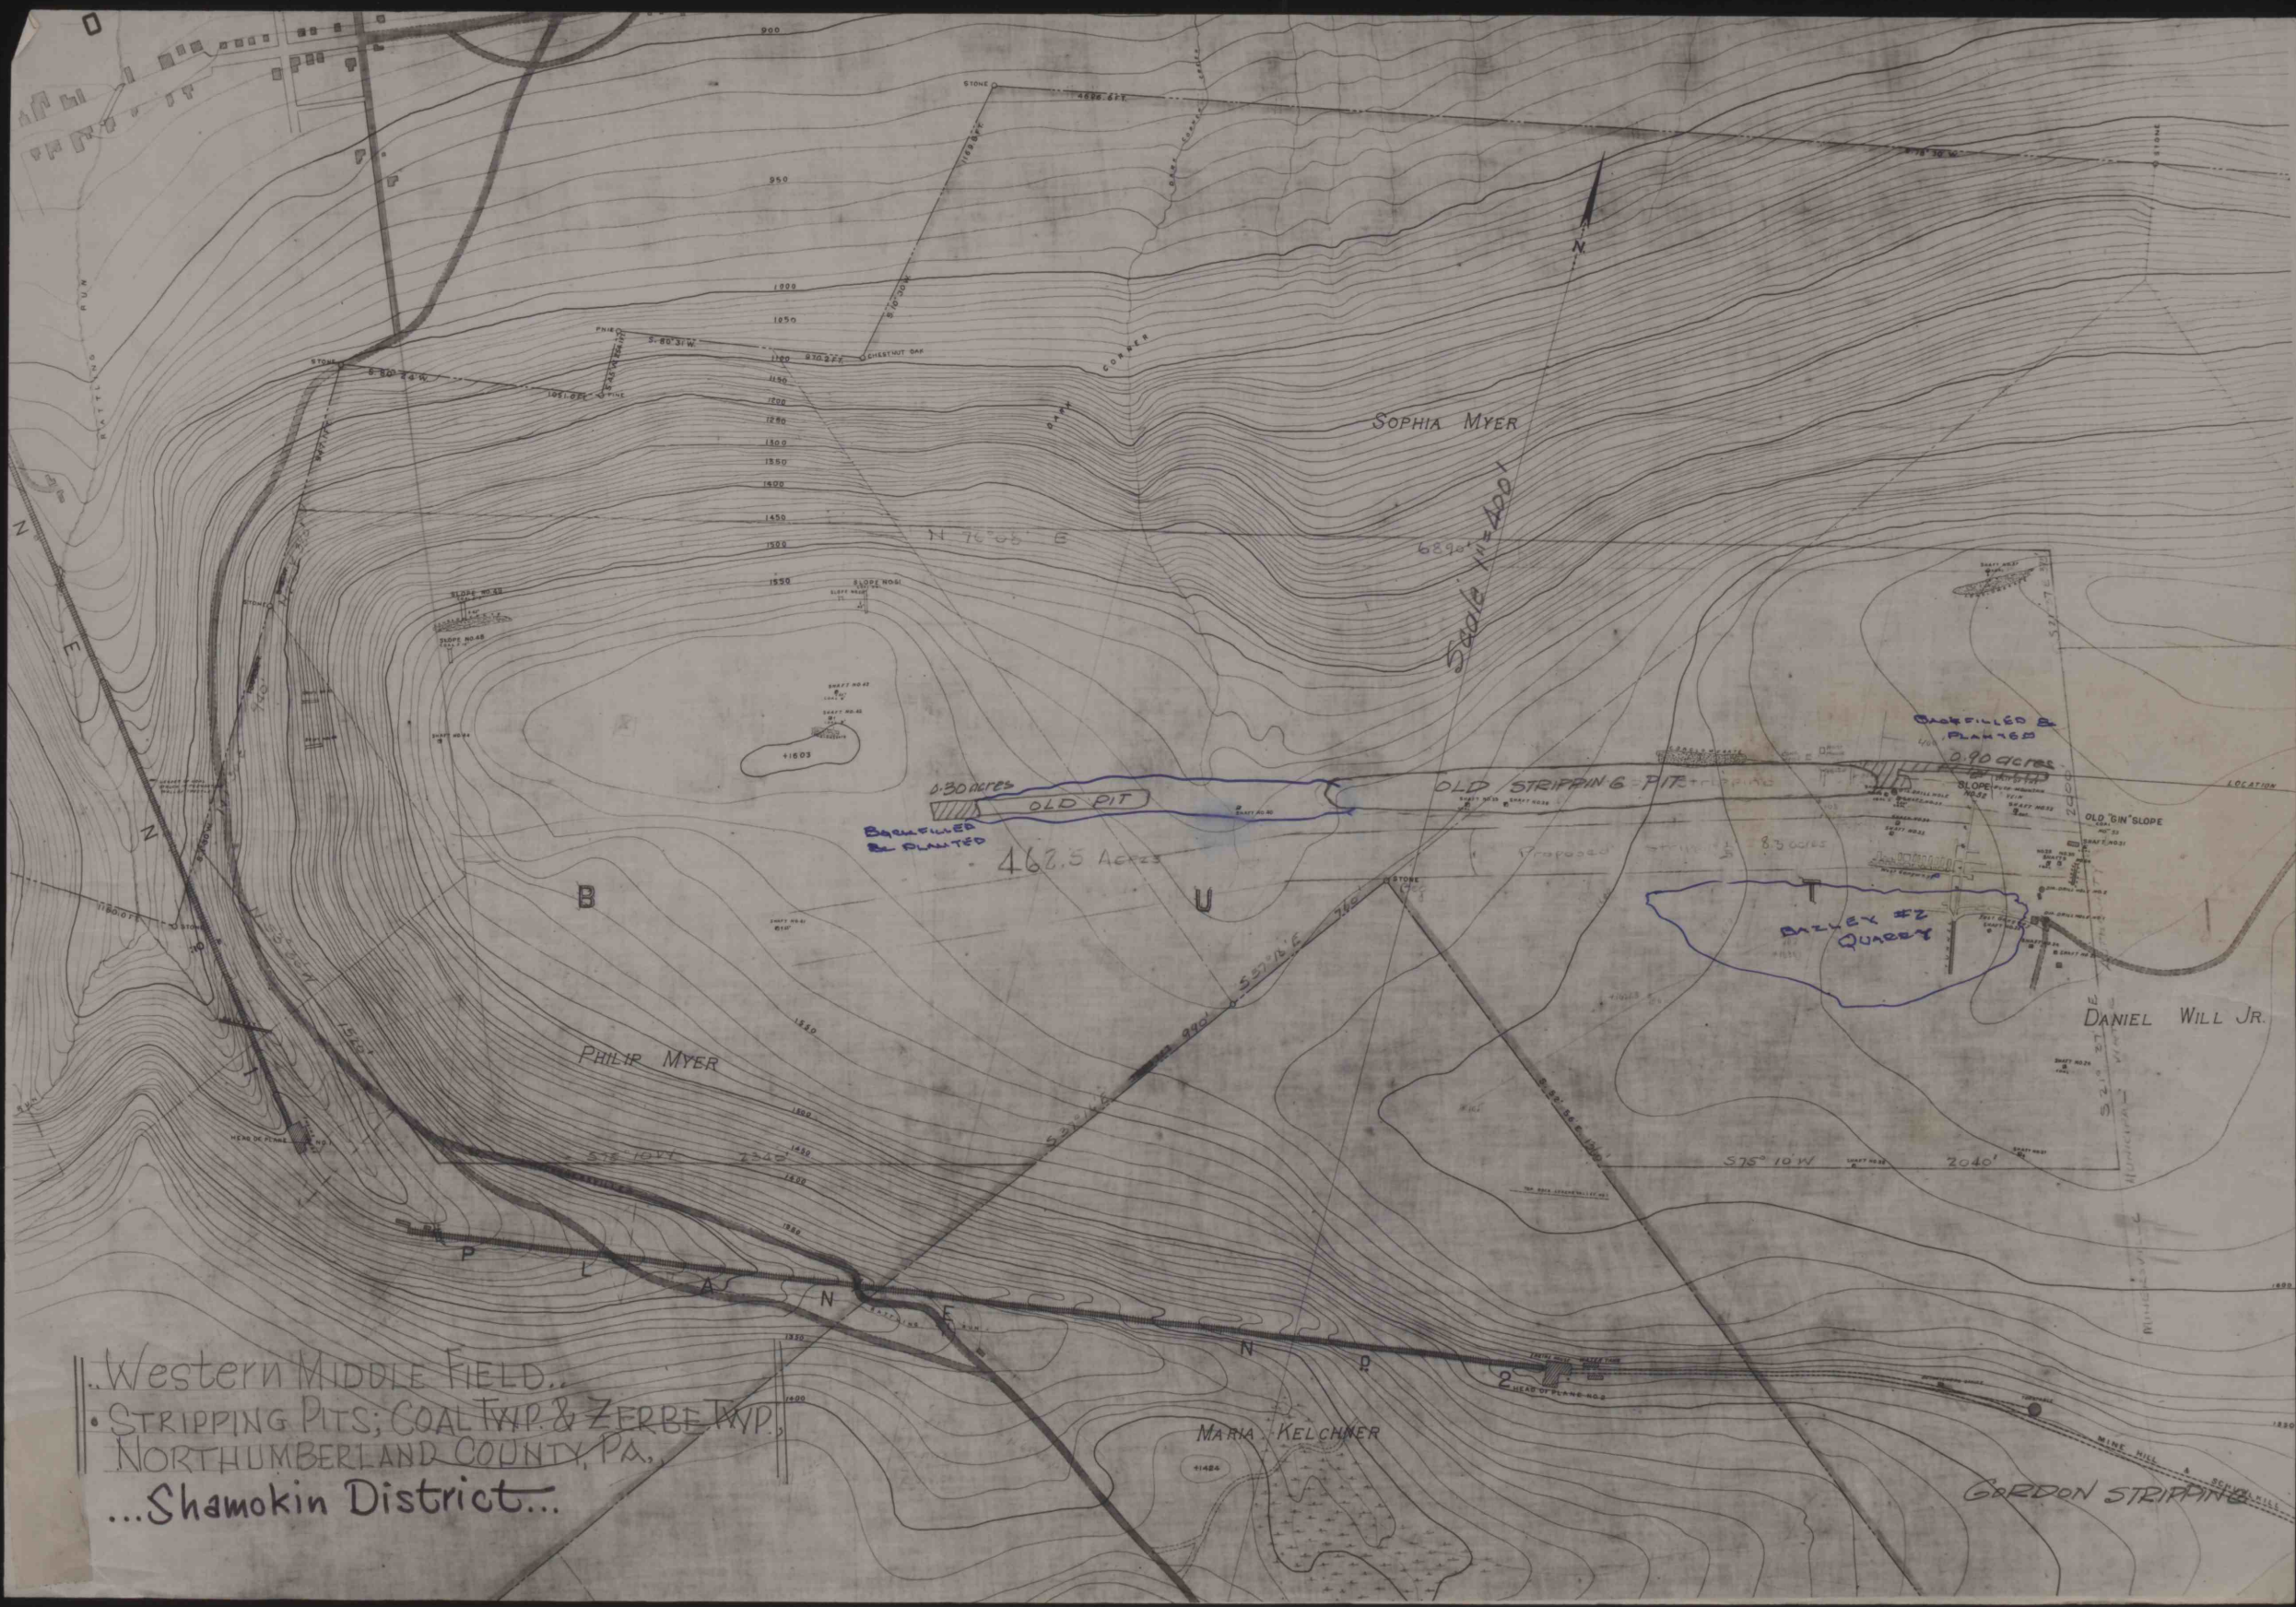

Western Middle Field.
• STRIPPING PITS; COAL TWP. & ZERBE TWP.
NORTHUMBERLAND COUNTY, PA.
...Shamokin District...