


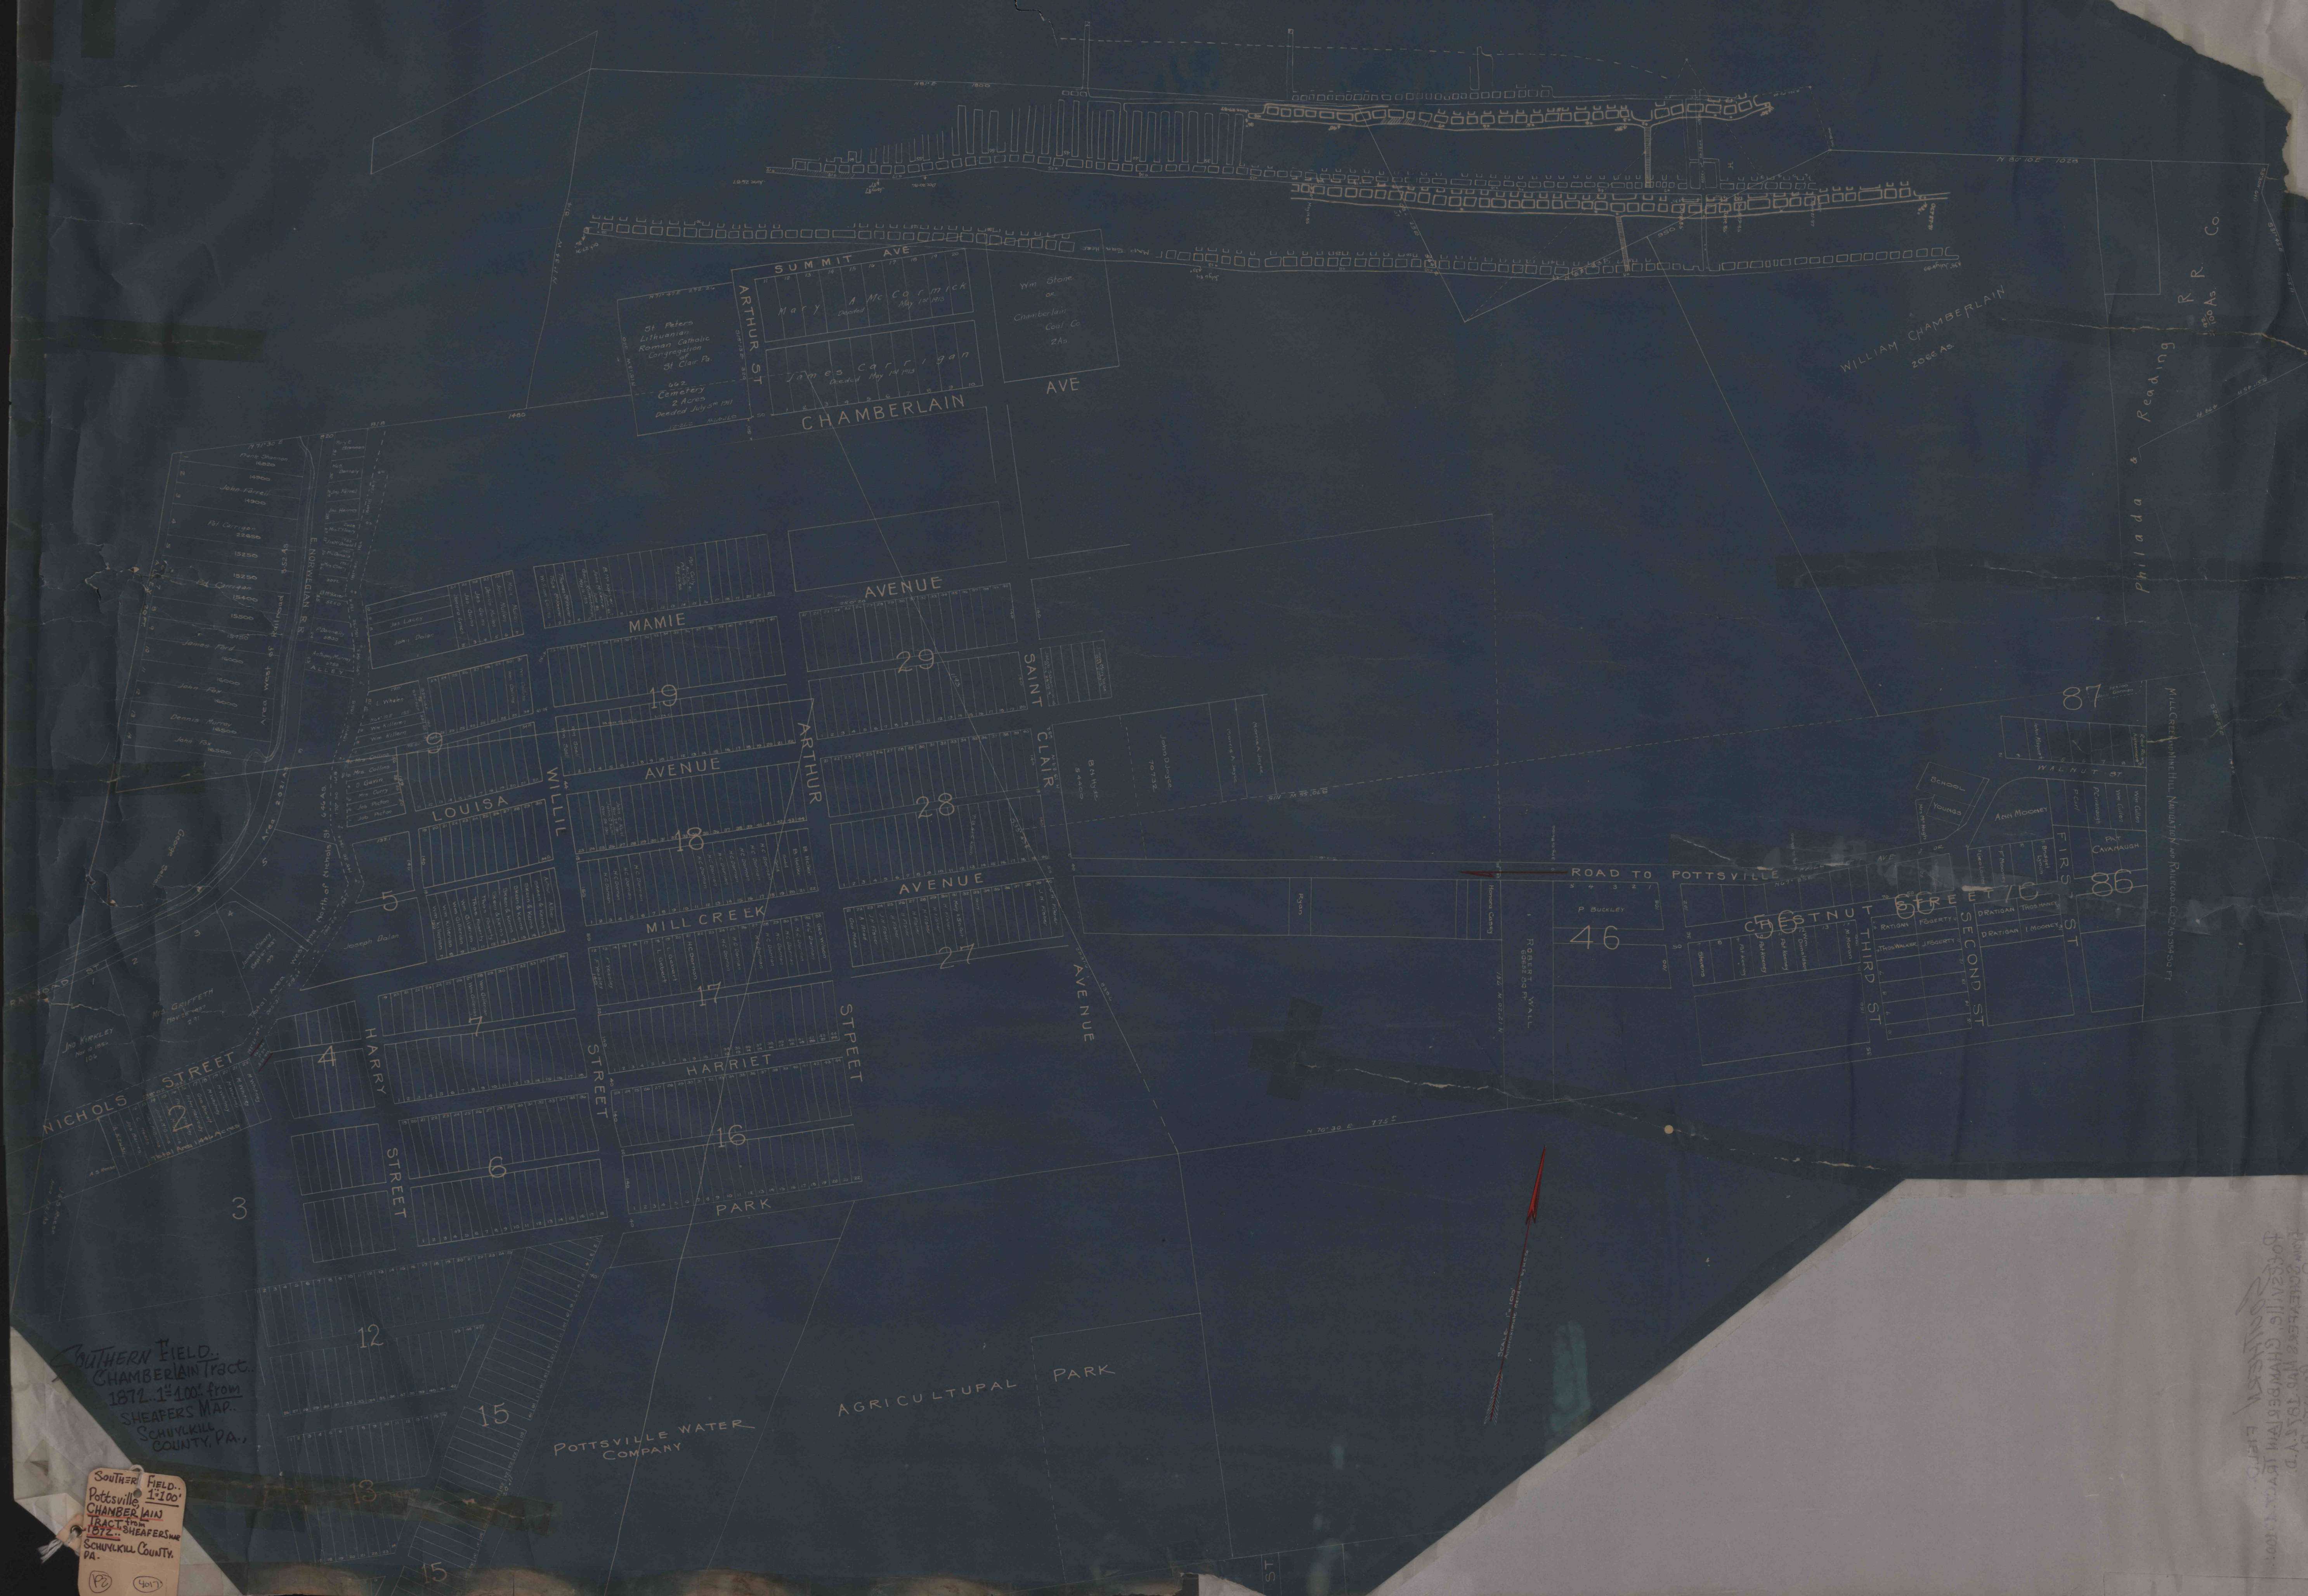

Southern Field.
Chamberlain Tract.
1872. 1st 400' from
SHEPHERD MAP.
SCHUYLKILL COUNTY, PA.

Southern Field.
Pottsville
Chamberlain Tract.
1872. 1st 400' from
SHEPHERD MAP.
SCHUYLKILL COUNTY, PA.
1-PRINT

JOHN A. KIRK COMPANY, INC.
POTTSVILLE, PA.
1872. 1st 400' from
SHEPHERD MAP.
SCHUYLKILL COUNTY, PA.