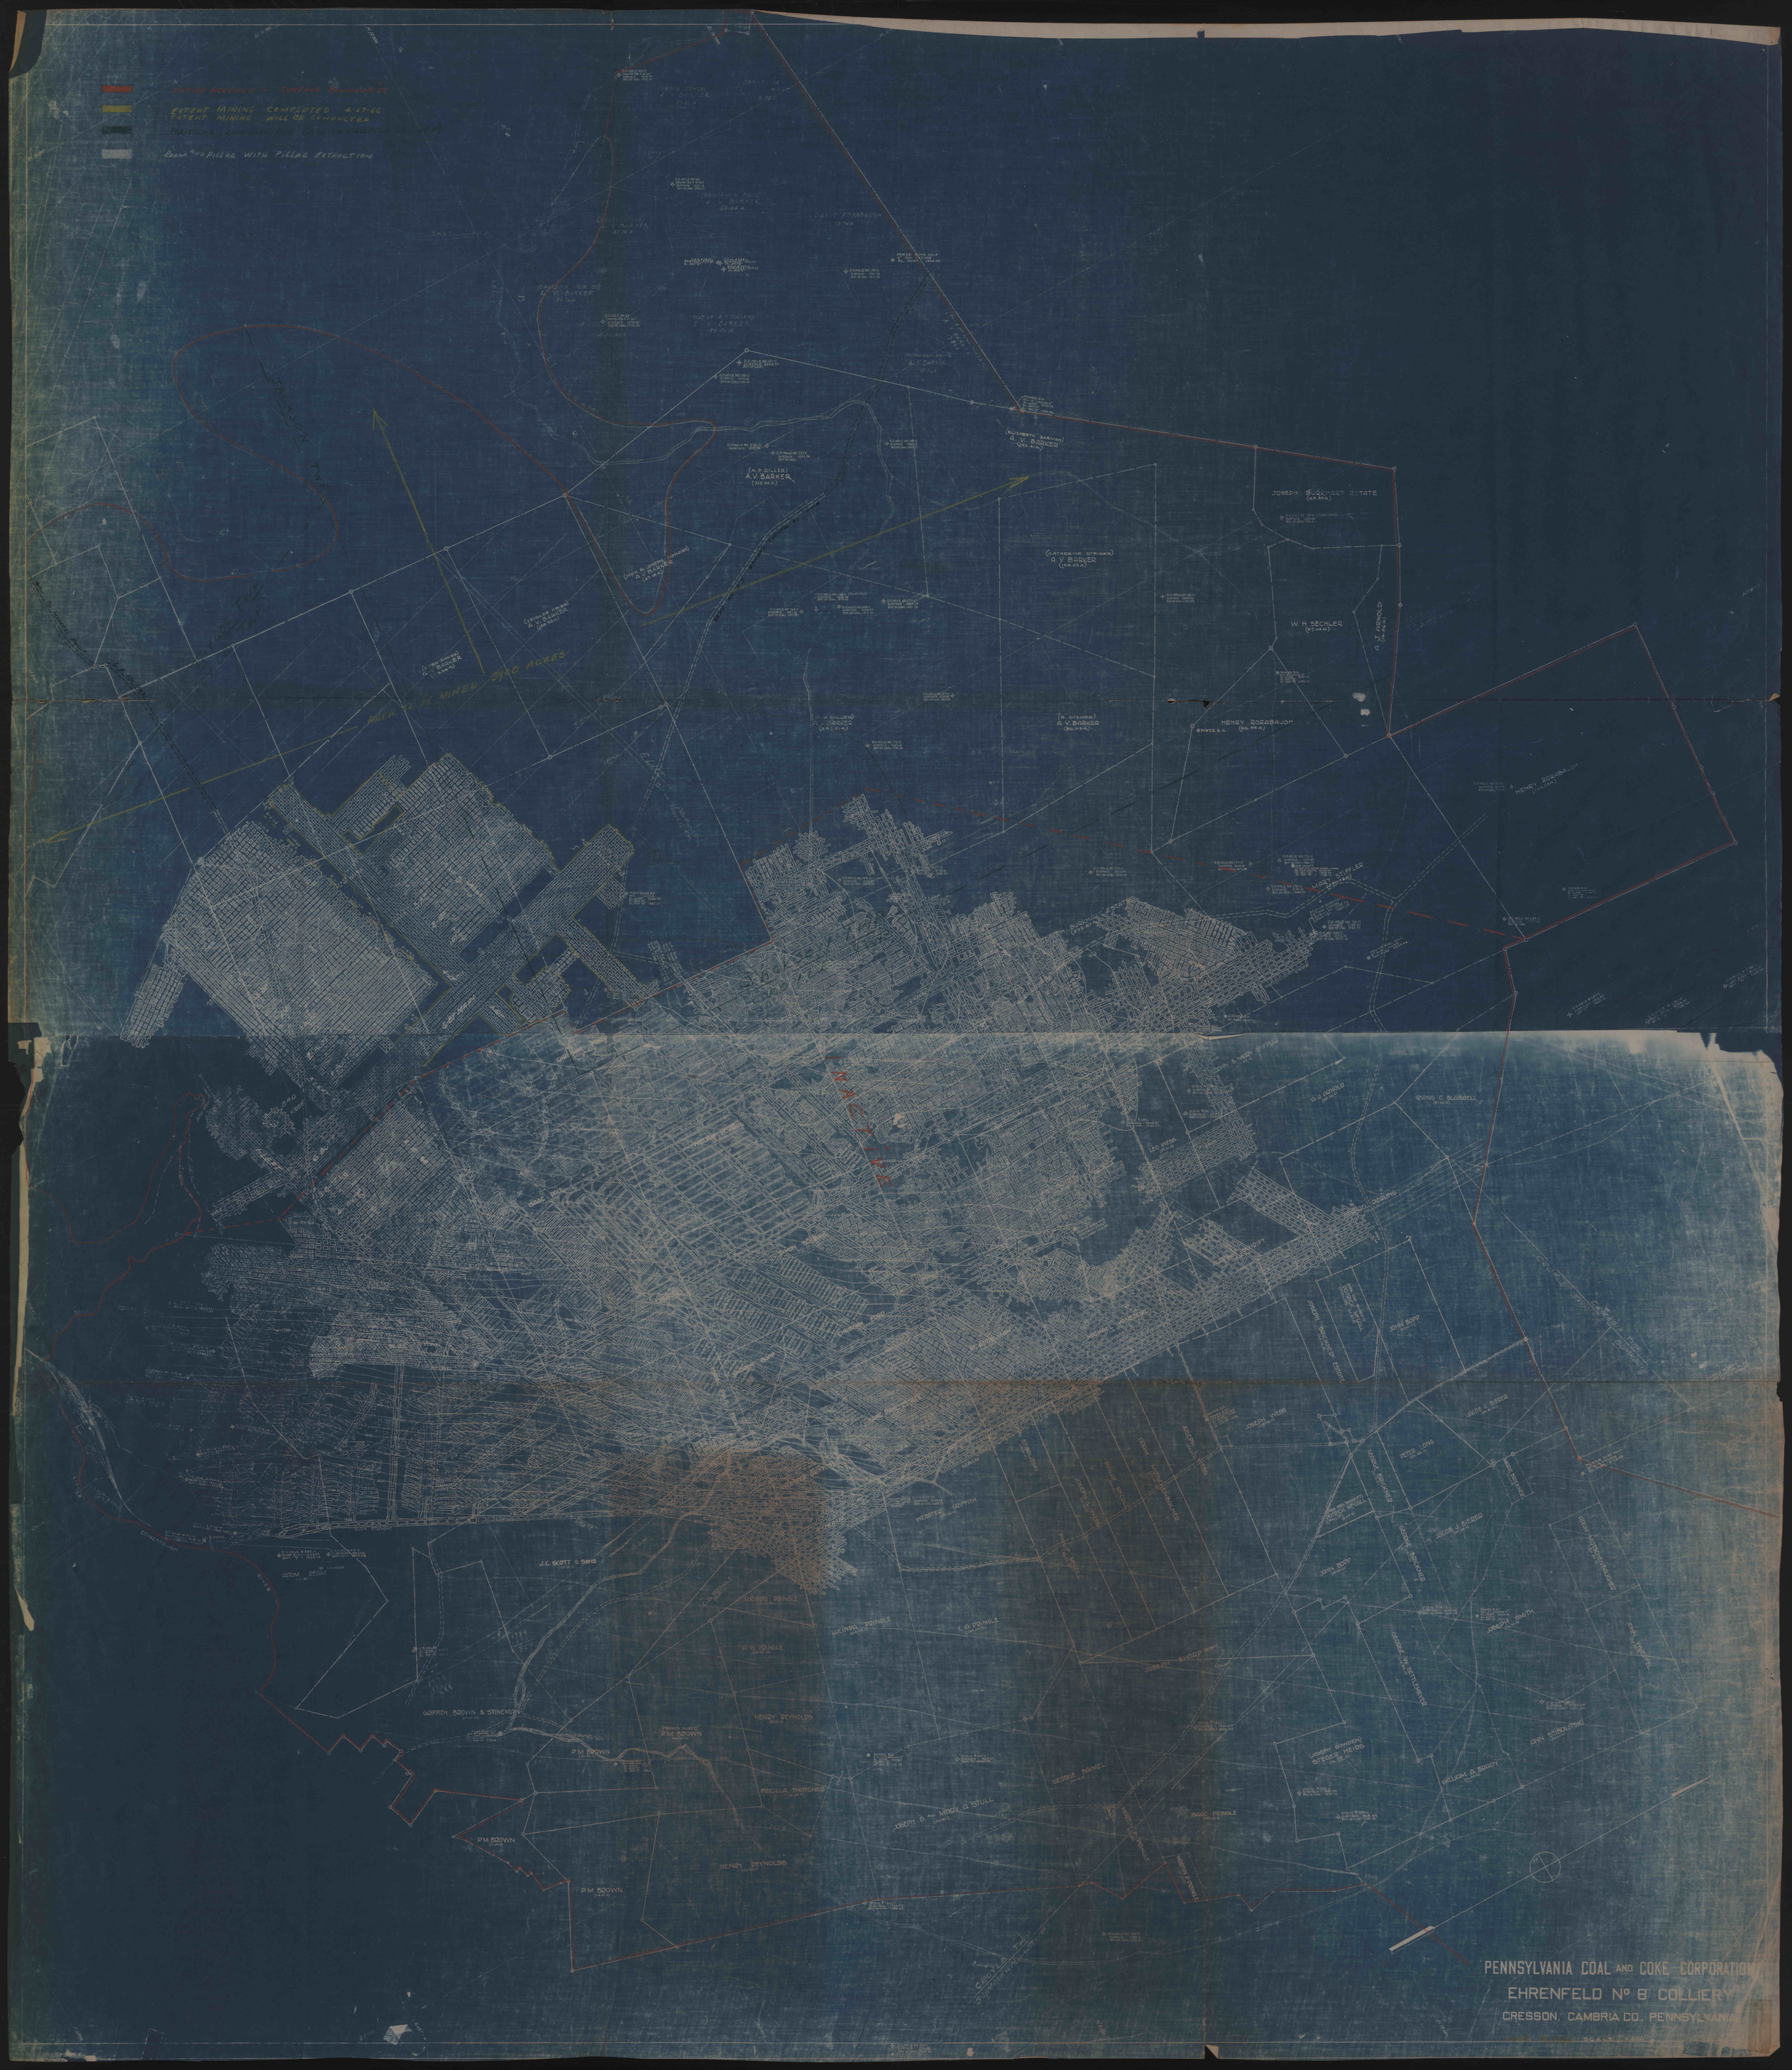
EXTENT MINING COMPLETED 4-27-66
EXTENT MINING WILL BE CONDUCTED
ROOM AND PILLAR WITH PILLAR EXTRACTION
A.V. BARKER
HENRY RORABAUGH
W. H. SECHLER
A. J. ARNOLD
IRVING C. BLAISDELL
J.C. SCOTT & SONS
GRIFFITH, BROWN & STINEMAN
P.M. BROWN
HENRY REYNOLDS
PRICILLA THATCHER
LUCINDA PRINGLE
C.A. PRINGLE
R.W. PRINGLE
JOSEPH SHEARP
GEORGE BOWMEL
JOSEPH & MARY A STULL
PETER LONG
JOHN BOPP
JOSEPH SMITH
WILLIAM A. BRADY
GEORGE W. SETTLEMYER
PENNSYLVANIA COAL AND COKE CORPORATION
EHRENFELD Nº 8 COLLIERY
CRESSON, CAMBRIA CO., PENNSYLVANIA