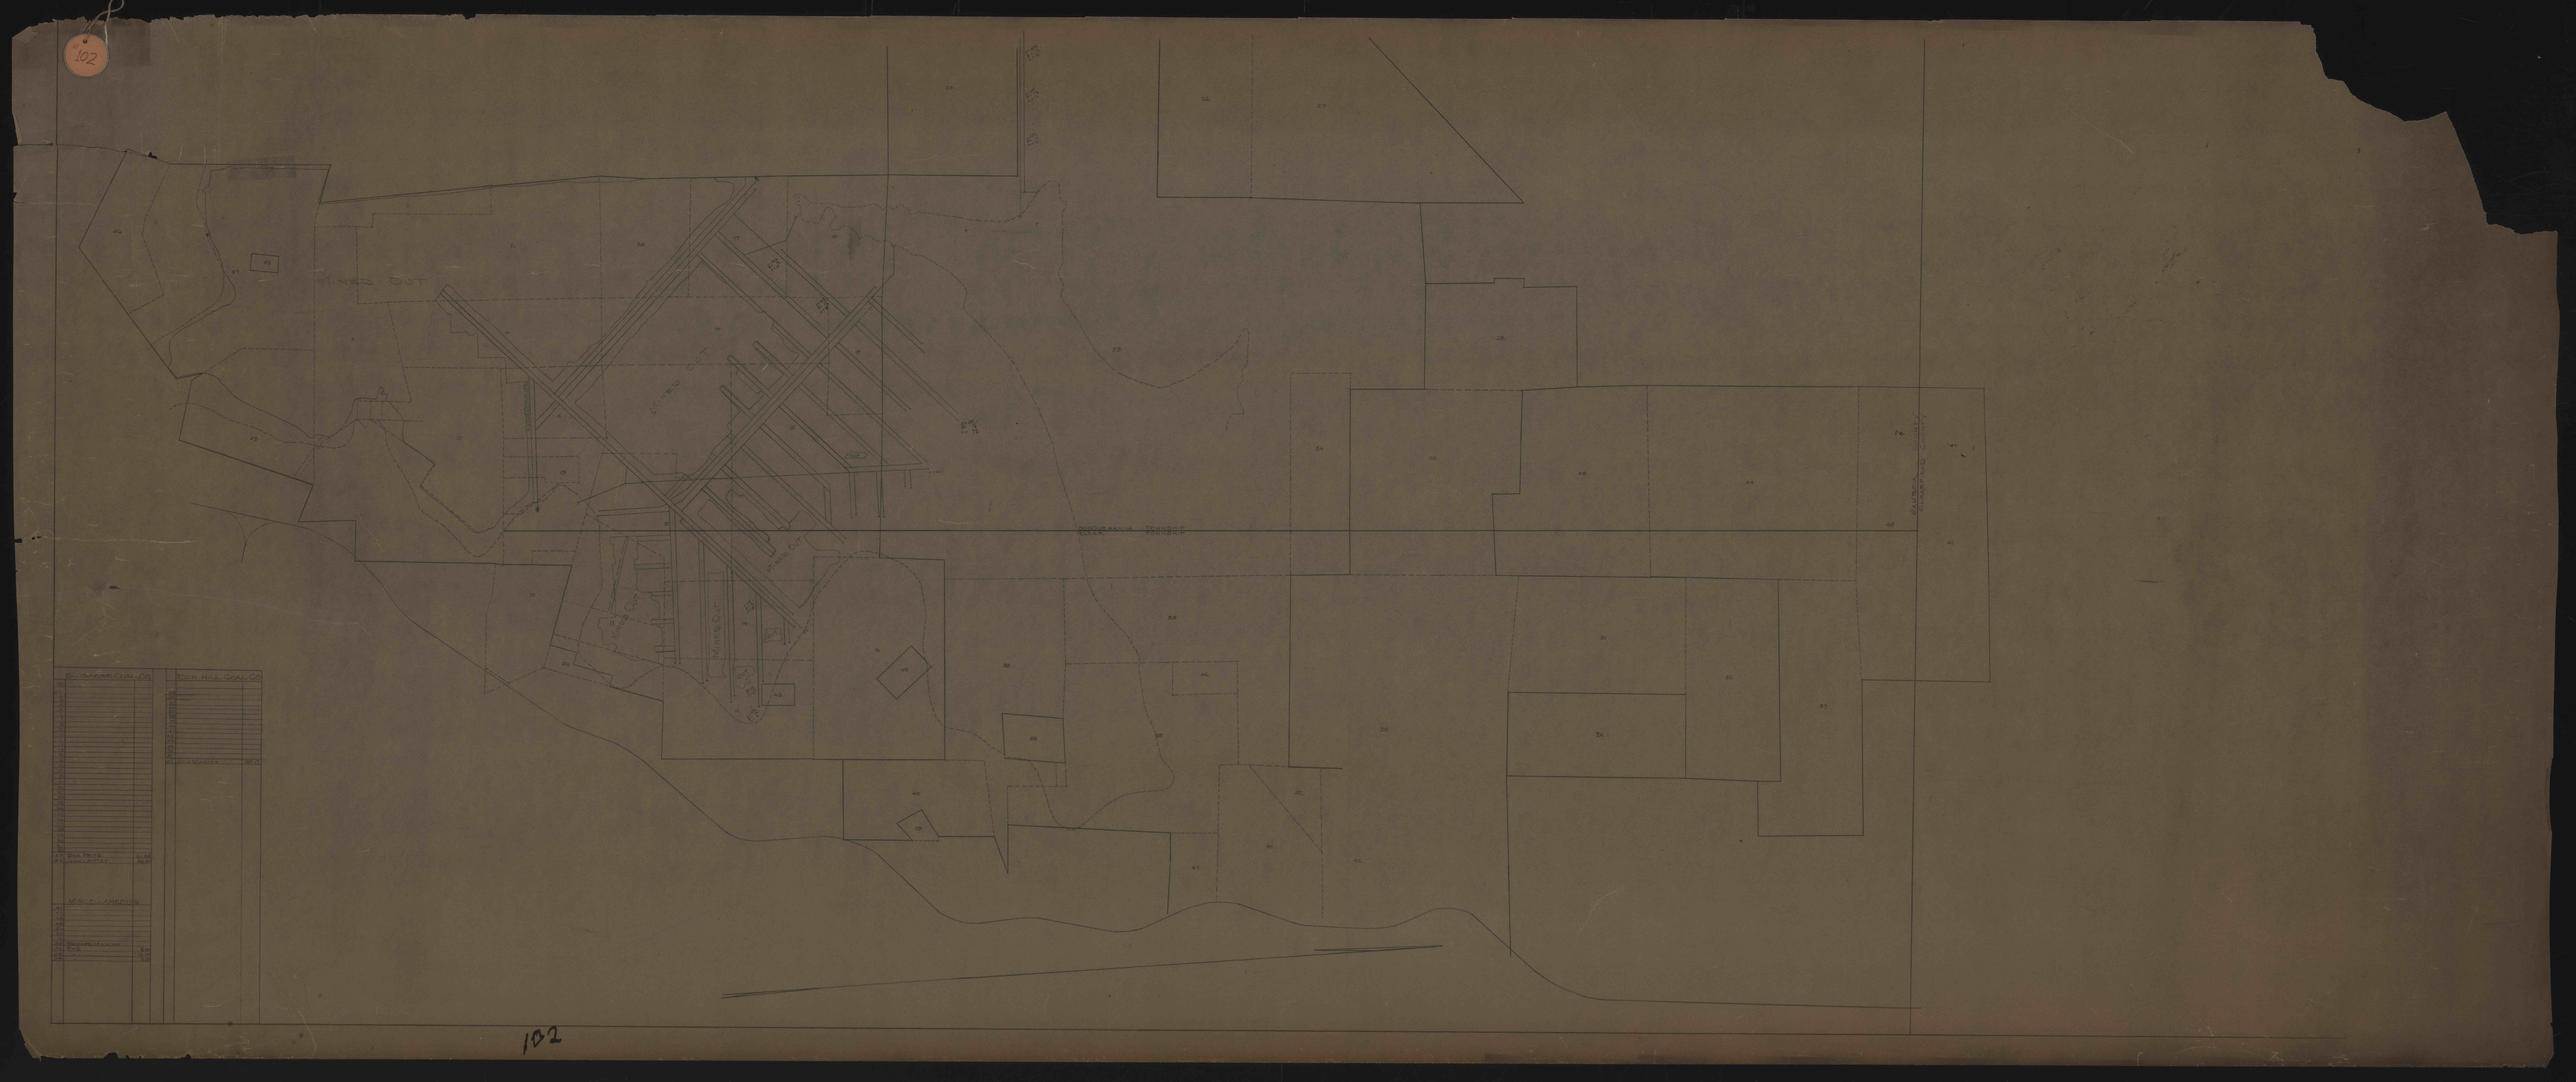
102
ROCK HILL GOAL CO
102