


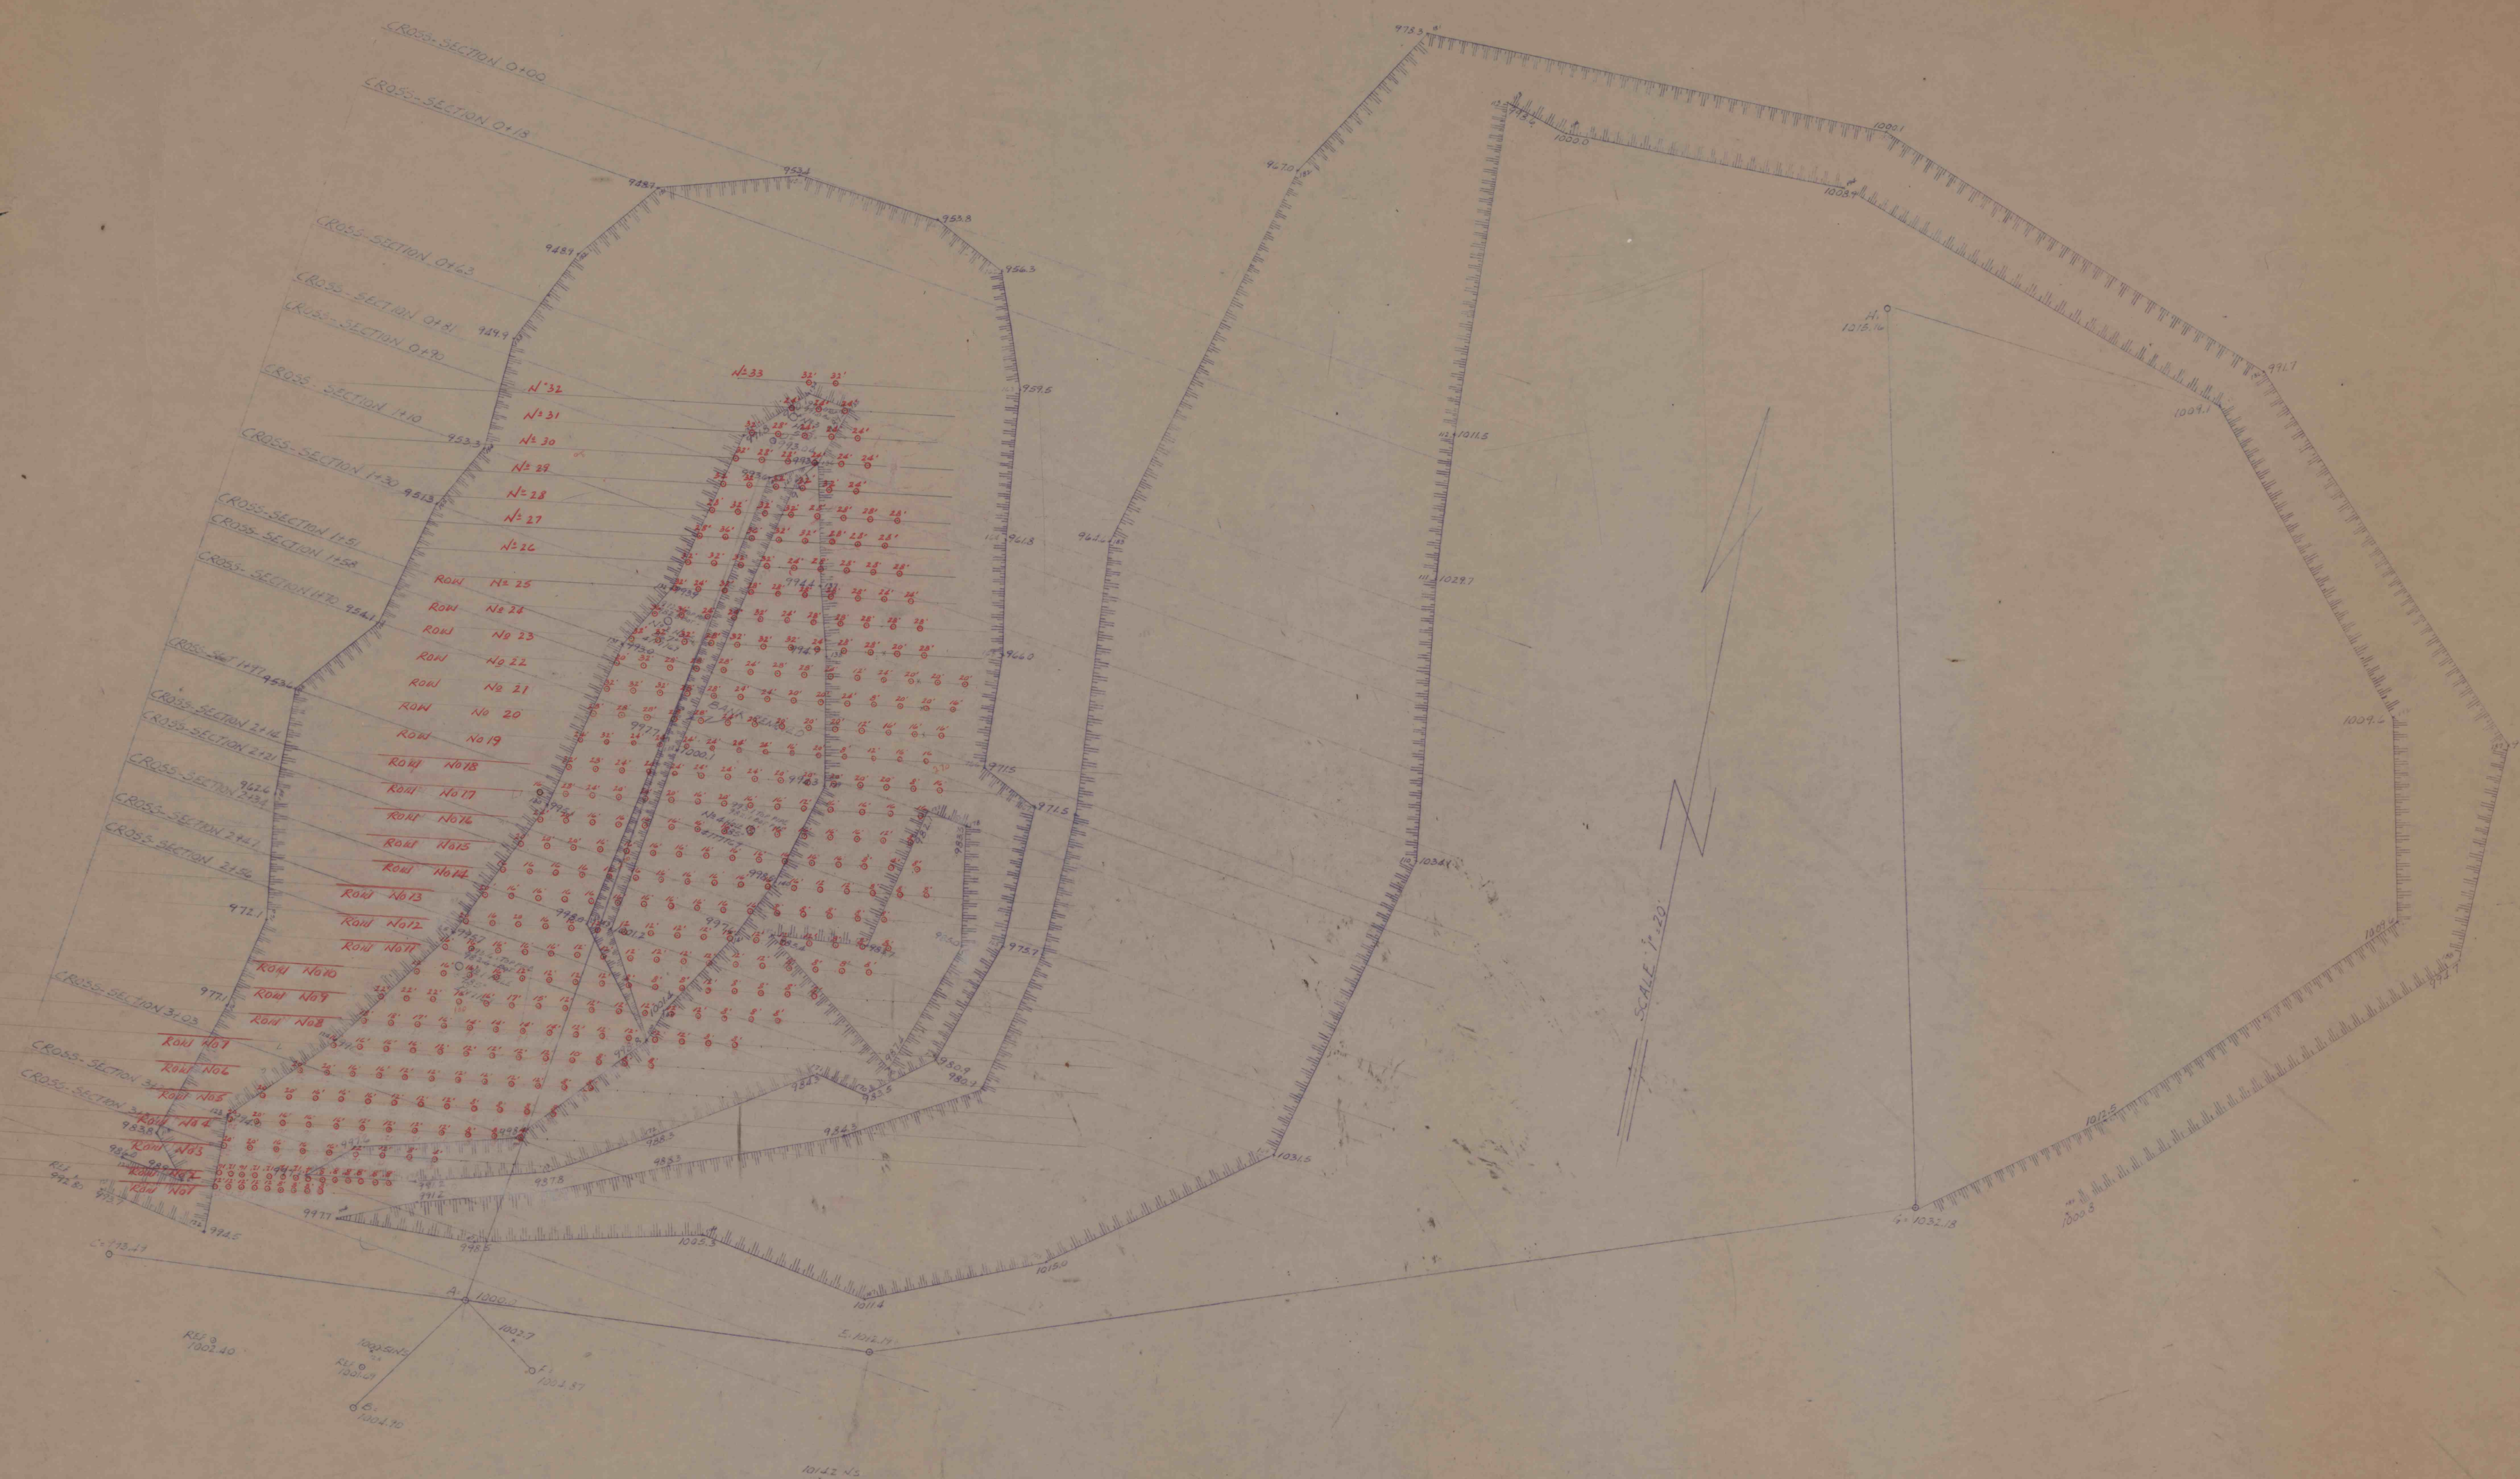

FALLS SLOPE BURNING REFUSE BANK SCALE 1"=20'

Notes: 1. 3.36 Tons Lint. used to build 20, 1967

Notes: 2. 70 Holes provided to build 20, 1967

JUN 9 1972