
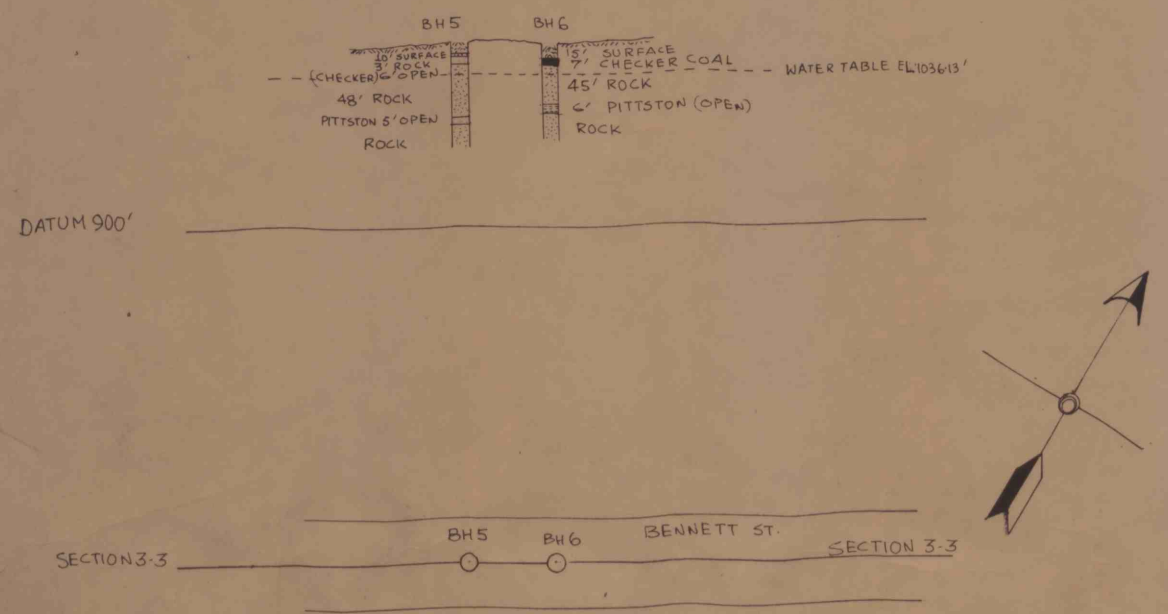
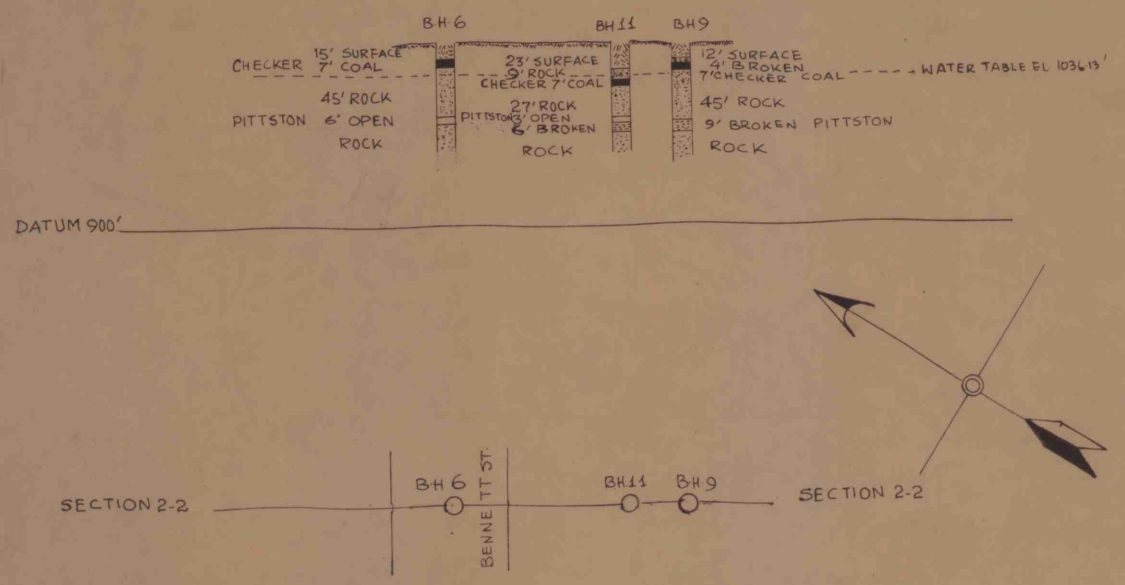
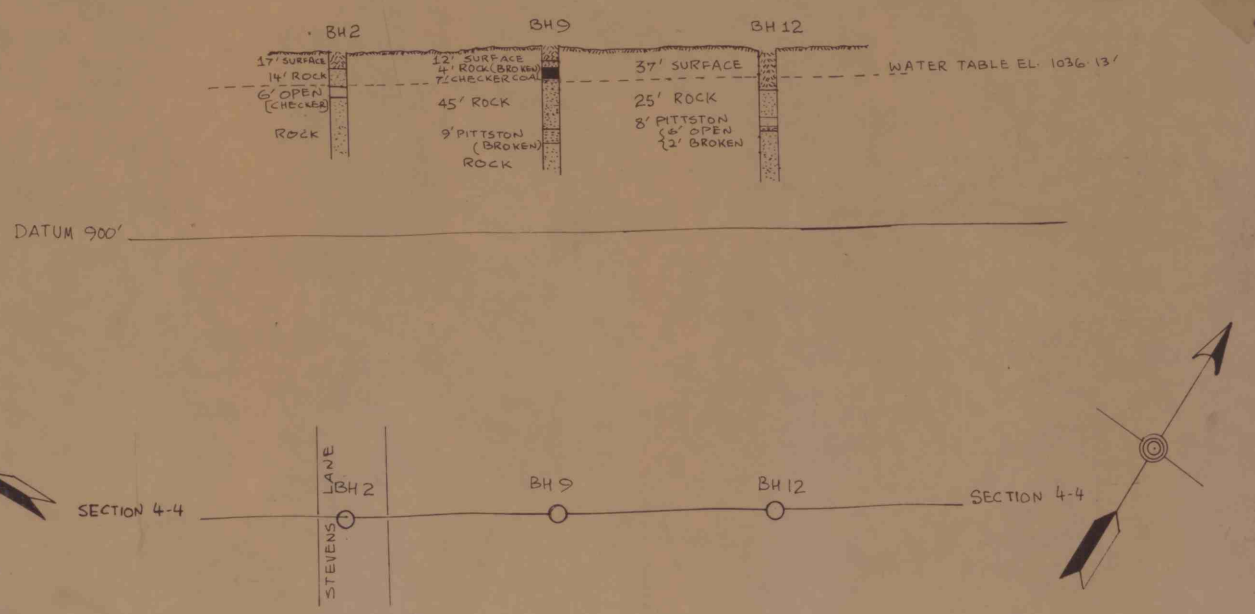


Exploratory Drilling
 Luzerne County
 Exeter Borough
 Surface
 1"=100'
 4 maps
 (3968)

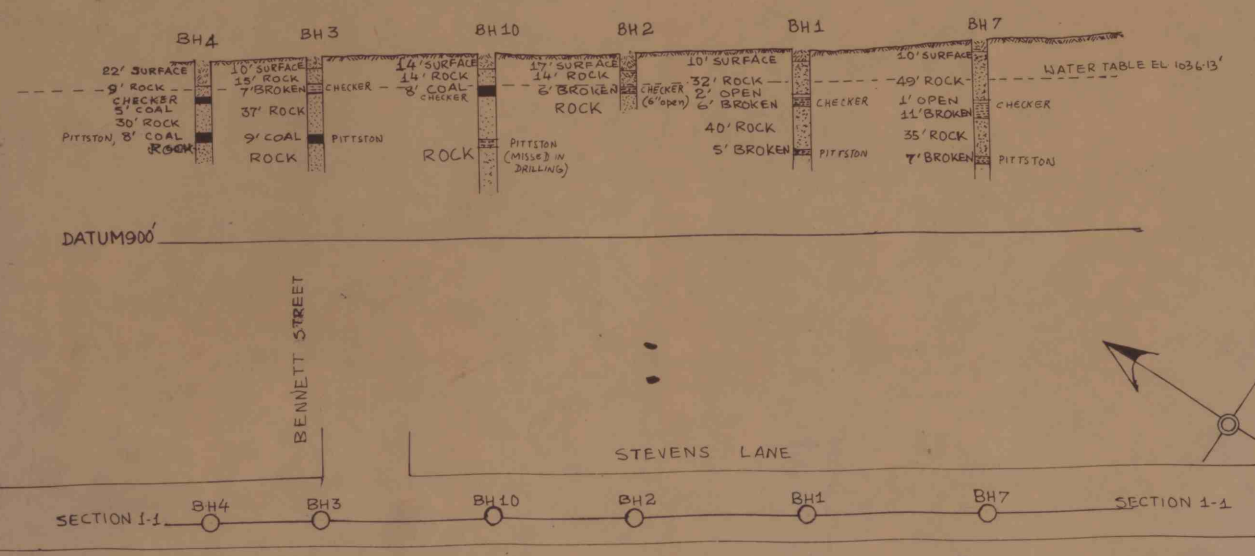

EXPLORATORY DRILLING
 PROJECT NO. SL 442-A
 EXETER BOROUGH, LUZERNE COUNTY, PA.

LEGEND

- SURFACE
- ROCK
- BROKEN ROCK
- COAL
- OPEN

SCALE 1"=100'

2001T-02 22000 A 442-A 9/10/02 Exploratory Drilling