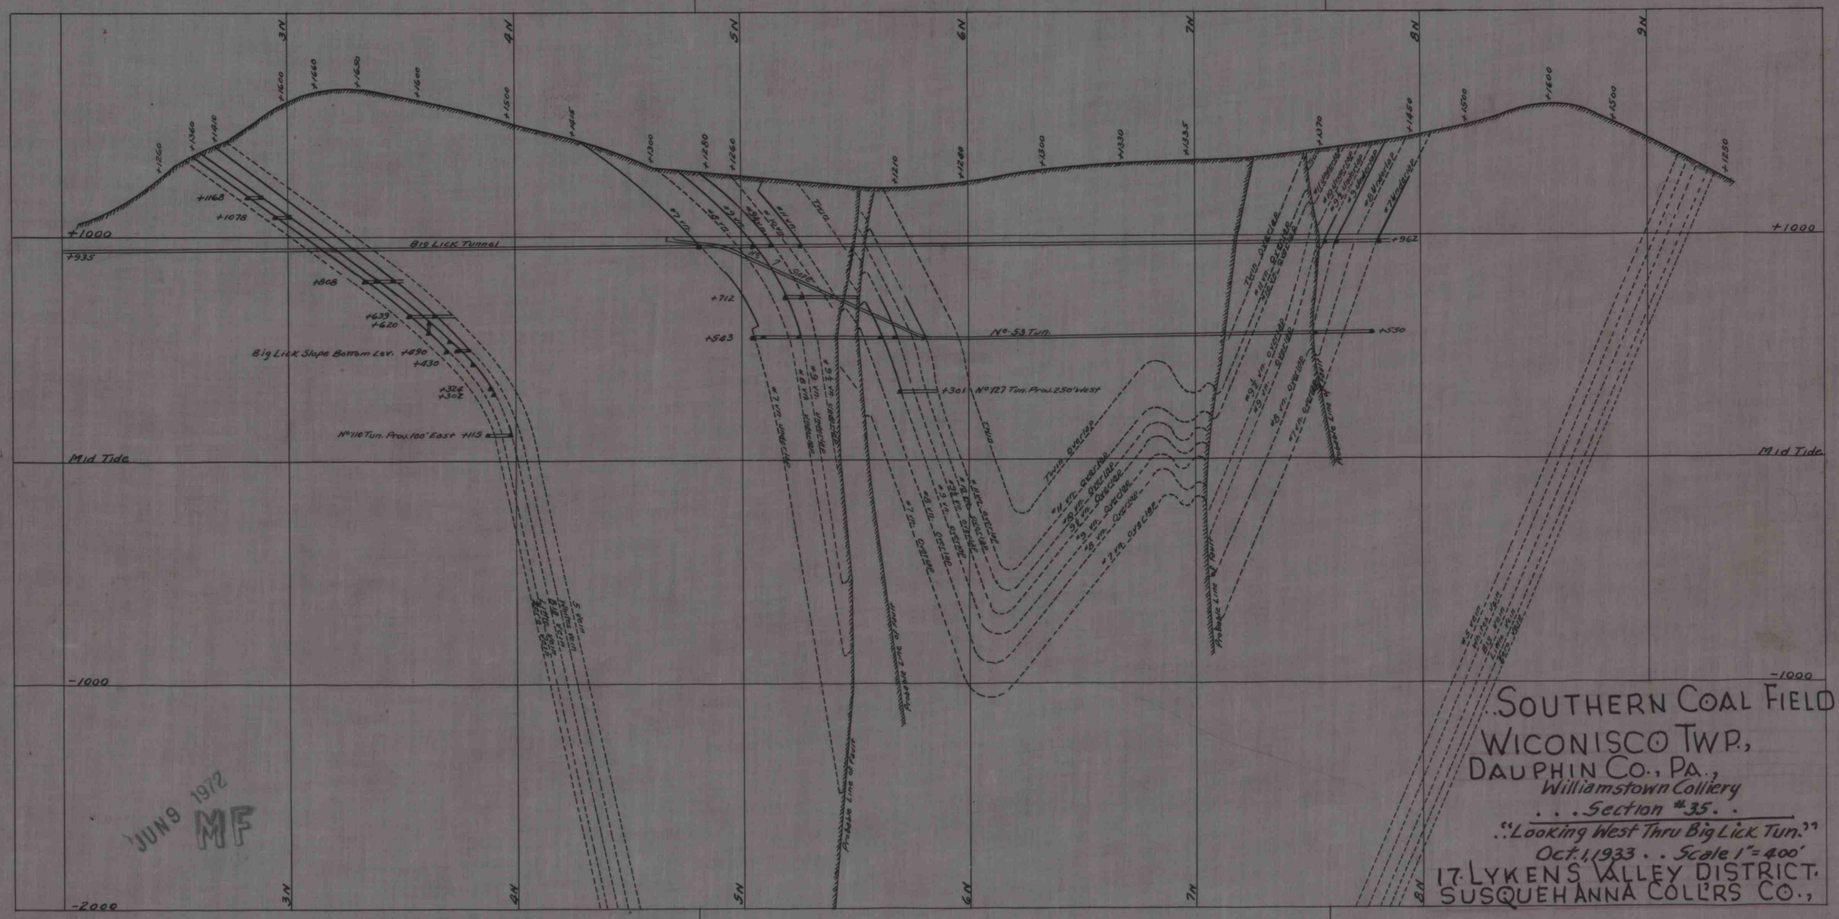

SOUTHERN COAL FIELD..
WICONISCO TWP.,
DAUPHIN CO., PA.,
Williamstown Colliery
. . . Section #35. .
"Looking West Thru Big Lick Tun."
Oct. 1, 1933 . . Scale 1" = 400'
17. LYKENS VALLEY DISTRICT.
SUSQUEHANNA COL'RS CO.,

JUN 9 1972
MF