


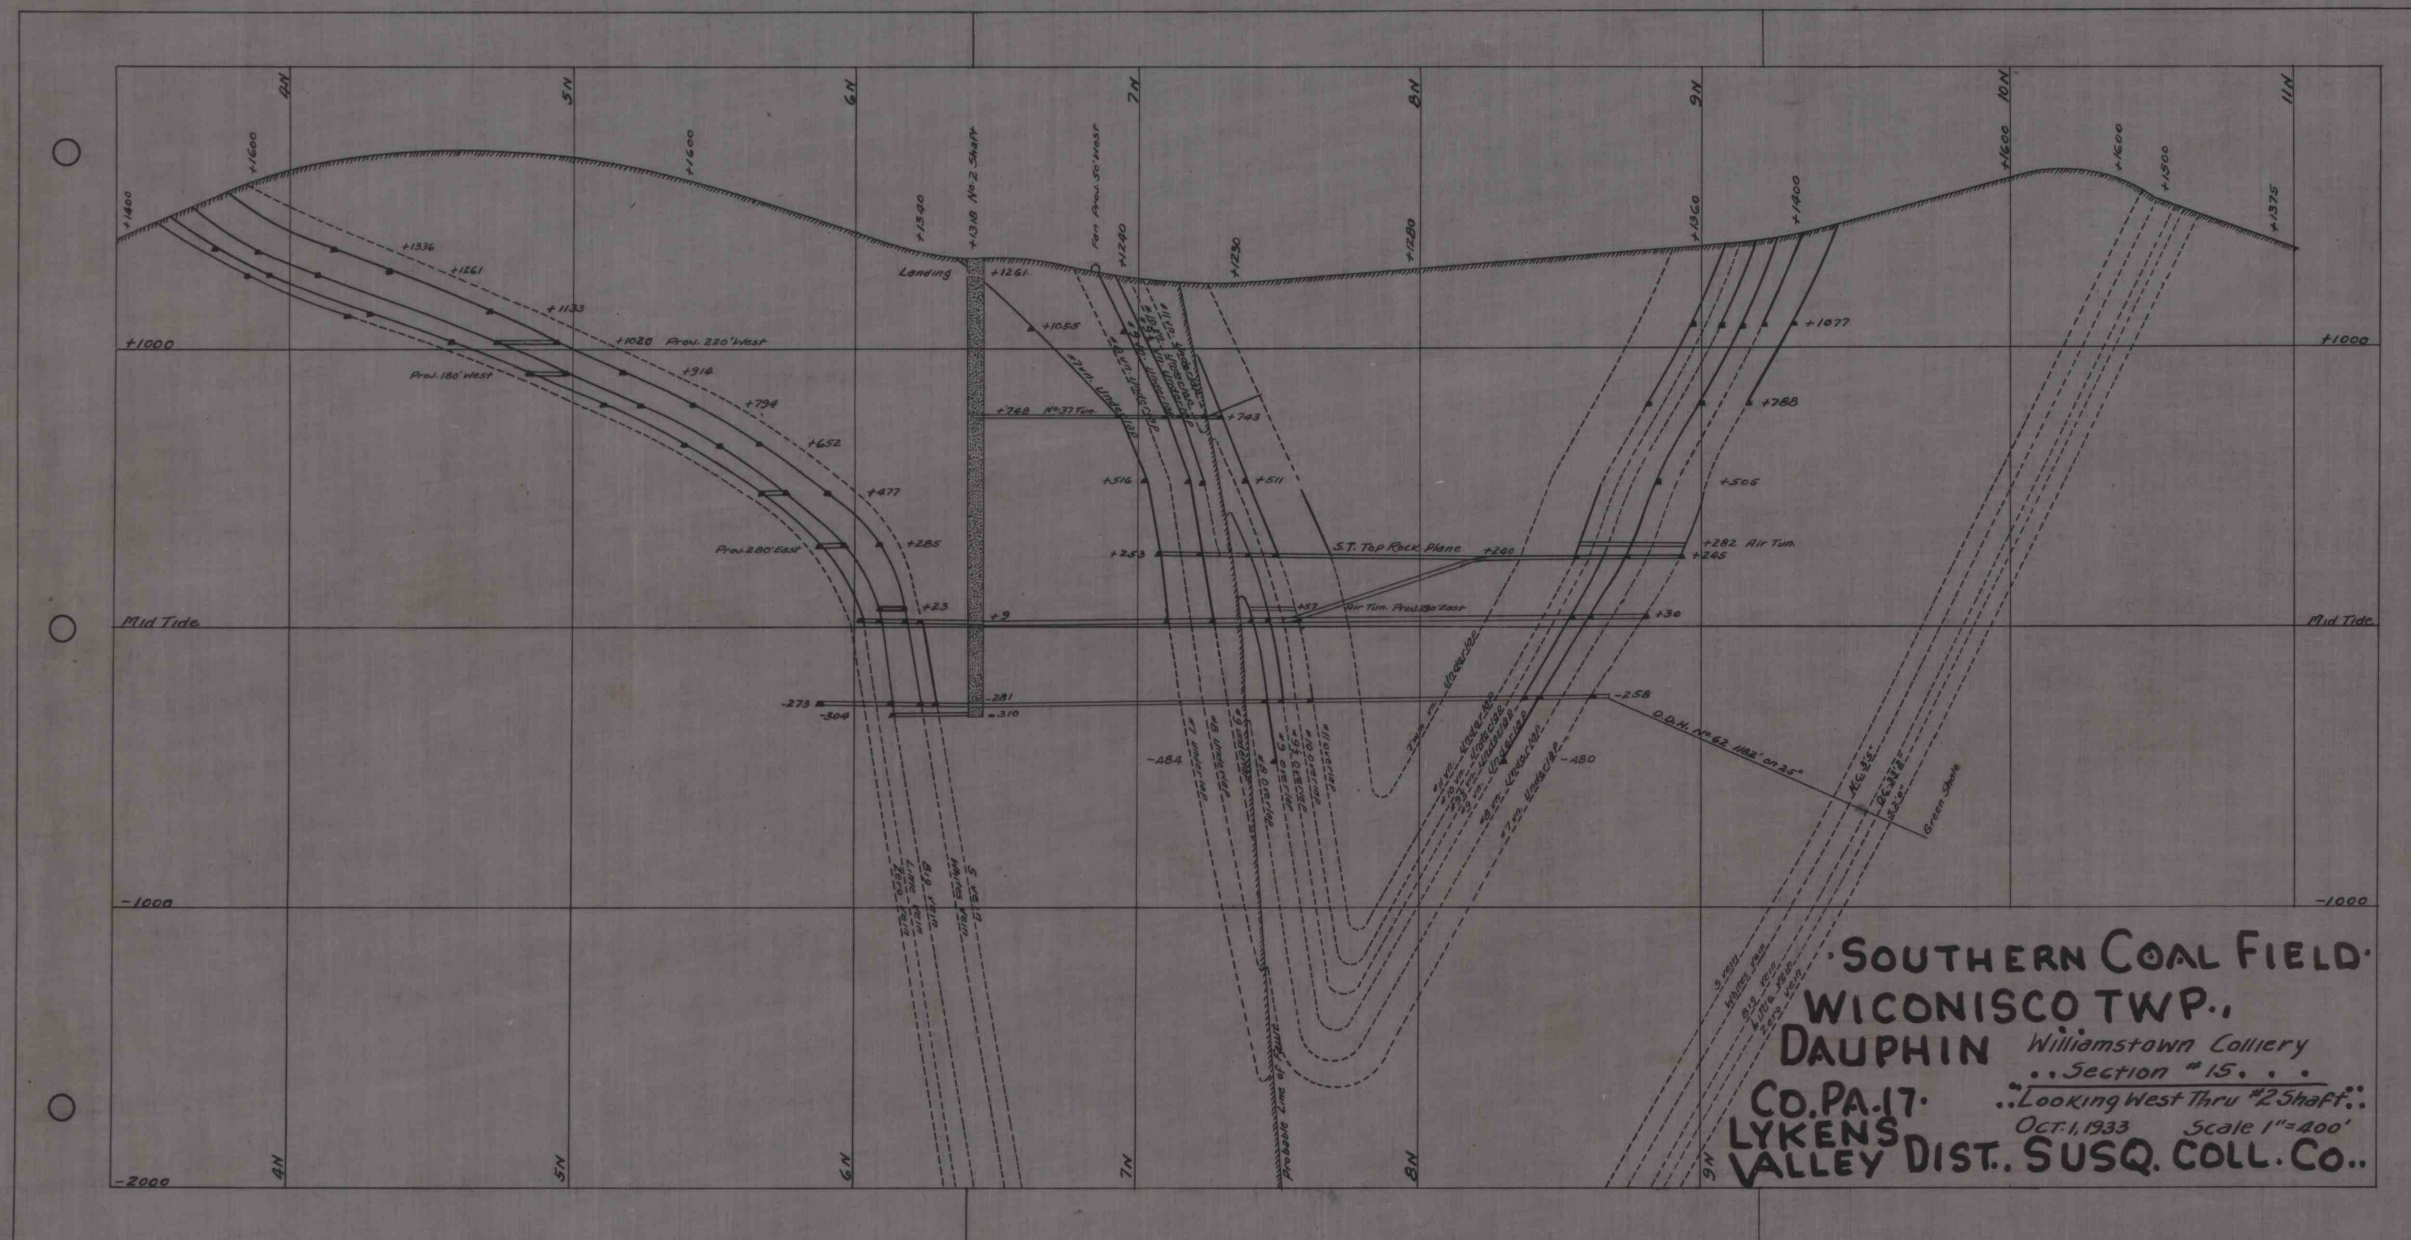

JUN 9 1972

FW

JUN 9 1972