


SOUTHERN FIELD MAP OF THE WILLIAMSTOWN Colliery.

S. B. & L. V. C. Co's MINE WORKINGS
IN THE

UPPER OR WHITE ASH SEAMS
WILLIAMS TWP. DAUPHIN COUNTY, PA.
Showing area worked in the different tracts.

LYKENS PA. Scale 1250' = 1 inch DEC. 3, 1900
VALLEY. SUSQUEHANNA COLLIERIES..

Reference
SKIDMORE VEIN { Color, Burnt Sienna
 { Section Lines N.W. & S.E.
#9 VEIN { Color Carmine
 { Section Lines N.E. & S.W.
PRIMROSE { Color Green
 { Section Lines N. and S.

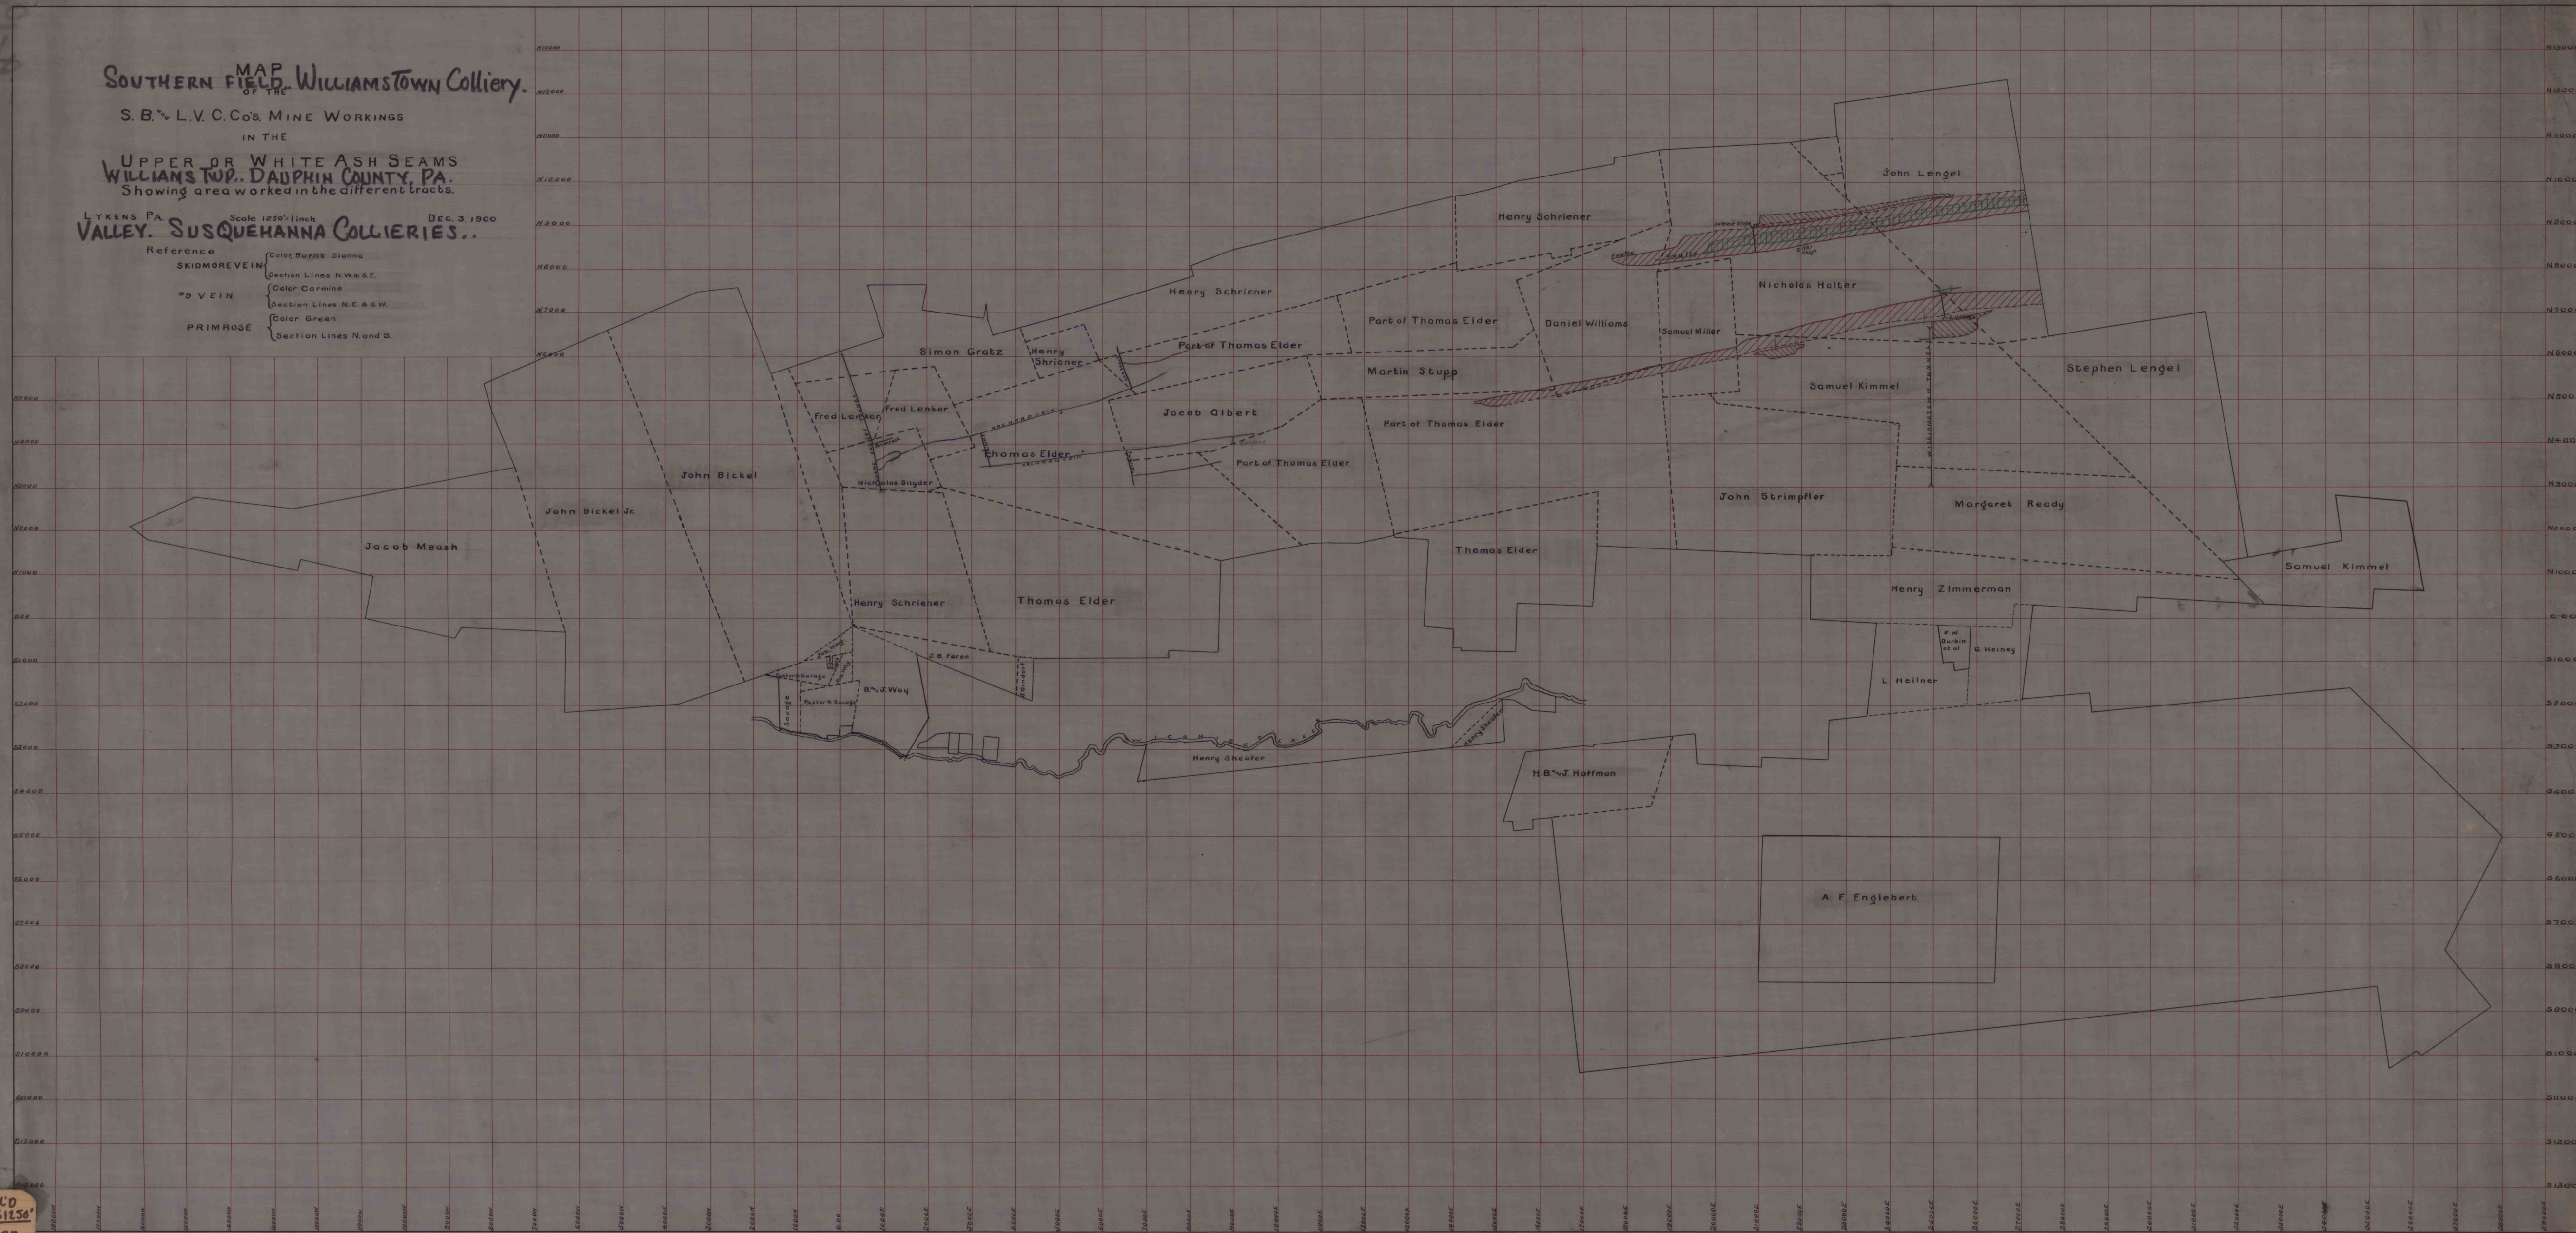

SOUTHERN FIELD MAP OF THE WILLIAMSTOWN Colliery. UPPER OR WHITE ASH SEAMS. WILLIAMS TWP. DAUPHIN CO. PA. S. B. & L. V. C. Co. DEC. 3, 1900. MAR 10 1972 MF MF

MAR 10 1972 MF MF