


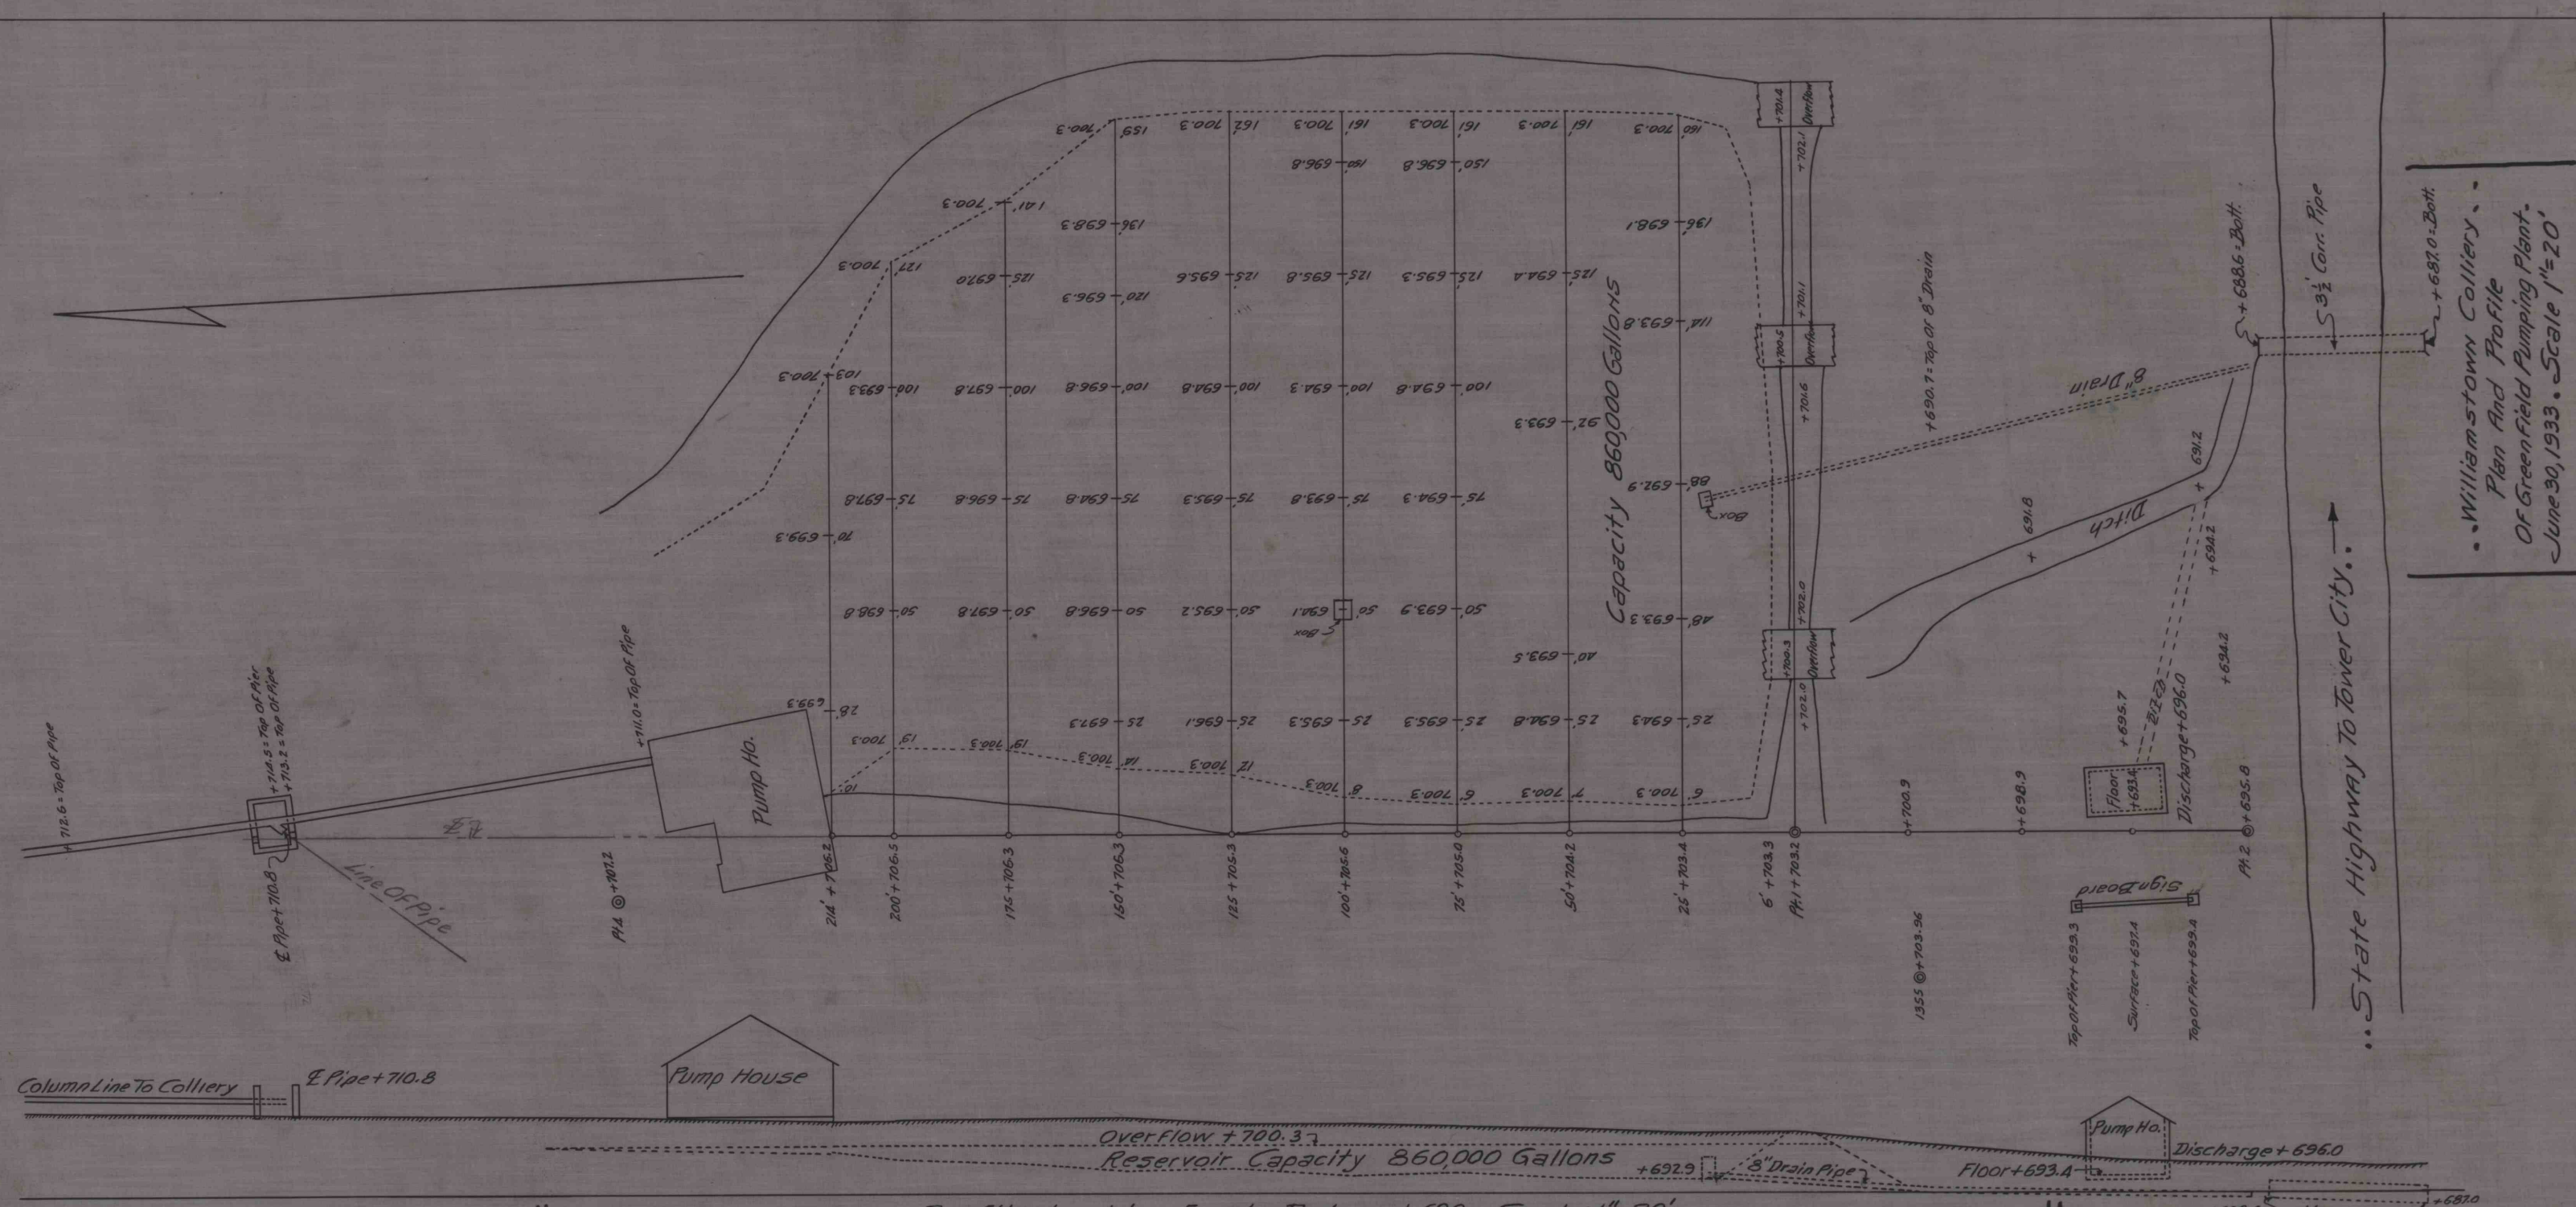

Southern Coal Field. Wiconisco Twp., DAUPHIN County PA.,
17 LYKENS VALLEY DISTRICT. SUSQUEHANNA COLLIERIES.

6 OF 8

Short Mtn. Colliery
Susquehanna Collieries Co
Dauphin County
Wiconisco Township
Surface
Southern Coal Field
1"=400'
February 25, 1909
8 maps