


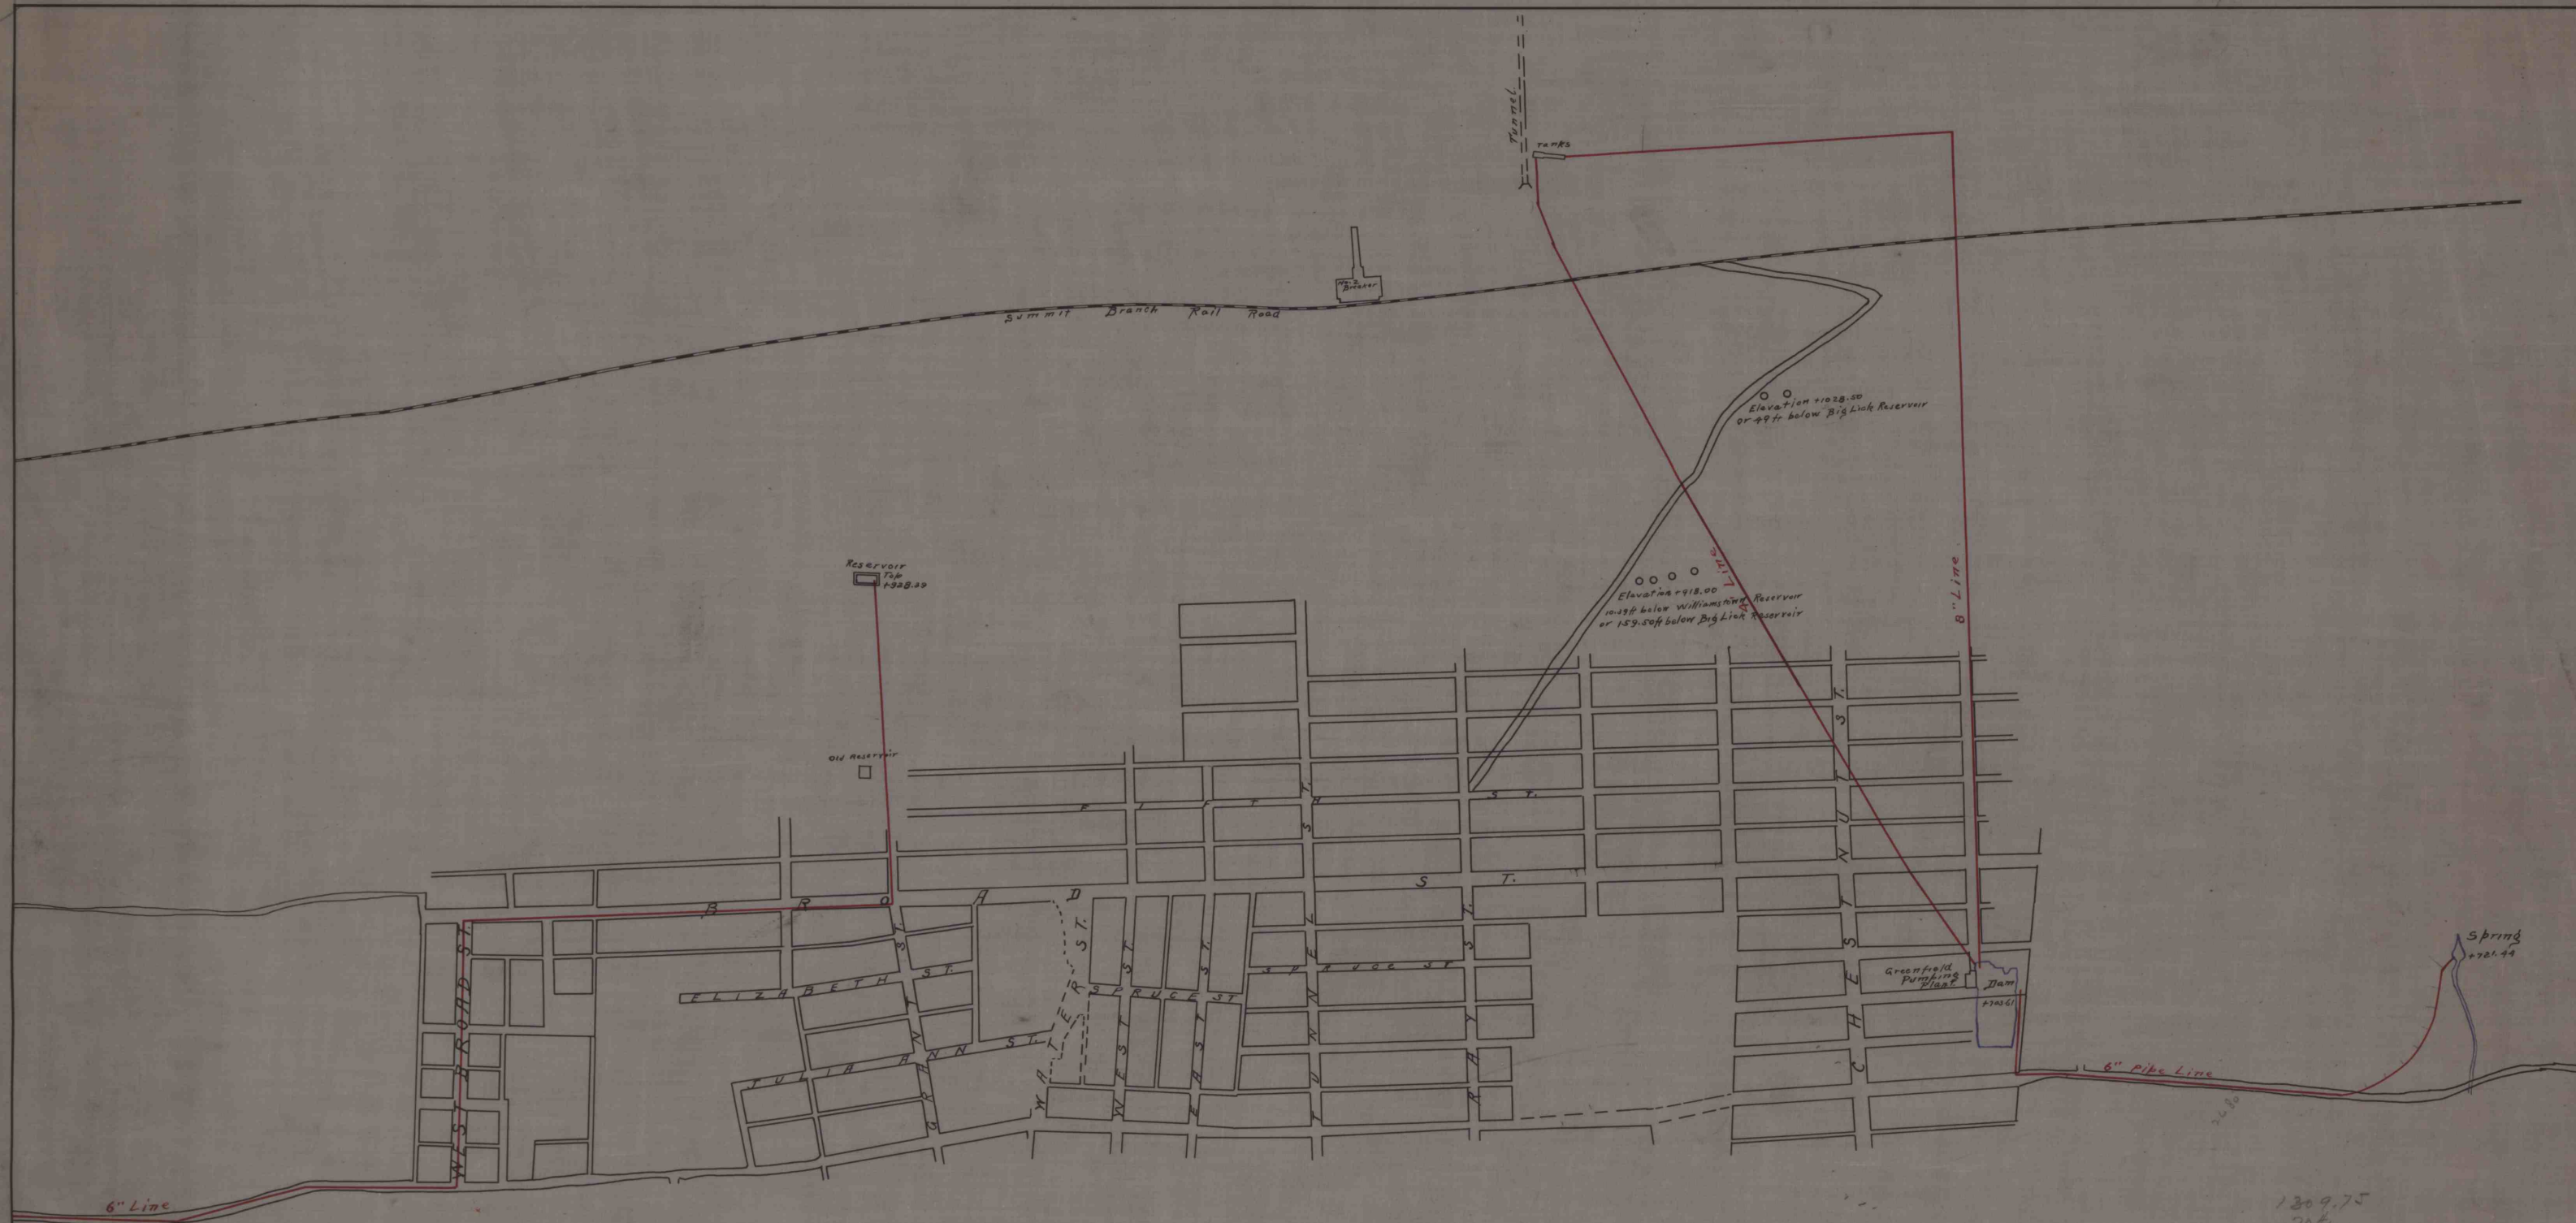

1209.75
 706.
 605.

Southern Field: Wm'stown Colliery..
 Wiconisco Twp., Dauphin County.
 17 Lykens Valley District...2-of-4..

LOCATION
 OF
 WATER LINES."
 WILLIAMSTOWN PA
 Lykens, Pa., .. Feb. 19-'06.
 . . . Scale: 400' = 1"