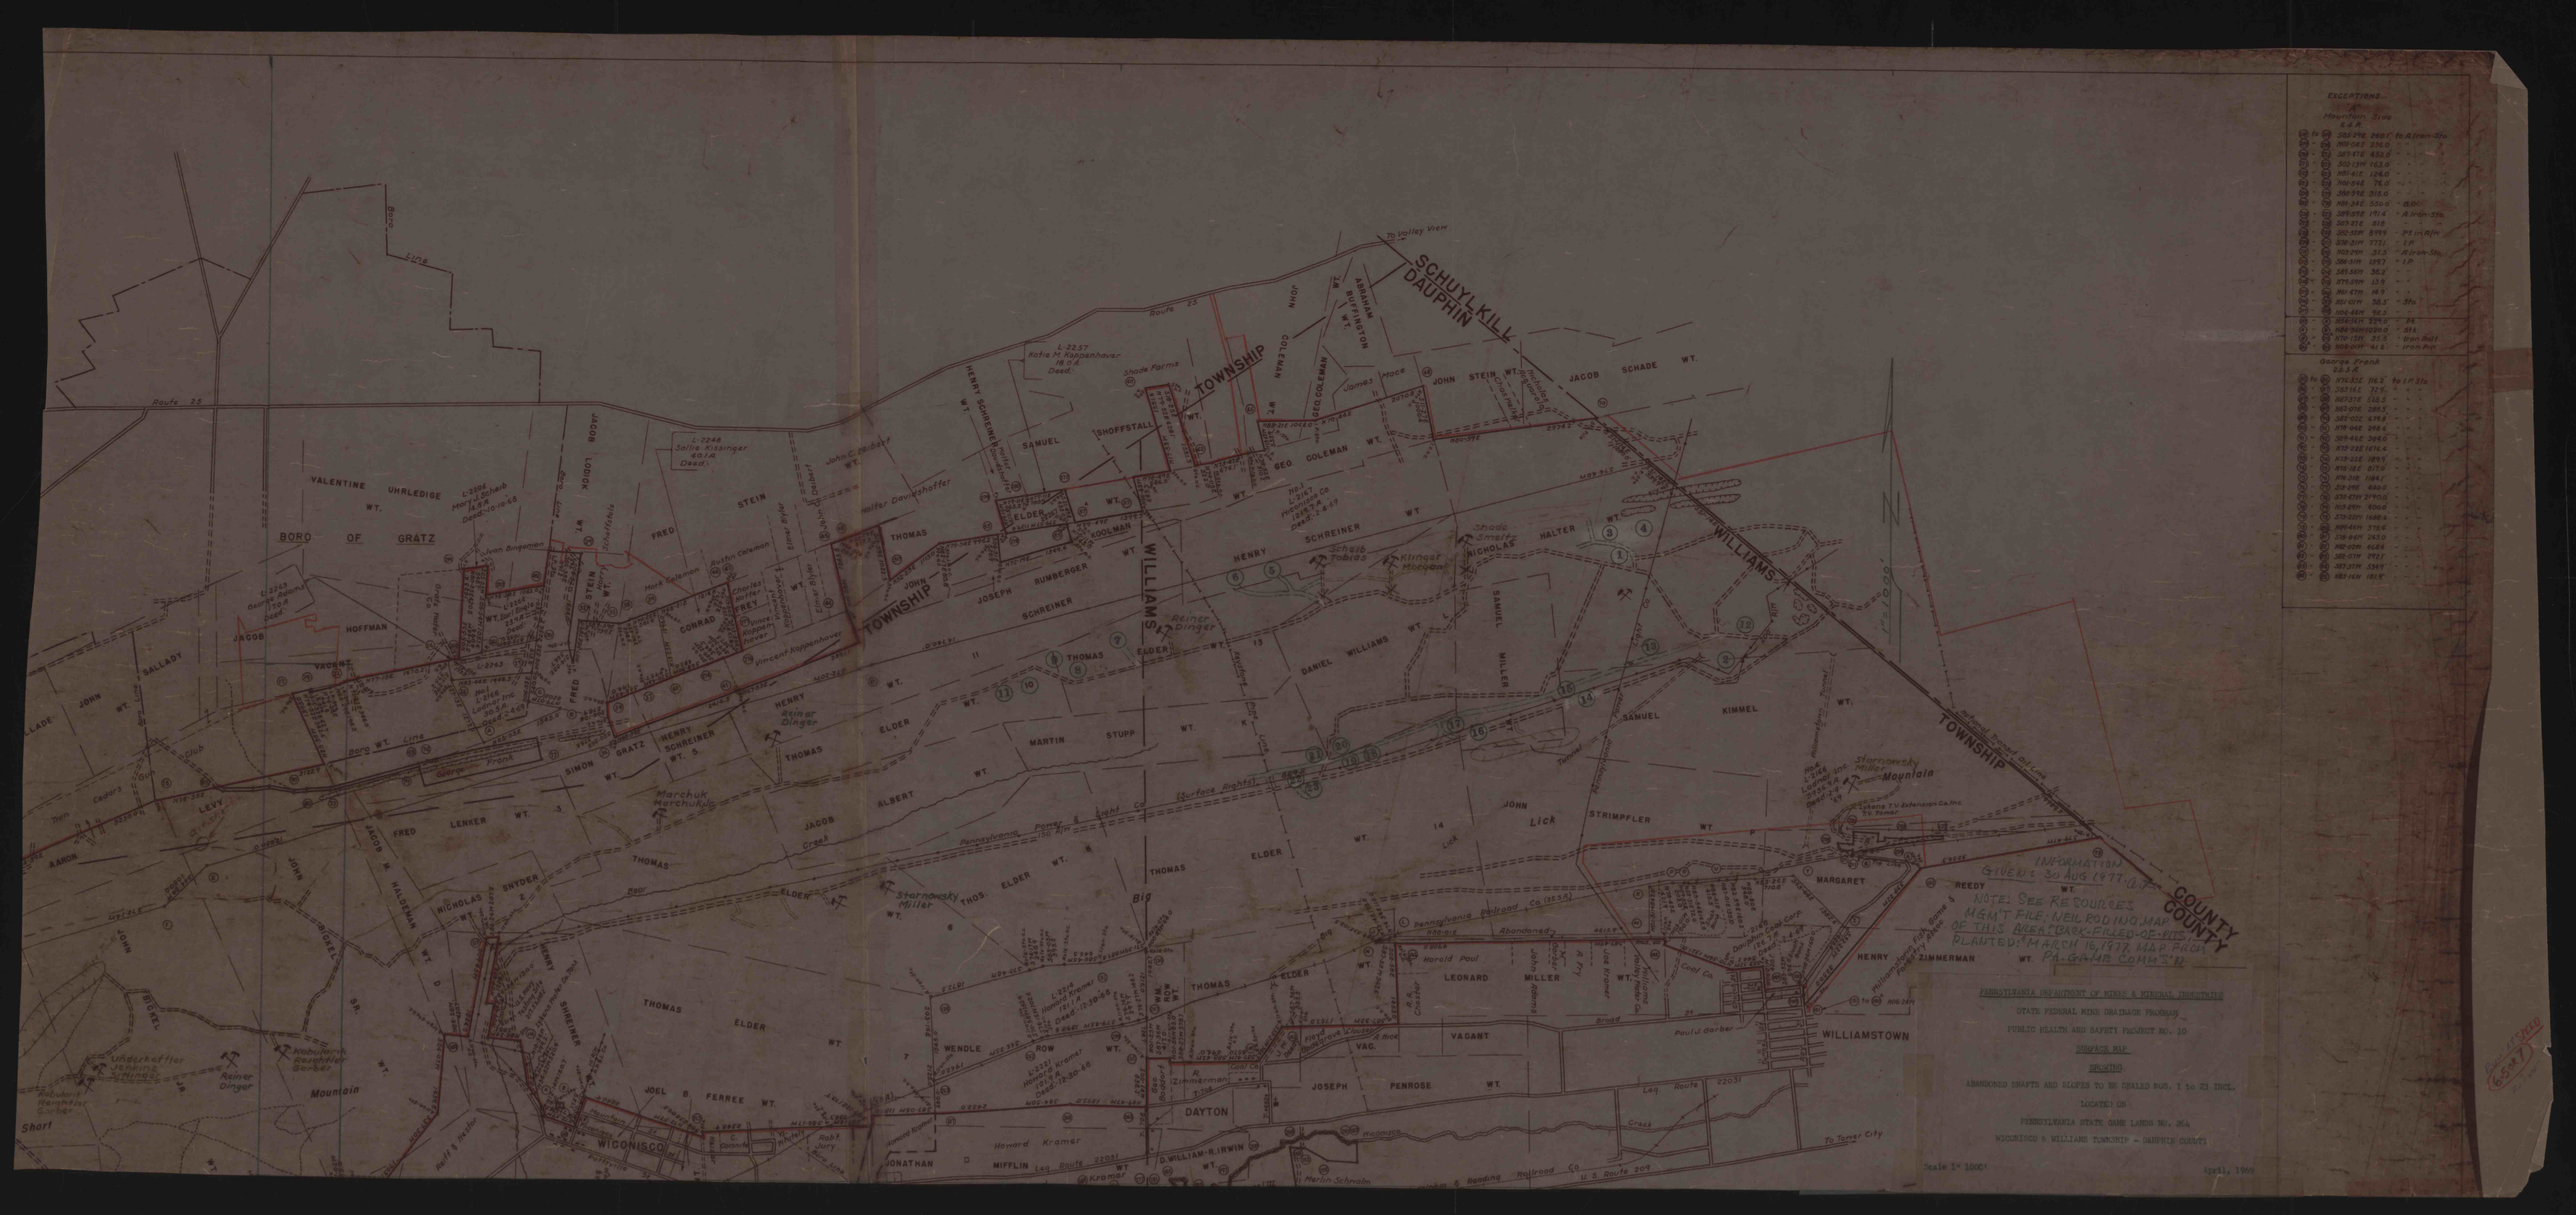
EXCEPTIONS
George Frank
SCHUYLKILL
DAUPHIN
COUNTY
WILLIAMS
TOWNSHIP
BORO OF GRATZ
WIGONISCO
DAYTON
WILLIAMSTOWN
Route 25
Route 209
Route 2203
Pennsylvania Power & Light Co (Surface Rights)
Pennsylvania Railroad Co (1858)
Abandoned
Big Mountain
Short Mountain
Starnowsky Miller Mountain
Marchuk Marchukoic
Reiner Dinger
Klinger Mosheim
Schase Tobias
Shade Smith Nicholas
Harold Paul
Paul J Garber
Howard Kramer
Merlin Schnoln
U. S. Route 209
To Tamer City
To Valley View
INFORMATION GIVEN: 30 AUG 1977 (B.P.)
NOTE: SEE RESOURCES MGMT FILE; NEIL POLINO MAP OF THIS AREA FOUND-FILED-OF-INTO PLANTED: MARCH 16, 1977 MAP FROM PA-GAME COMM'N
PENNSYLVANIA DEPARTMENT OF MINES & MINERAL INDUSTRIES
STATE FEDERAL MINE DRAINAGE PROGRAM
PUBLIC HEALTH AND SAFETY PROJECT NO. 10
SURFACE MAP
SHOWING
ABANDONED SHAFTS AND SLOPES TO BE SEALED NOS. 1 to 23 INCL.
LOCATED ON
PENNSYLVANIA STATE GAME LANDS No. 264
WIGONISCO & WILLIAMS TOWNSHIP - DAUPHIN COUNTY
Scale 1" 1000'
April, 1969