







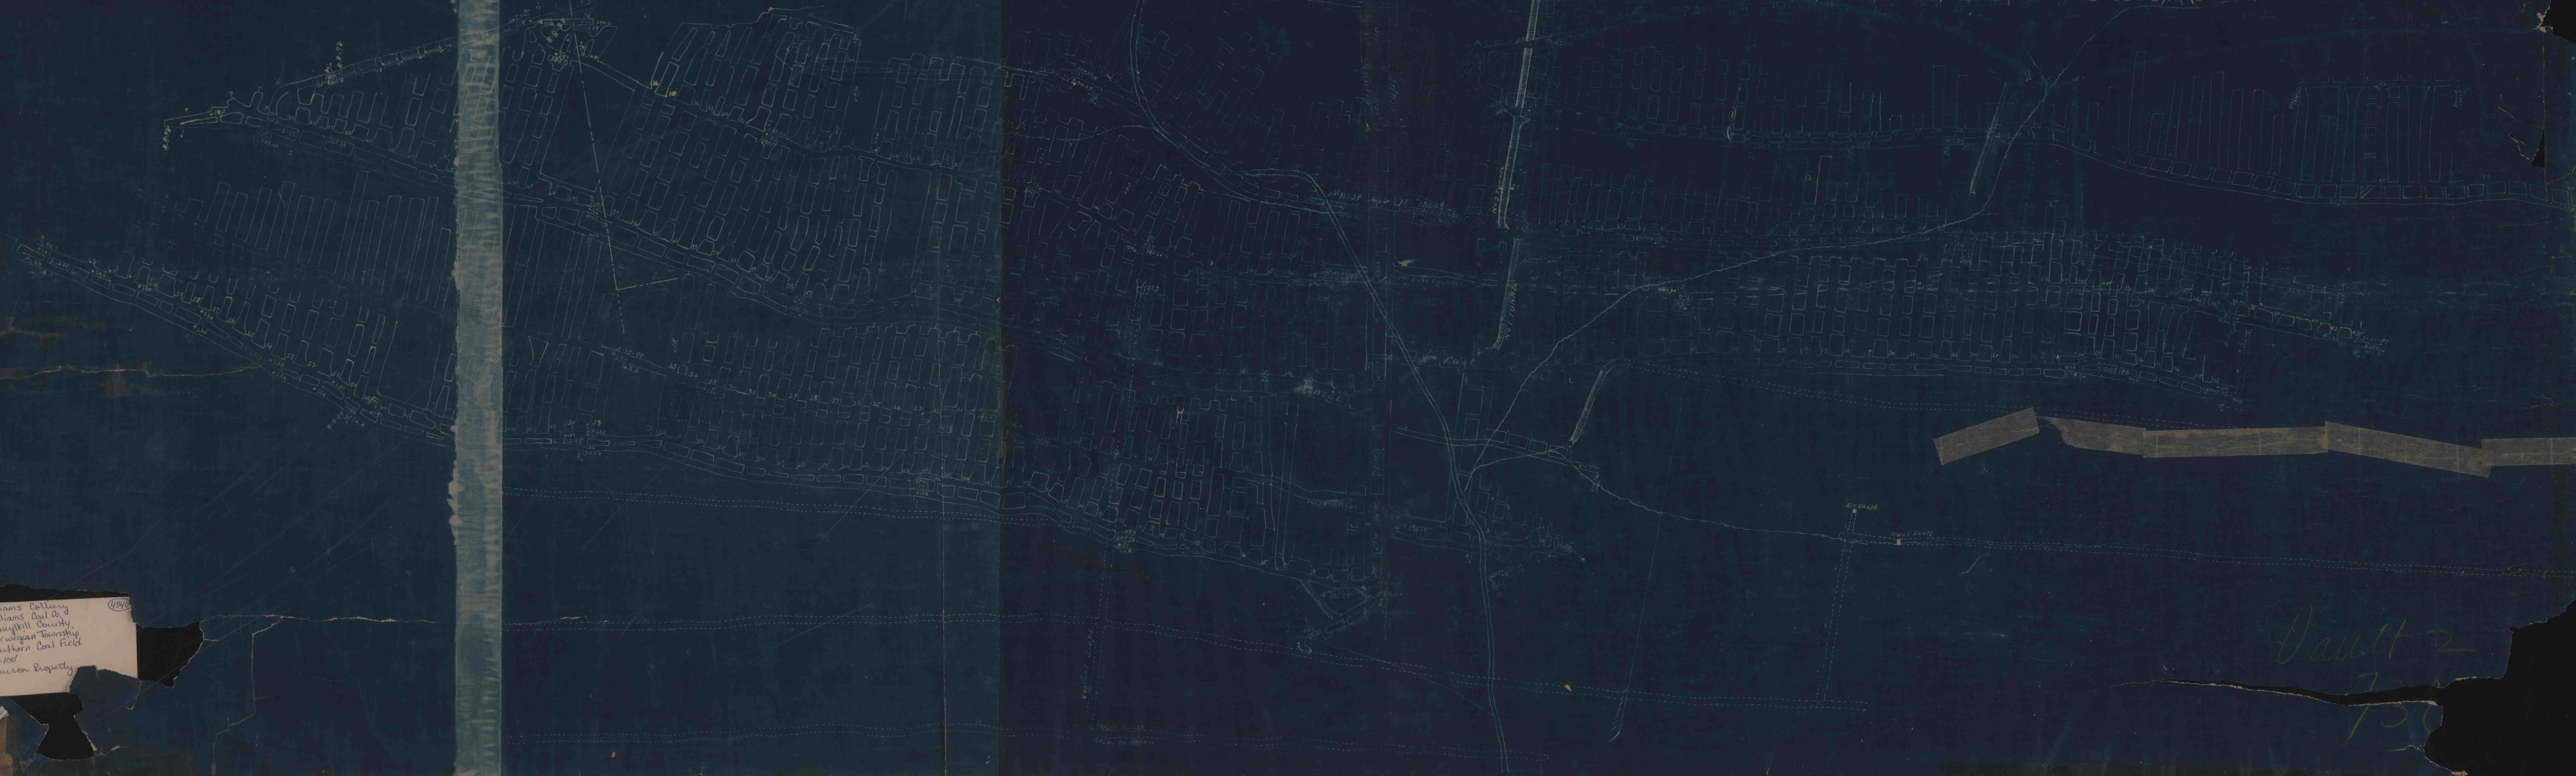

Williams Colliery
Williams Coal Co's
Schuylkill County,
Norwegian Township
Southern Coal Field
1"=100'

Vault 2
750

FIELD