


MF
MAR 10 1972
MAR 10 1972

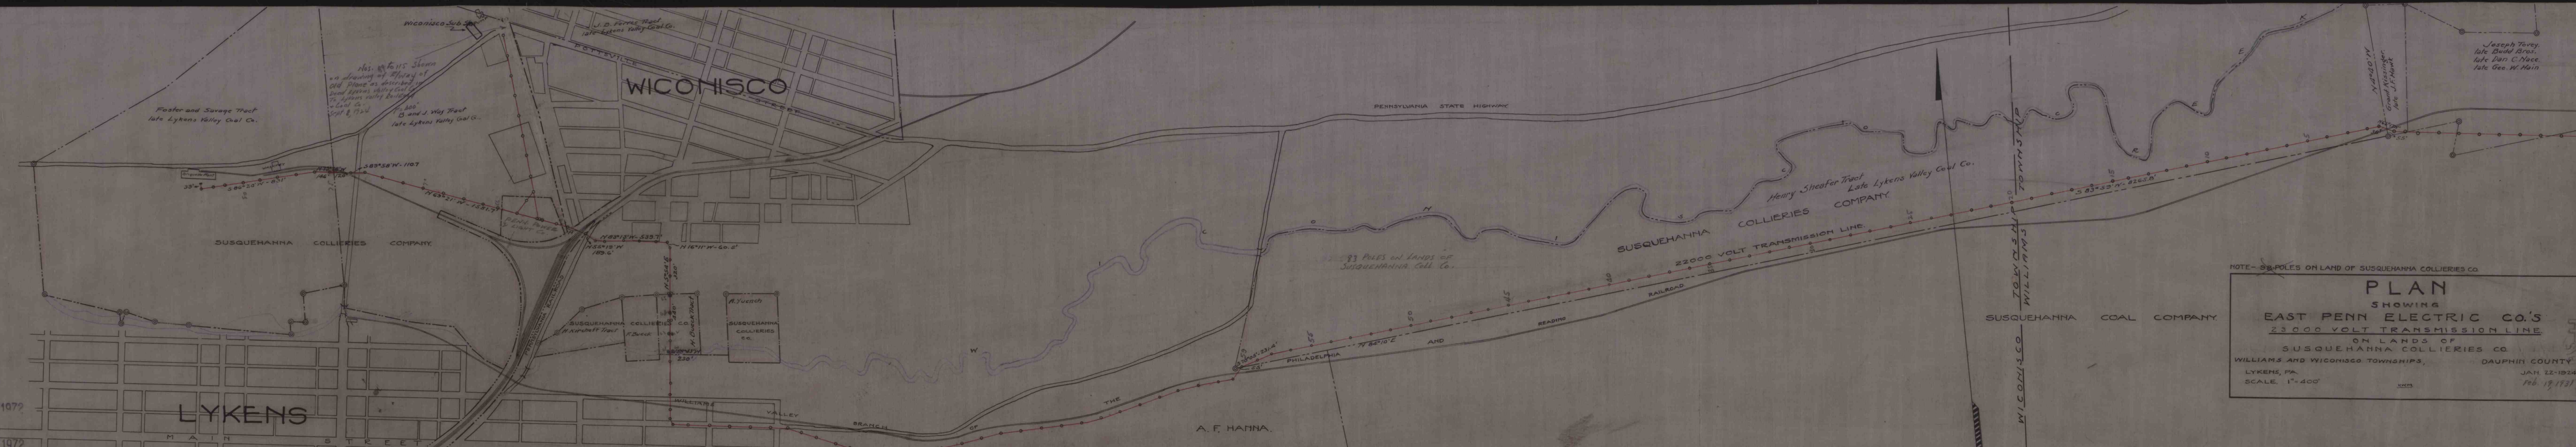

NOTE - 83 POLES ON LAND OF SUSQUEHANNA COLLIERIES CO.

PLAN
SHOWING
EAST PENN ELECTRIC CO.'S
23 000 VOLT TRANSMISSION LINE
ON LANDS OF
SUSQUEHANNA COLLIERIES CO.
WILLIAMS AND WICONISCO TOWNSHIPS,
LYKENS, PA.
SCALE, 1"=400'

DAUPHIN COUNTY
JAN. 22-1924
Feb. 19, 1931