


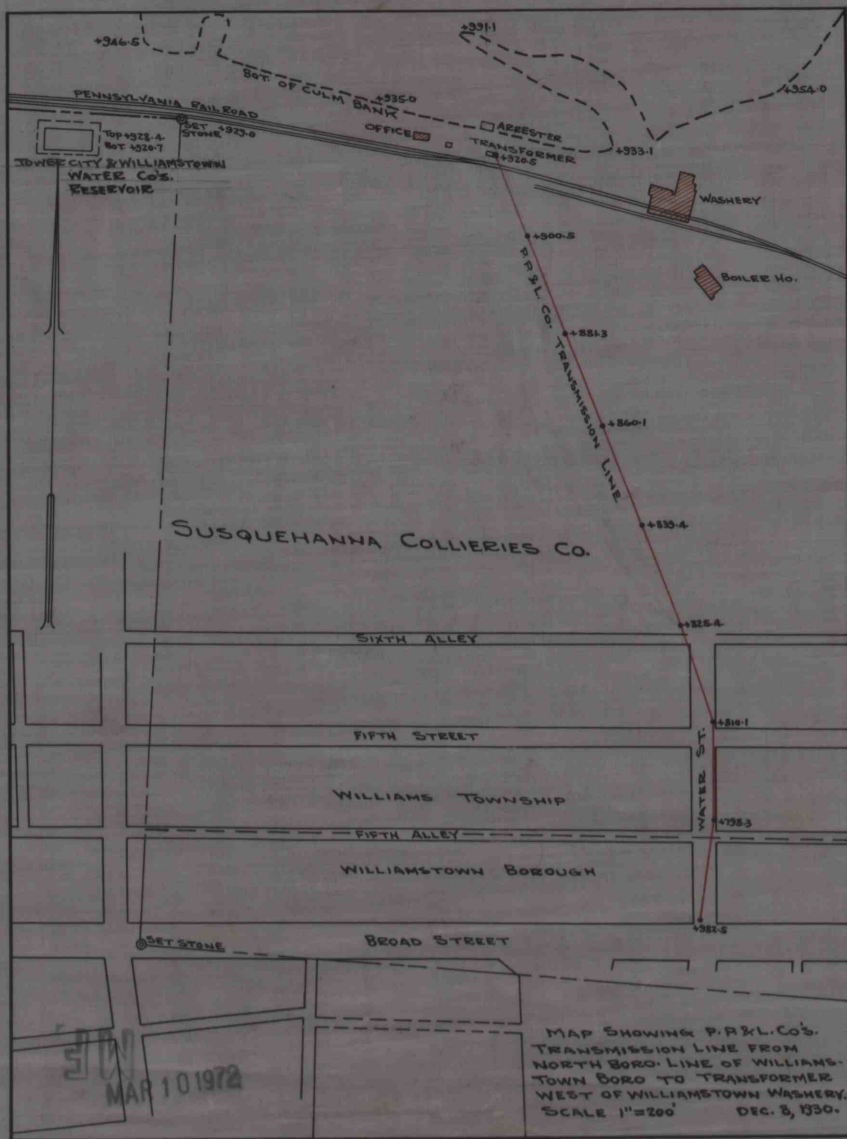

MAR 10 1972