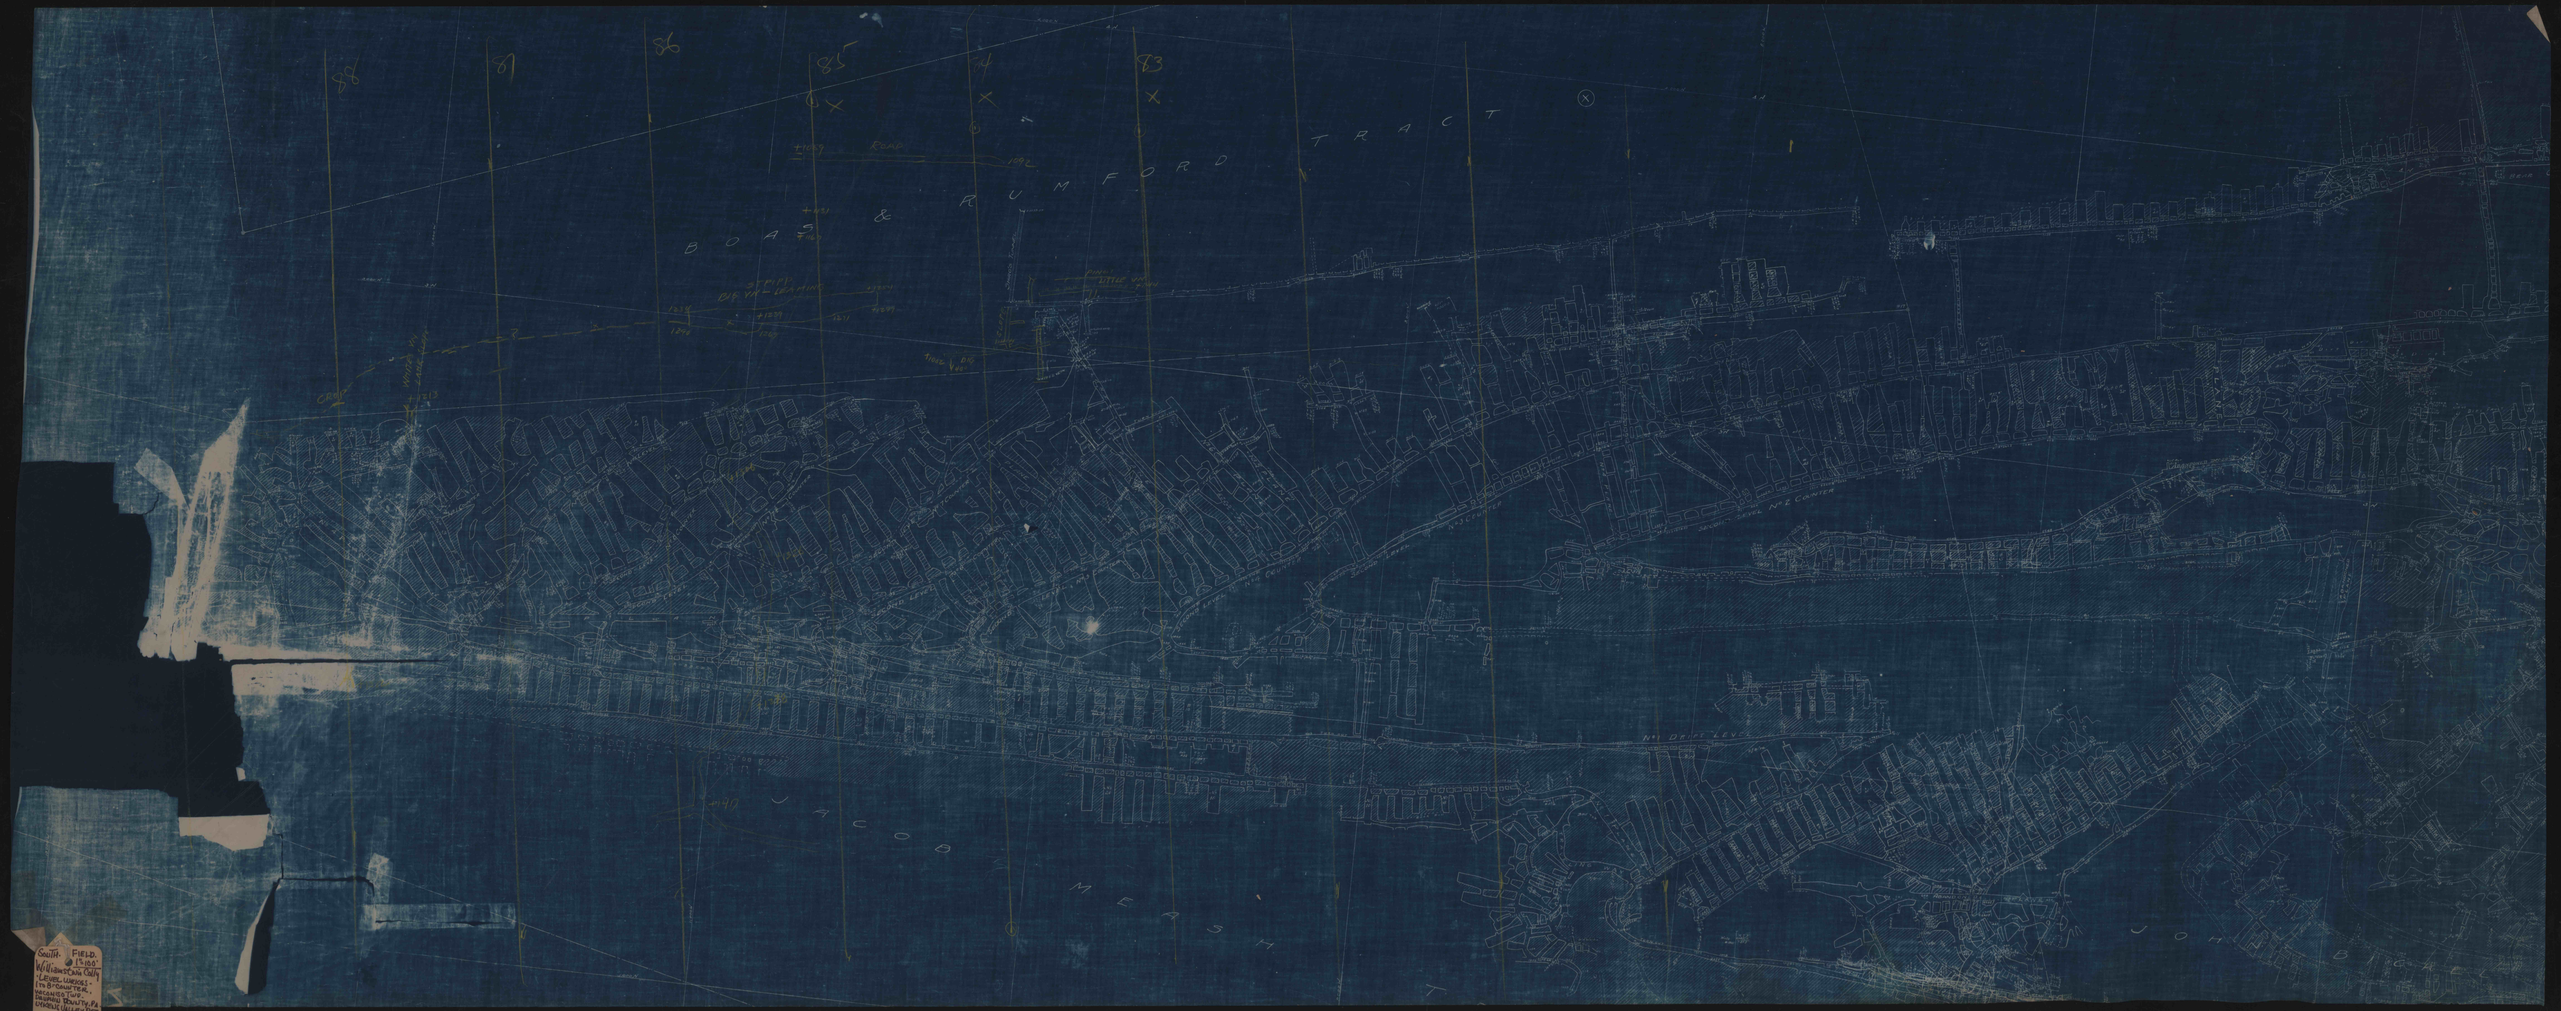

SOUTH FIELD
1" = 100'
