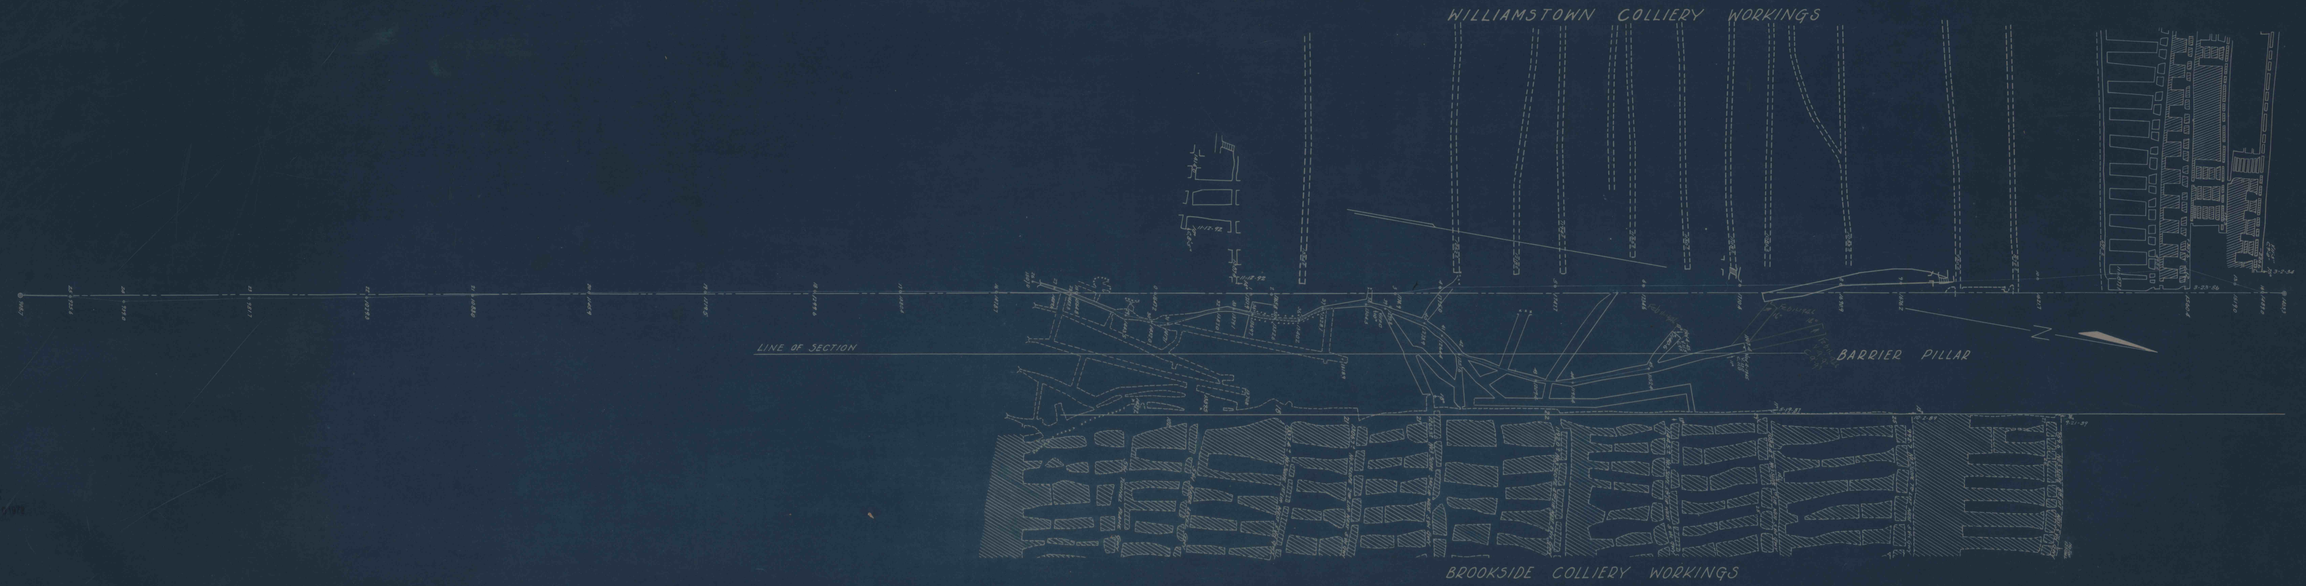

MAP SHOWING MINE WORKINGS IN LYKENS VALLEY W-5 VEIN
IN BARRIER PILLAR BETWEEN
WILLIAMSTOWN AND BROOKSIDE COLLIERIES
SCALE 1"=100'
Thomas L. Lewis, Consulting Engineer
Frackville Pa.

DATE
MAR 12 1929