


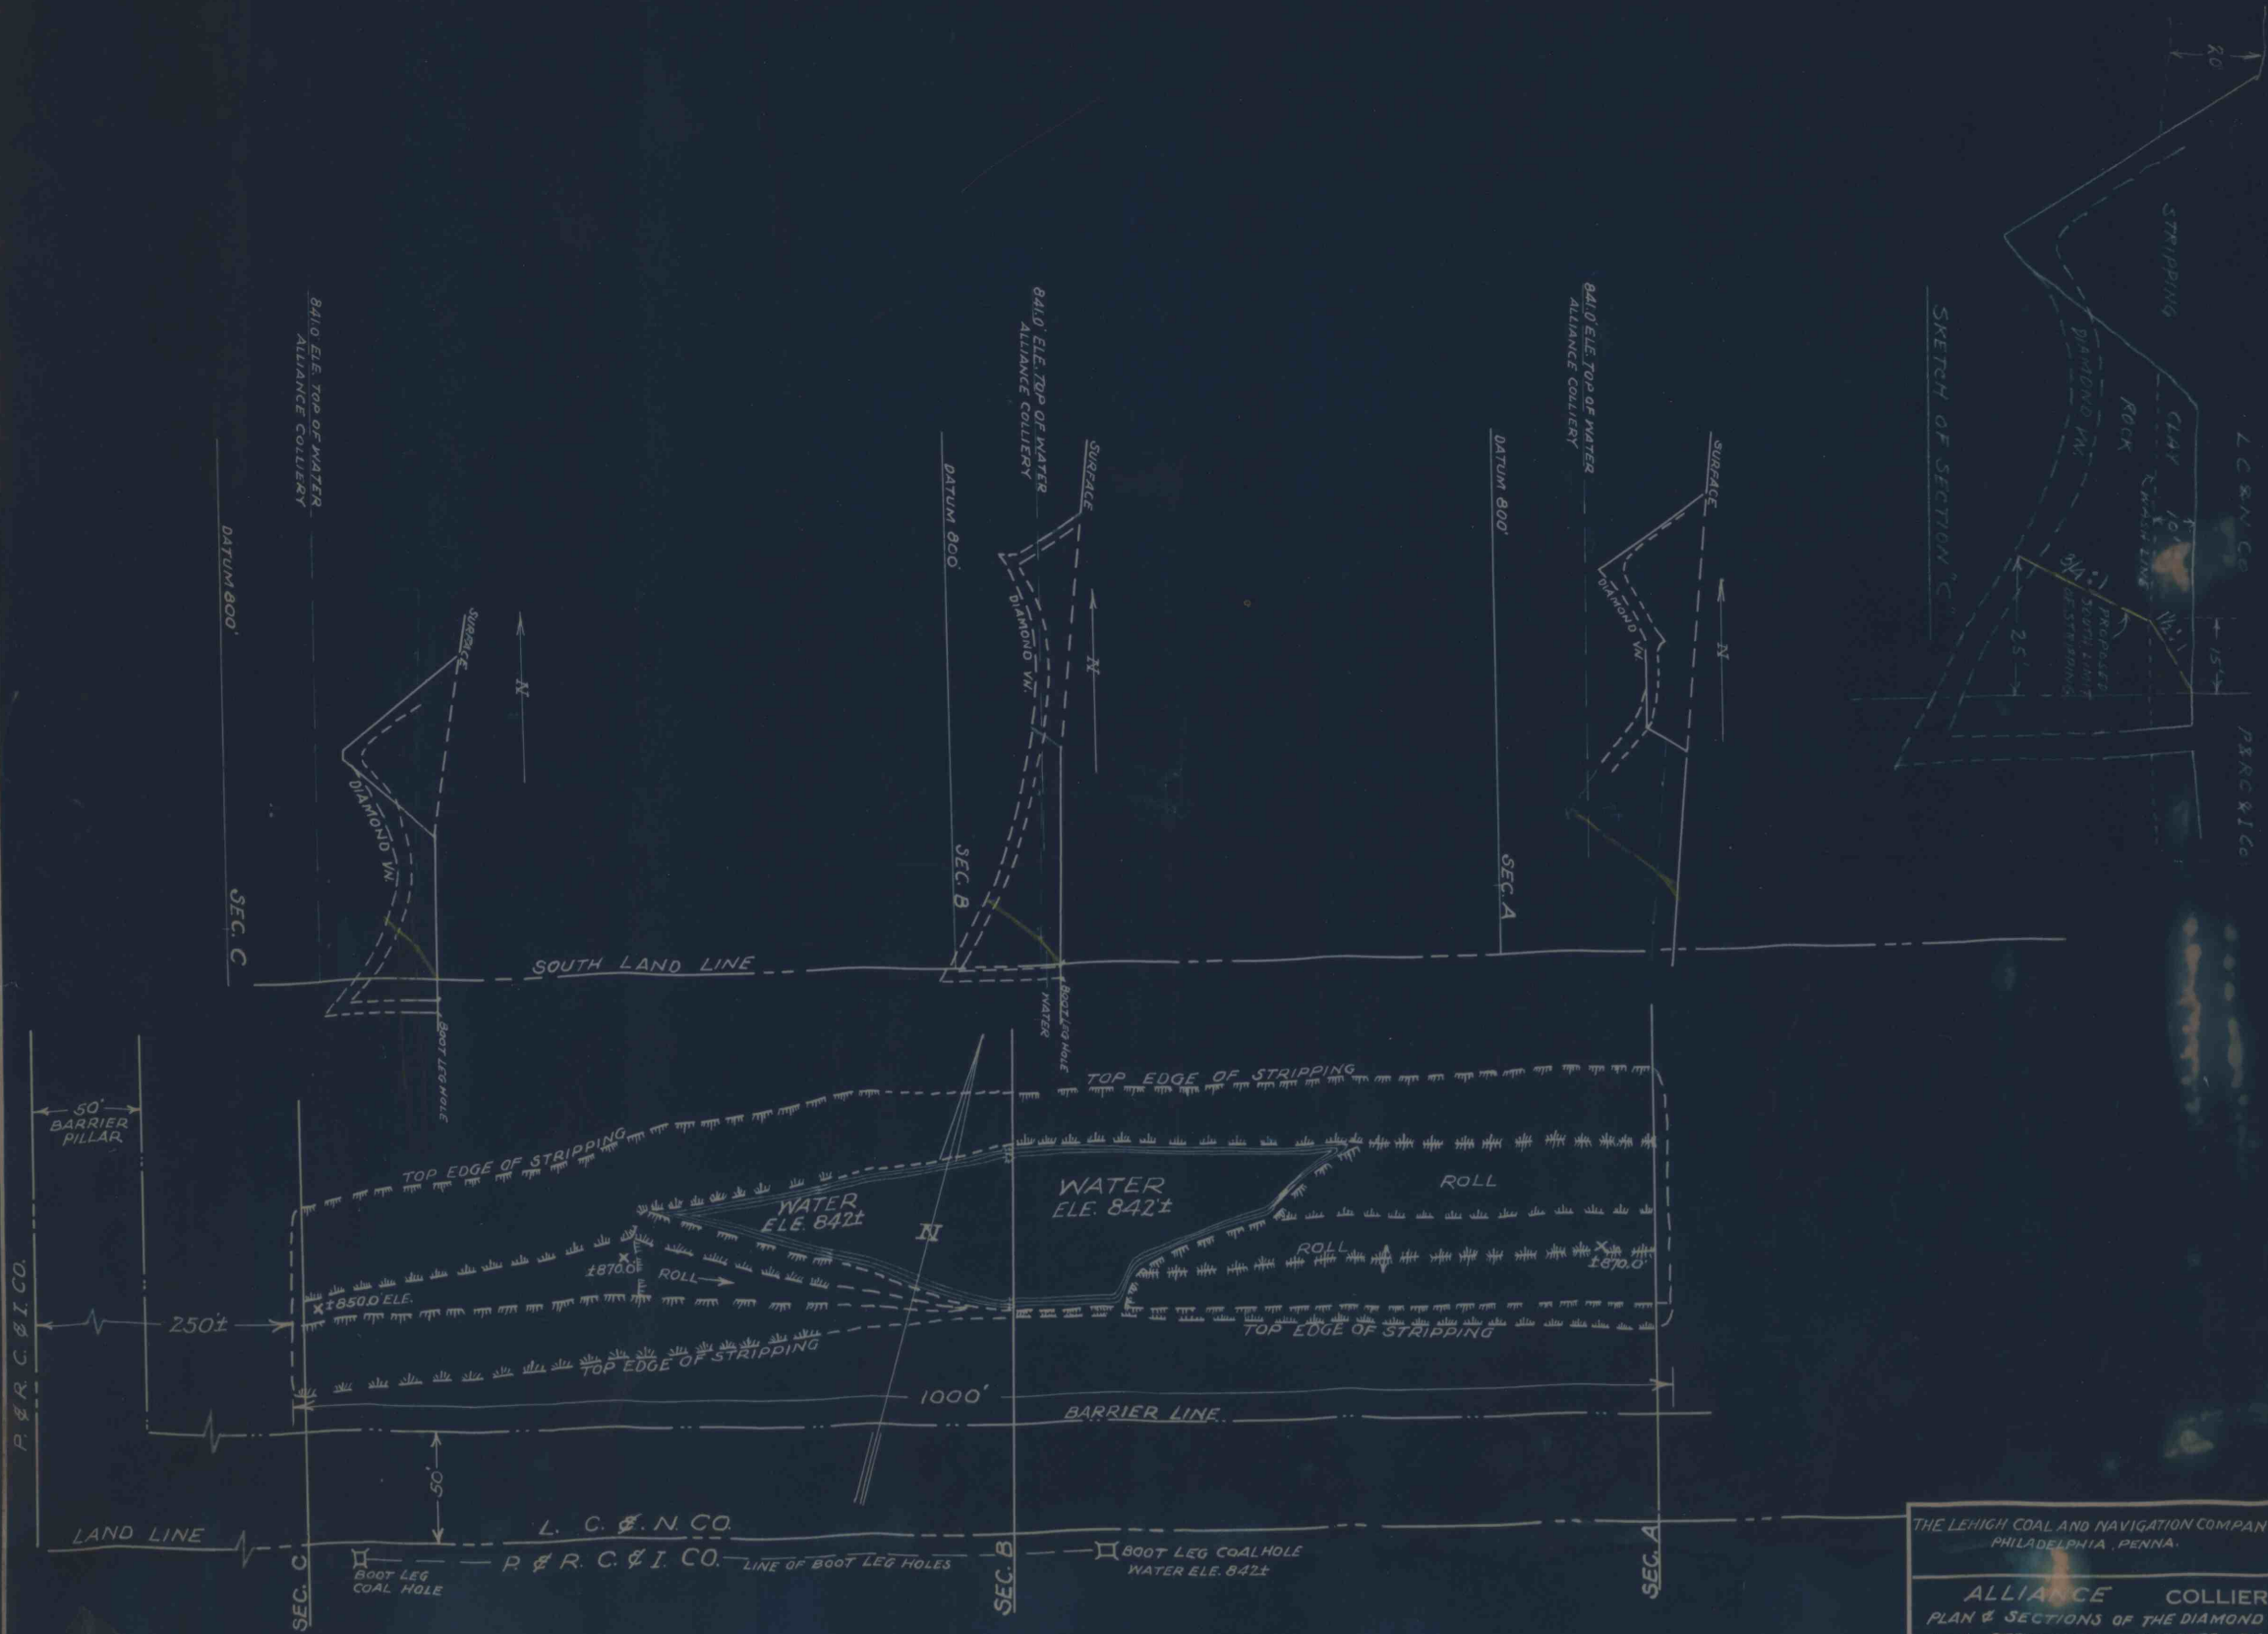

THE LEHIGH COAL AND NAVIGATION COMPANY
PHILADELPHIA, PENNA.

ALLIANCE COLLIERY
PLAN & SECTIONS OF THE DIAMOND
VEIN STRIPPINGS OPERATED BY
THE MERRIAM COAL MINING COMPANY

SCALE 1"=50' DATE JULY 22, 1938
MADE BY TRACED BY GMS CHECKED BY
REVISED

C975

Alliance Colliery
Merriam Coal Mining Co.
Diamond Vein
Schuylkill County
Blythe Township
Surface
Southern Coal Field
1"=50'
July 22, 1938

4285