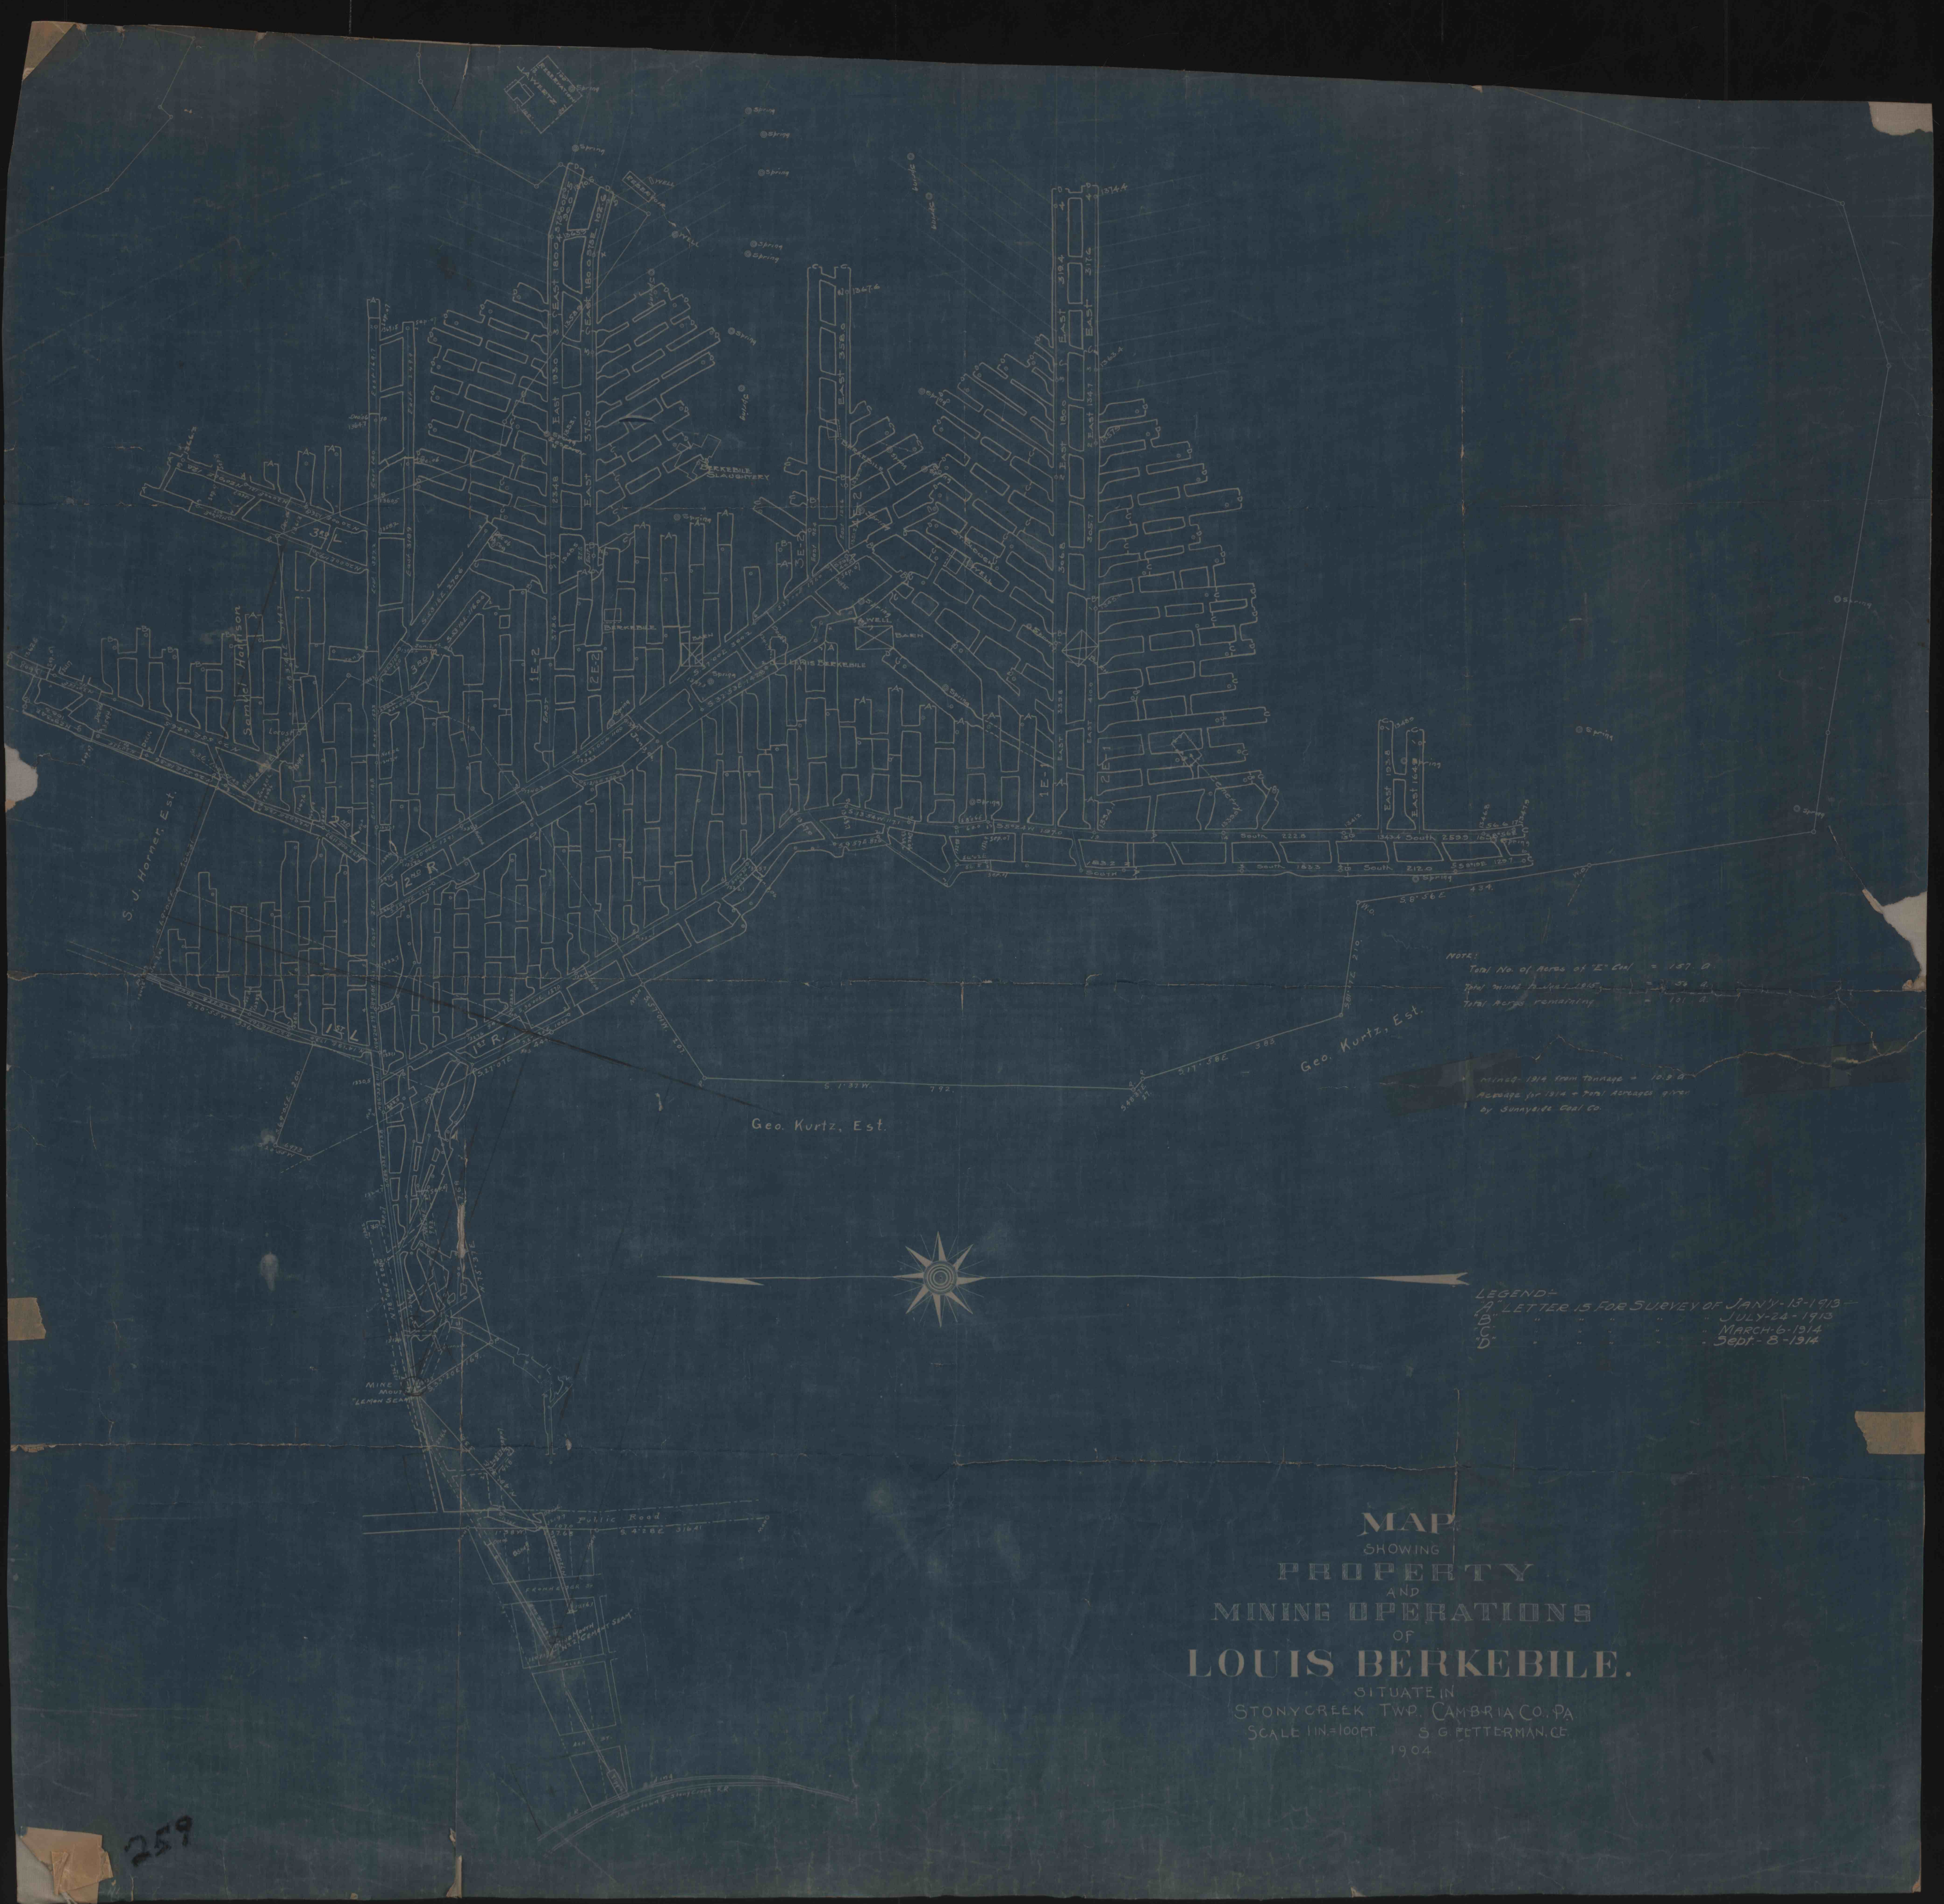
MAP
SHOWING
PROPERTY
AND
MINING OPERATIONS
OF
LOUIS BERKEBILE.
SITUATE IN
STONYCREEK TWP. CAMBRIA CO. PA.
SCALE 1 IN.=100 FT.
S. G. FETTERMAN, C.E.
1904
NOTE:
Total No. of Acres of "E" Coal = 157. a.
Total mined to Jan 1 1915 = 56 a.
Total Acres remaining = 101 a.
Mined - 1914 from tonnage = 10.9 a.
Acreage for 1914 & Total Acreages given
by Sunnyside Coal Co.
LEGEND:-
"A" LETTER IS FOR SURVEY OF JAN'Y-13-1913
"B" " " " " " JULY-24-1913
"C" " " " " " MARCH-6-1914
"D" " " " " " Sept.-8-1914
Geo. Kurtz, Est.
Geo. Kurtz, Est.
S. J. Horner, Est.
Public Road
2nd R
1st R
259