


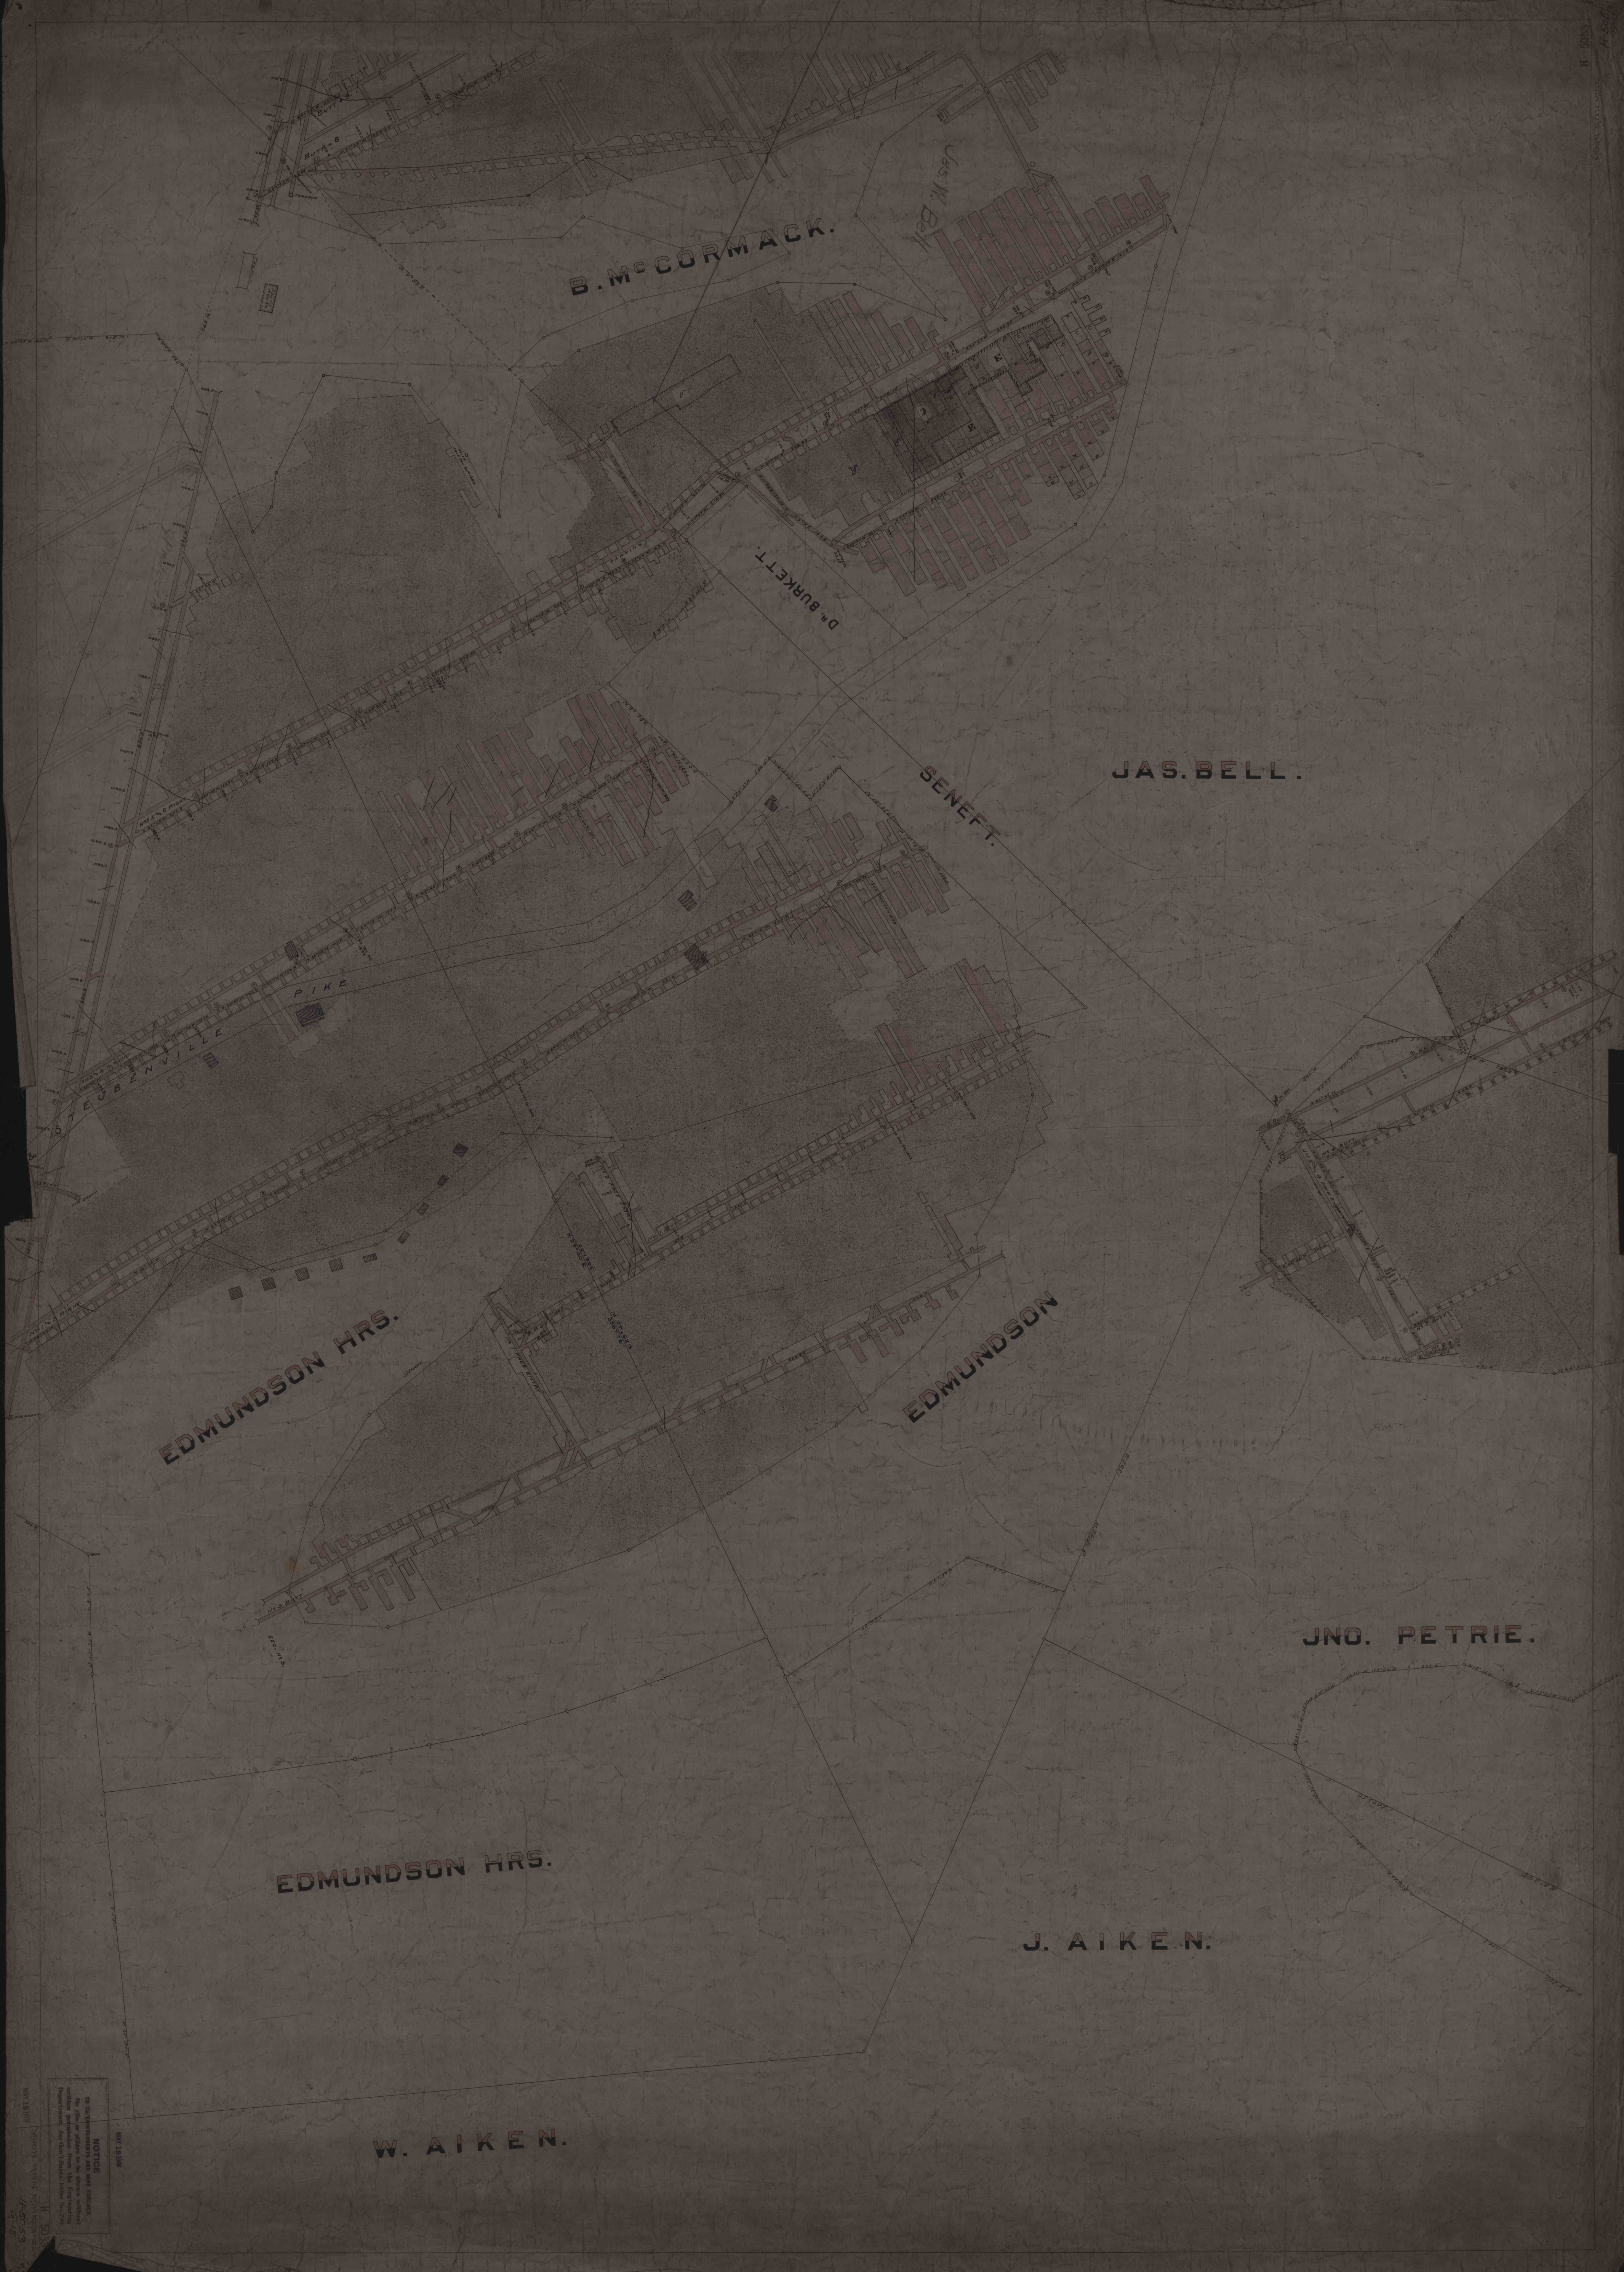

B. McCORMACK.

Jas. W. Bell

D. BURKETT.

JAS. BELL.

SENEFF.

EDMUNDSON HRS.

EDMUNDSON

EDMUNDSON HRS.

JNO. PETRIE.

J. AIKEN.

W. AIKEN.

NOTICE
