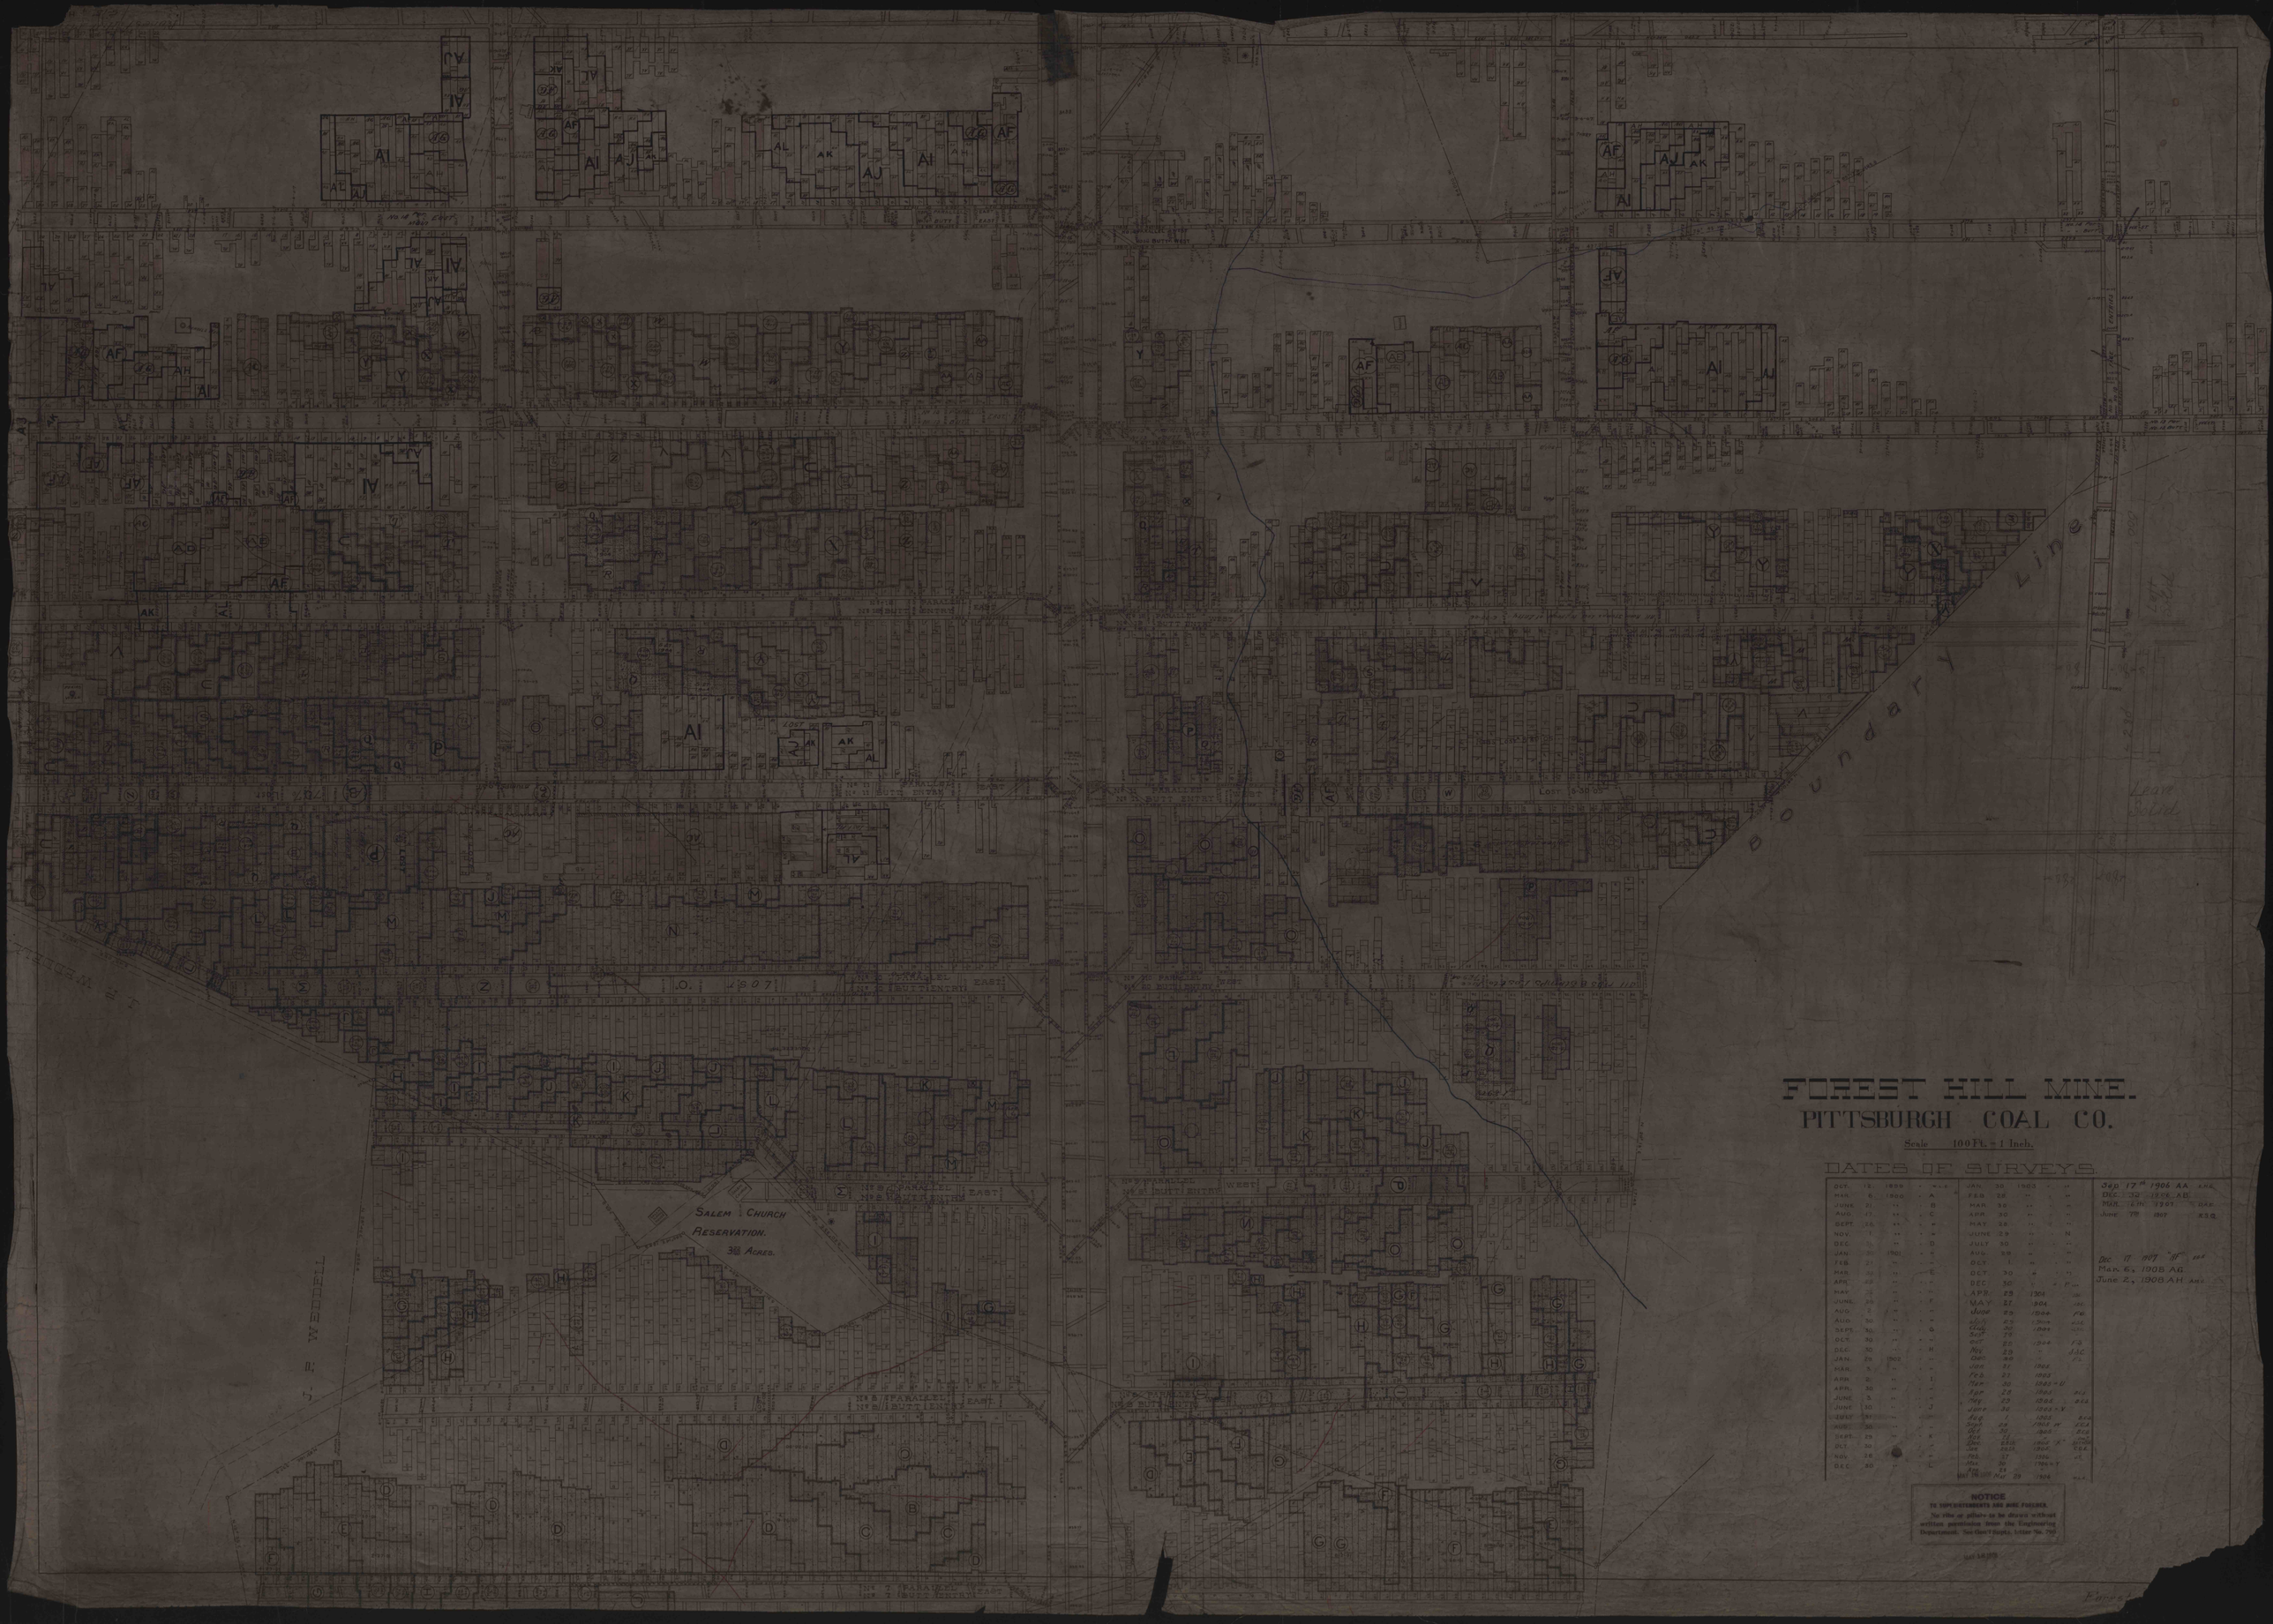
FOREST HILL MINE.
PITTSBURGH COAL CO.
Scale 100 Ft. = 1 Inch.
DATES OF SURVEYS.
Salem Church Reservation. 3⅜ Acres.
Boundary Line
NOTICE
TO SUPERINTENDENTS AND MINE FOREMEN.
No vein or pillars to be drawn without written permission from the Engineering Department. See Gen'l Supts. Letter No. 79.