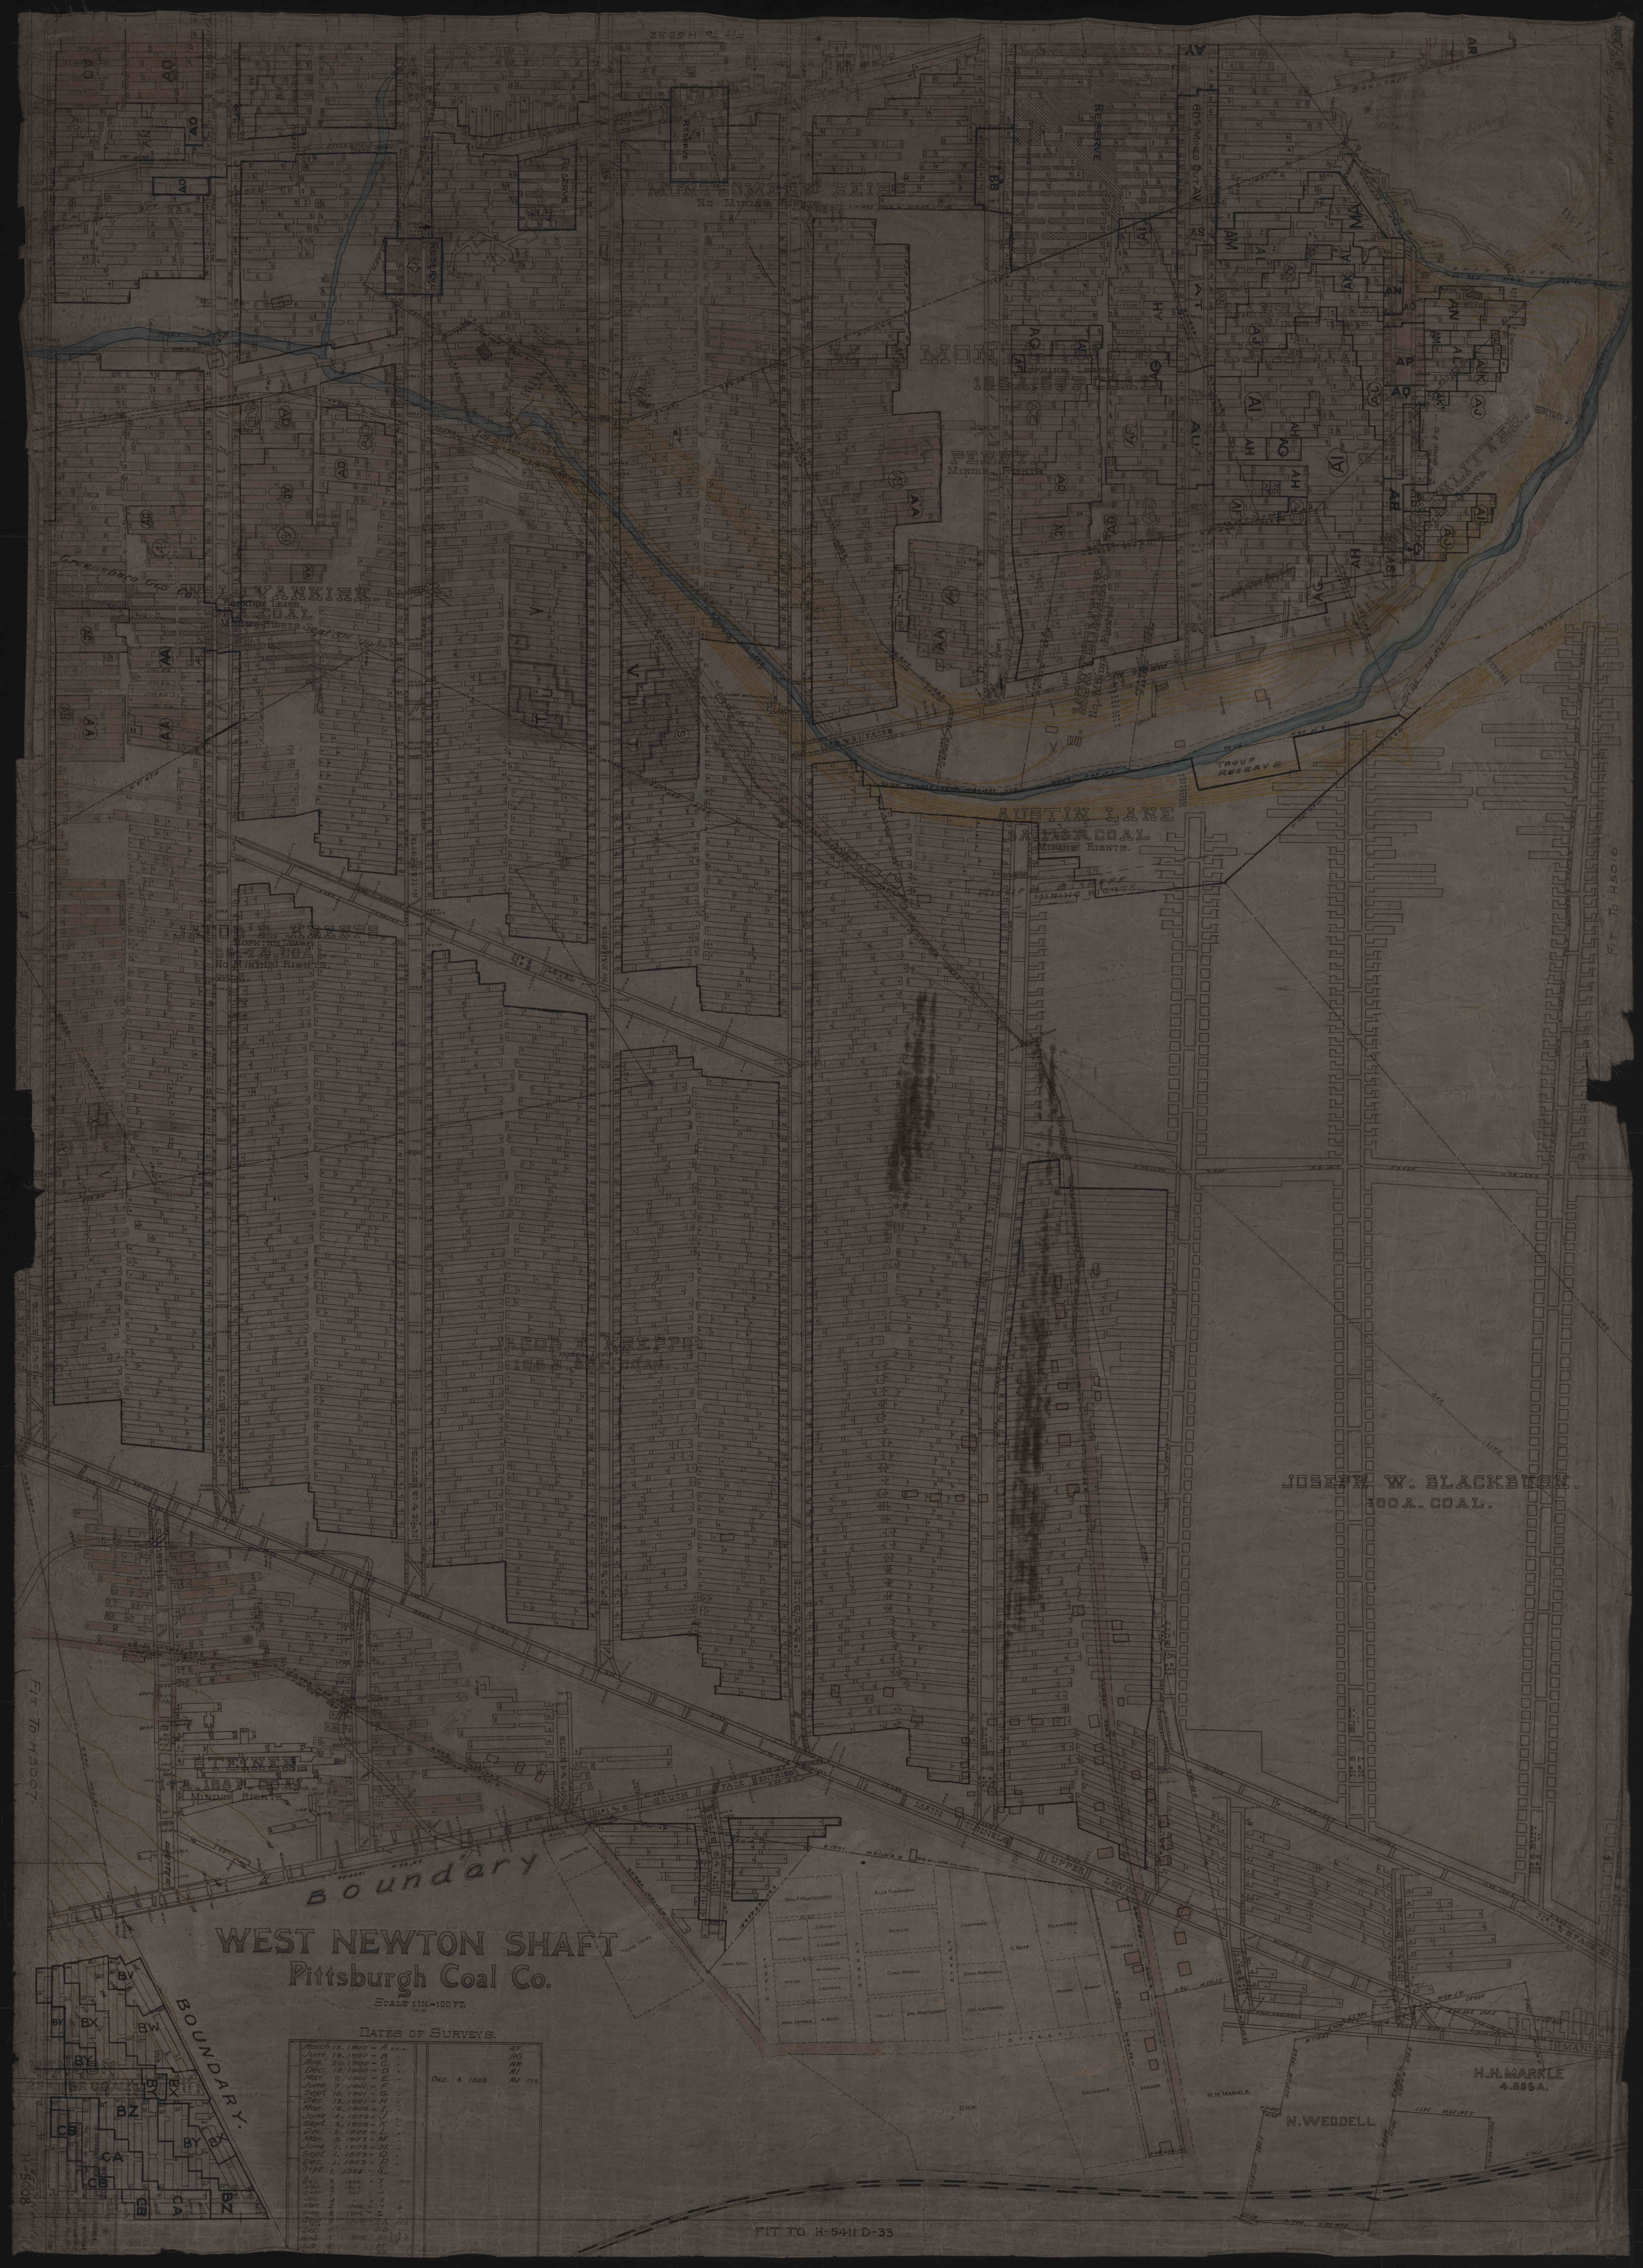
WEST NEWTON SHAFT
Pittsburgh Coal Co.
SCALE 1 IN. = 100 FT.
DATES OF SURVEYS.
March 13, 1900 = A.
June 18, 1900 = B.
Aug. 20, 1900 = C.
Dec. 12, 1900 = D.
Mar. 2, 1901 = E.
June 7, 1901 = F.
Sept. 10, 1901 = G.
Dec. 13, 1901 = H.
Mar. 12, 1902 = J.
June 4, 1902 = J.
Sept. 3, 1902 = K.
Dec. 2, 1902 = L.
Mar. 3, 1903 = M.
June 1, 1903 = N.
Sept. 1, 1903 = O.
Dec. 1, 1903 = P.
Sept. 1, 1904 = S.
Dec. 2, 1904 = T.
Mar. 3, 1905 = U.
Sept. 2, 1905 = V.
Dec. 4 = X.
Mar. 2, 1906 = Y.
June 8, 1906 = Z.
Sept. 8, 1906 = ZA.
Dec. 11 = AB.
March 1, 1907 = AC.
July 4 = AE.
Dec. 4, 1908 AJ
Boundary
BOUNDARY.
MONTGOMERY HEIRS
No Mining Rights
MONTGOMERY
125 A. 58 P. COAL
PENNY
Mining Rights
L. YANKIRK.
COAL
Mining Rights
AUSTIN LANE
COAL
Mining Rights
JACOB H. KEPPER
COAL
No Mining Rights
STEINER
COAL
Mining Rights
JOSEPH W. BLACKBURN.
100 A. COAL.
H.H. MARKLE
4.886 A.
N. WEDDELL
H.H. MARKLE
DICK
Mrs. A. Montgomery
Ella Flannigan
Newlin
Chas. Markle
Chas. Robinson
Jas. Montgomery
Jas. Latimore
J. Latimore
C. Neff
F.A. Hayden
Moore
Bishop
Walters
Steiner
Callagher
Mrs. Conner
A. Budd
Kelley
Weise
J. Kearick
M. Hudock
J. Leckey
C. Leckey
John Gaul
Young Heirs
Harry Young
Mine Level
Main Tunnel
Upper Level
South Face Entries
Road
Mine Entrance
Neville Butts
Nevin Butts
Nevin Butts
Nevin