


OCT 2 1977
MINING PERMIT APPL. MNG PERMIT NO 10-37
DRAINAGE PERMIT NO 42745 M.C. AMEND.
AREA TO BE AFFECTED - 16.41 AC IN RED
AREA TO BE MINED - 13.50 AC IN YELLOW

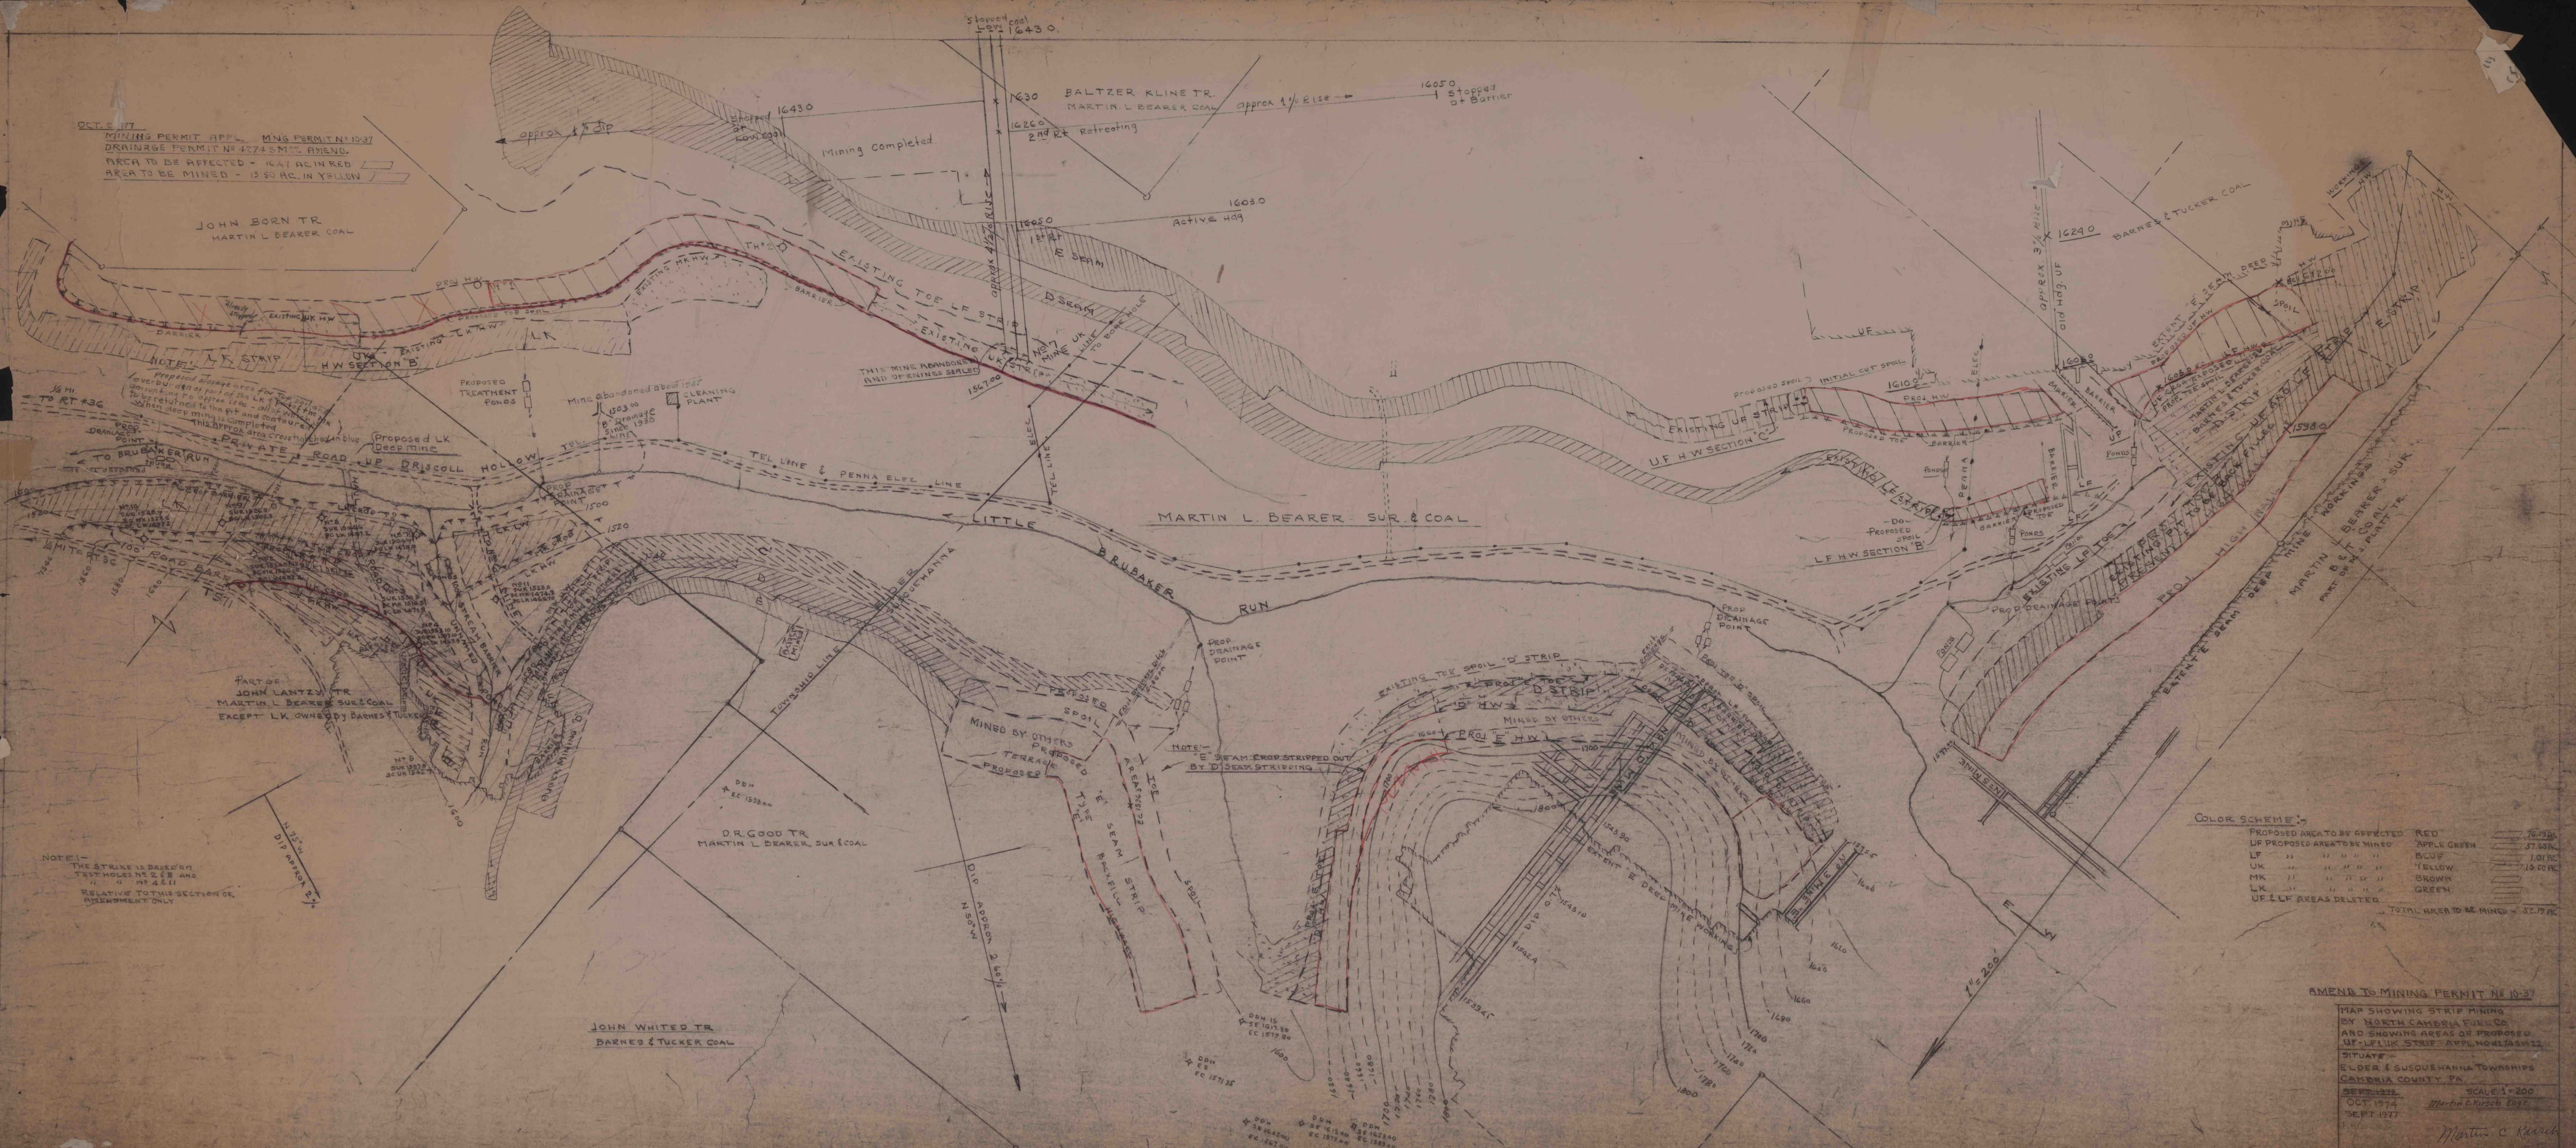

COLOR SCHEME

PROPOSED AREA TO BE AFFECTED	RED	76.75 AC
LF PROPOSED AREA TO BE MINED	APPLE GREEN	37.65 AC
LF	BLUE	1.01 AC
UK	YELLOW	10.50 AC
MK	BROWN	
LK	GREEN	
UP & LF AREAS DELETED		
TOTAL AREA TO BE MINED		32.92 AC

AMEND TO MINING PERMIT NO 10-37
MAP SHOWING STRIP MINING
BY NORTH CAMBRIA FUEL CO.
AND SHOWING AREAS OF PROPOSED
UP-LEAK STRIP APPL NO 42745 M.C.
SITUATE
ELDER & SUSQUEHANNA TOWNSHIPS
CAMBRIA COUNTY PA.
OCT 1977
SEPT 1977
Martin C. Kirsch Eng.

Map 74