


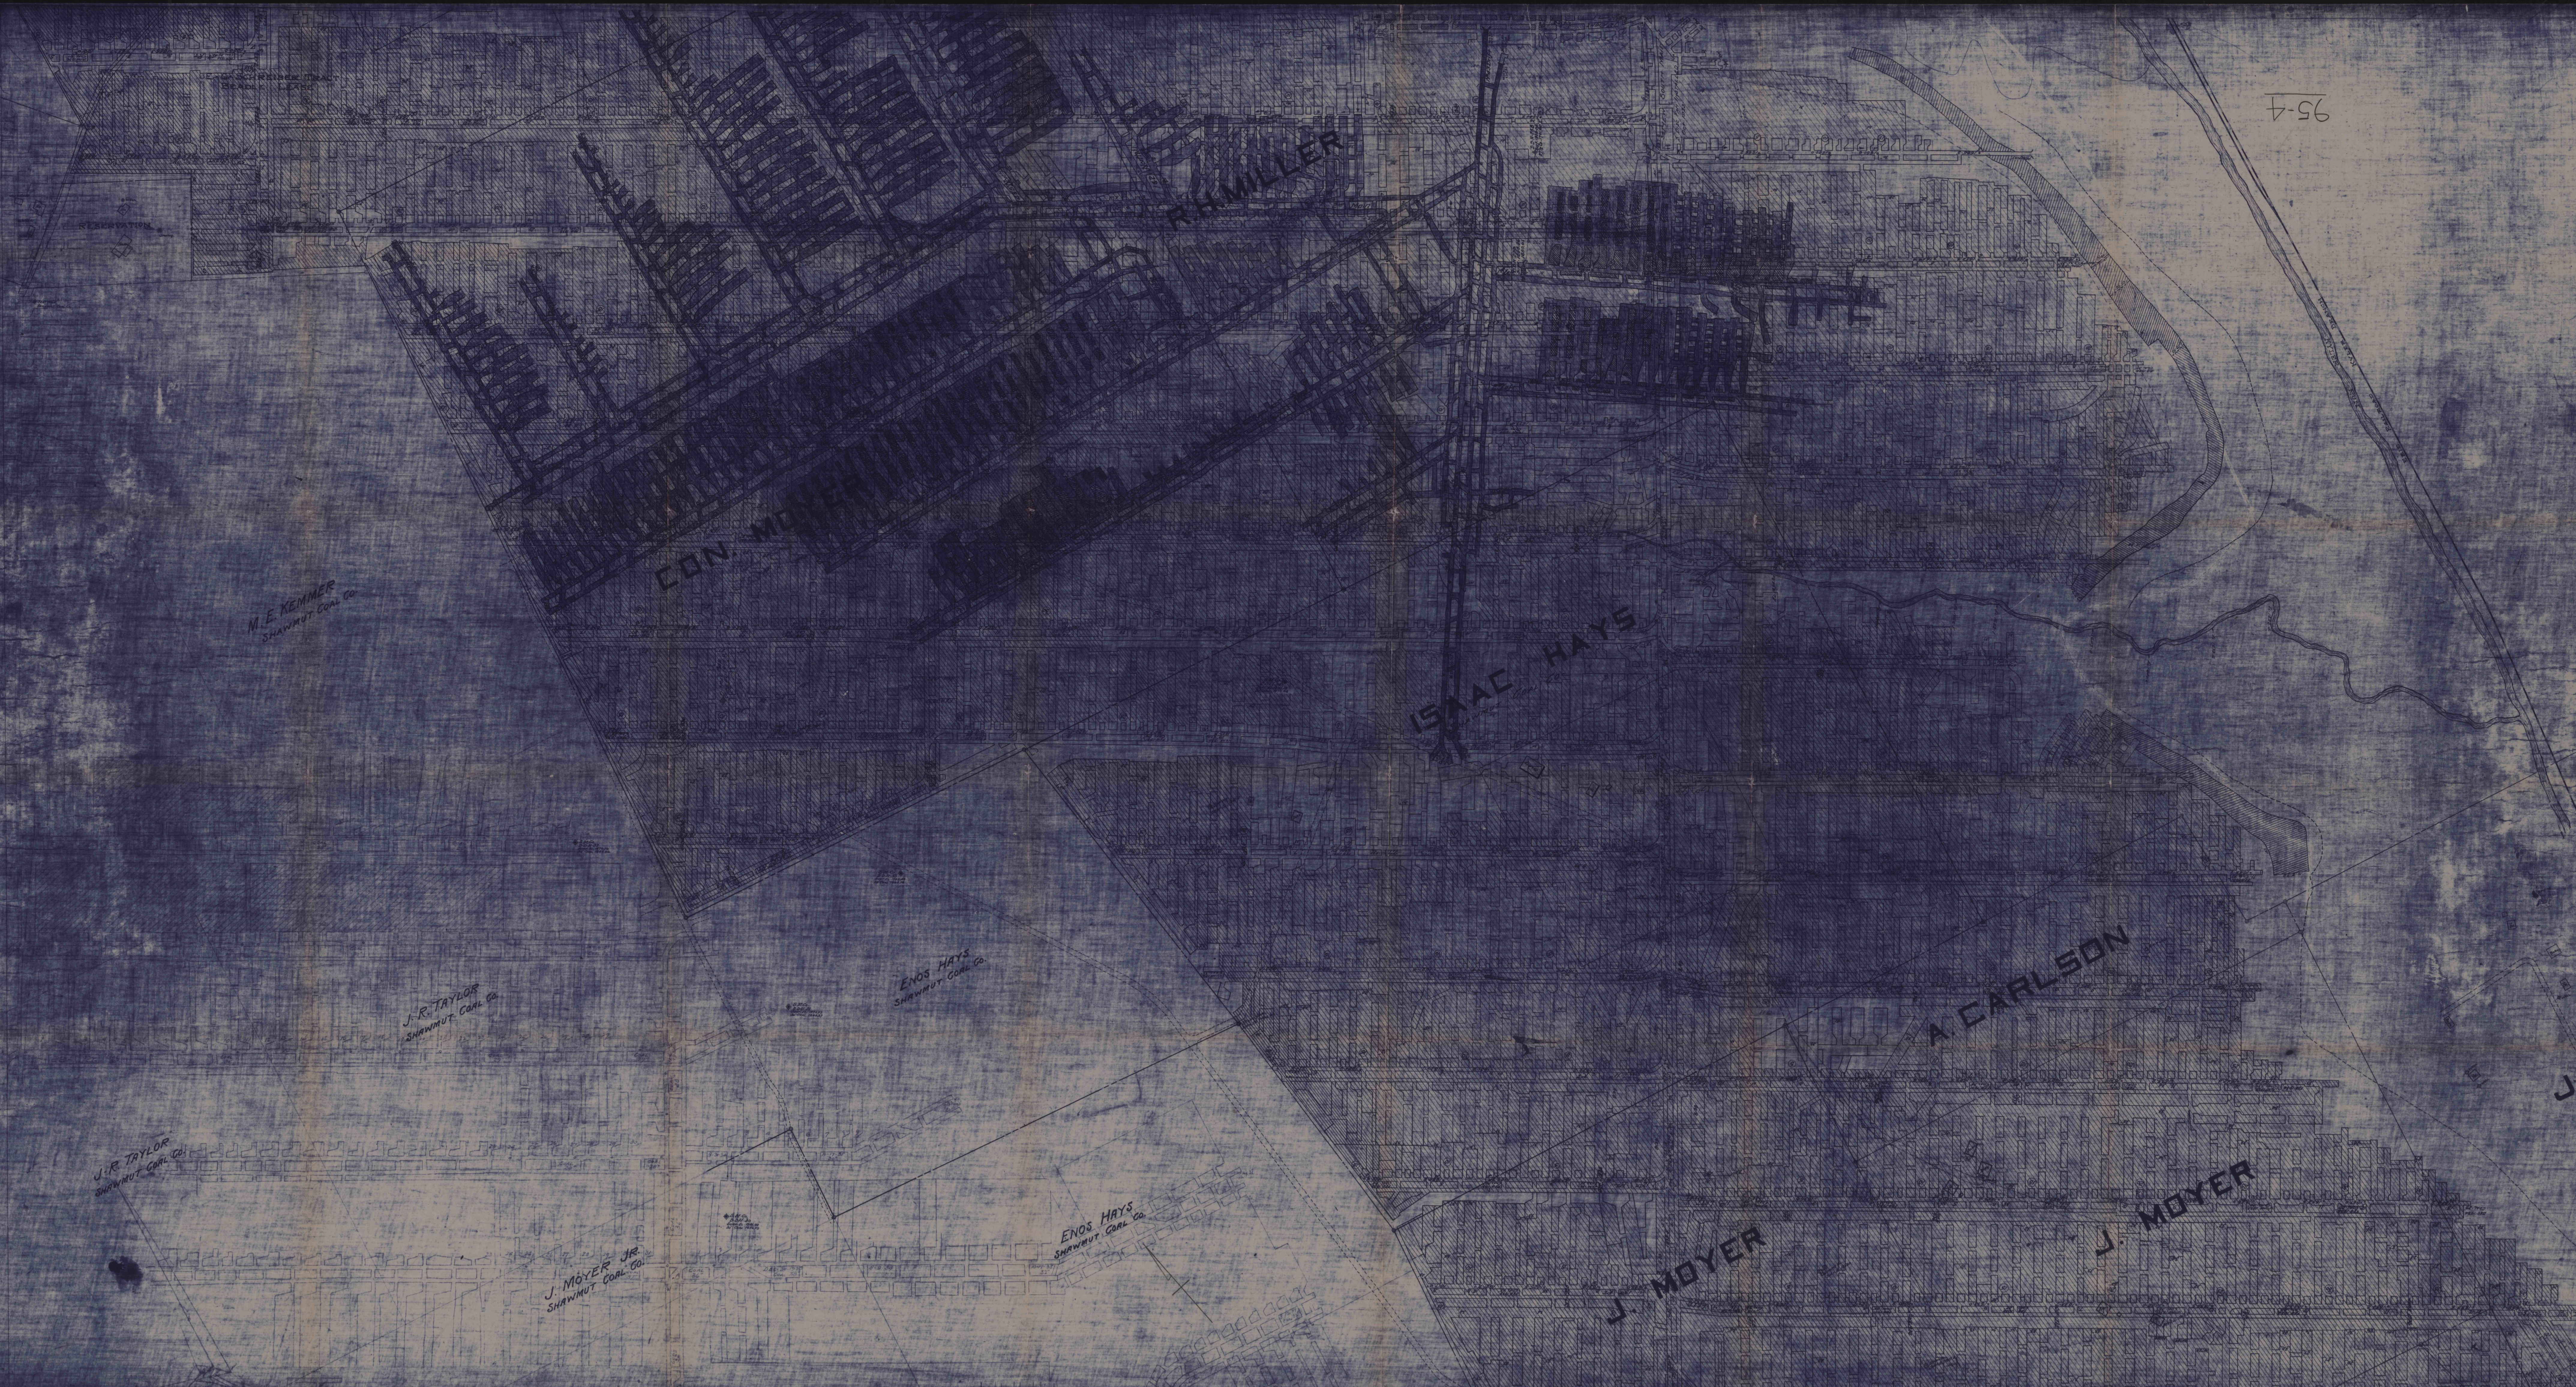

M.E. KEMMER
SHAWMUT COAL CO.

J.R. TAYLOR
SHAWMUT COAL CO.

J. MOYER JR.
SHAWMUT COAL CO.

ENOS HAYS
SHAWMUT COAL CO.

ENOS HAYS
SHAWMUT COAL CO.

ISAAC HAYS

A. CARLSON

J. MOYER

J. MOYER

CON. M...

W. MILLER