


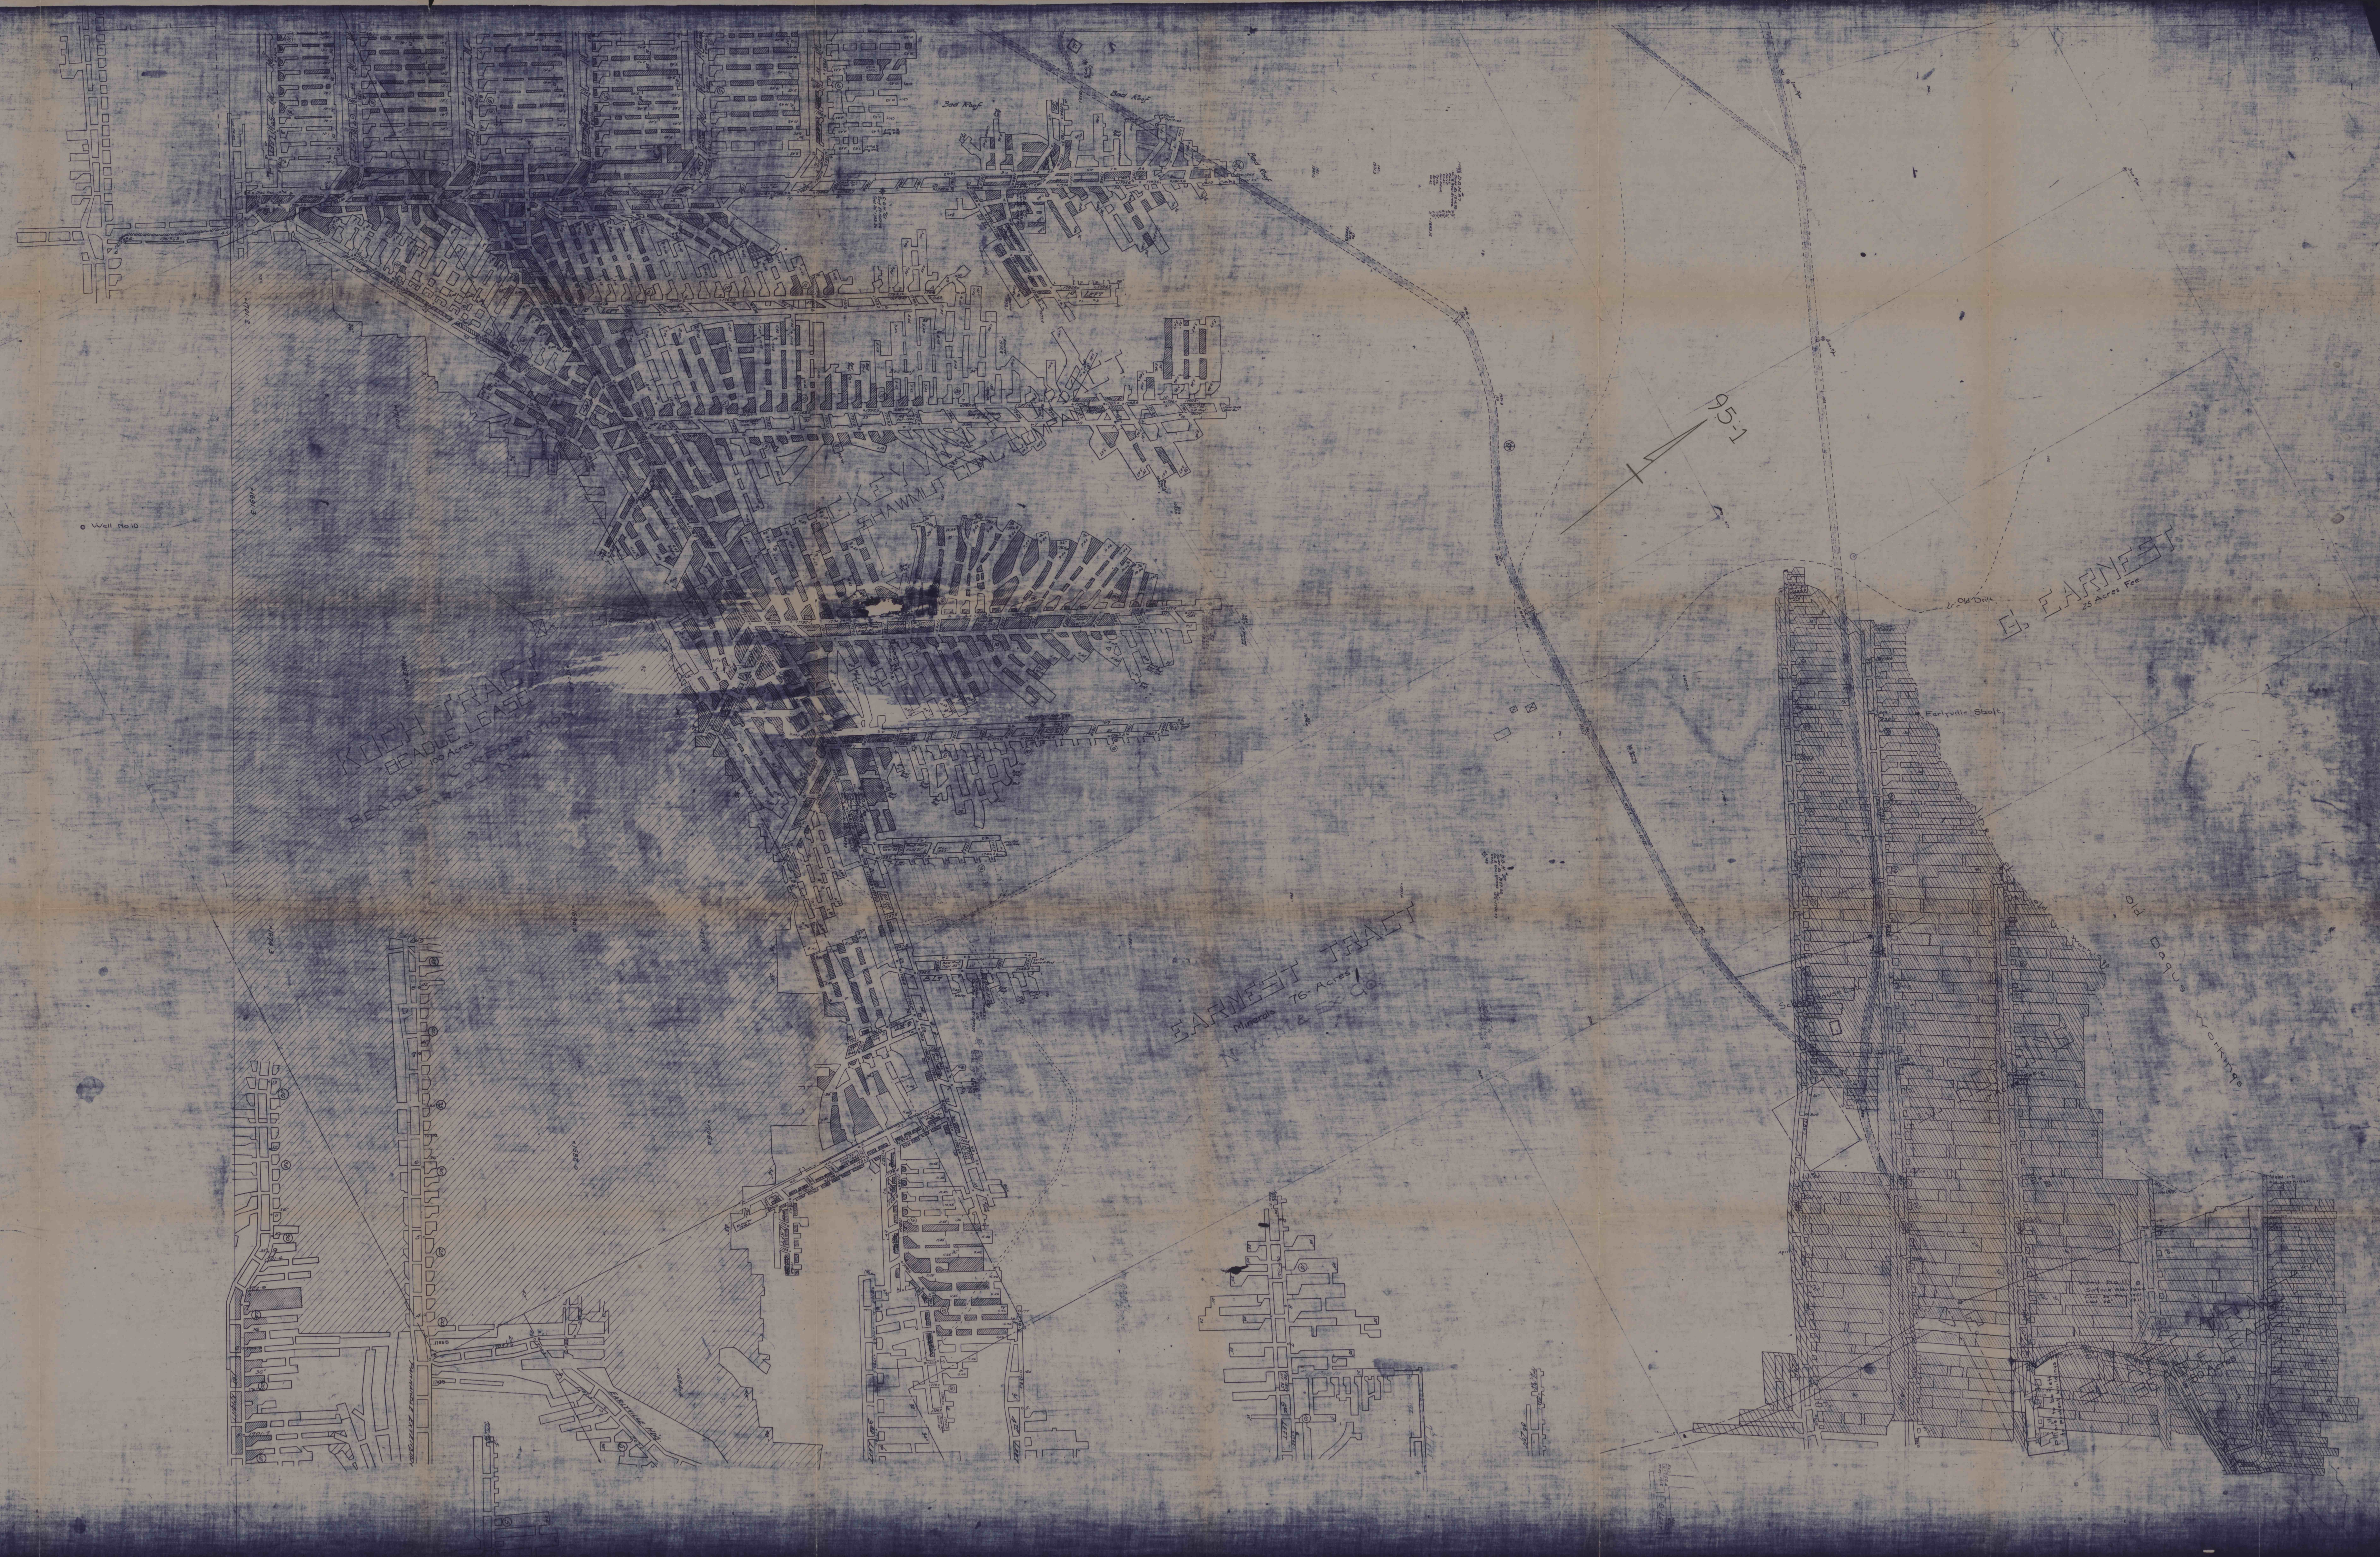

KITCH TRACT
100 Acres

EARNEST TRACT
16 Acres
N. H. & Co.

E. EARNEST
25 Acres
P. M.


95-1