


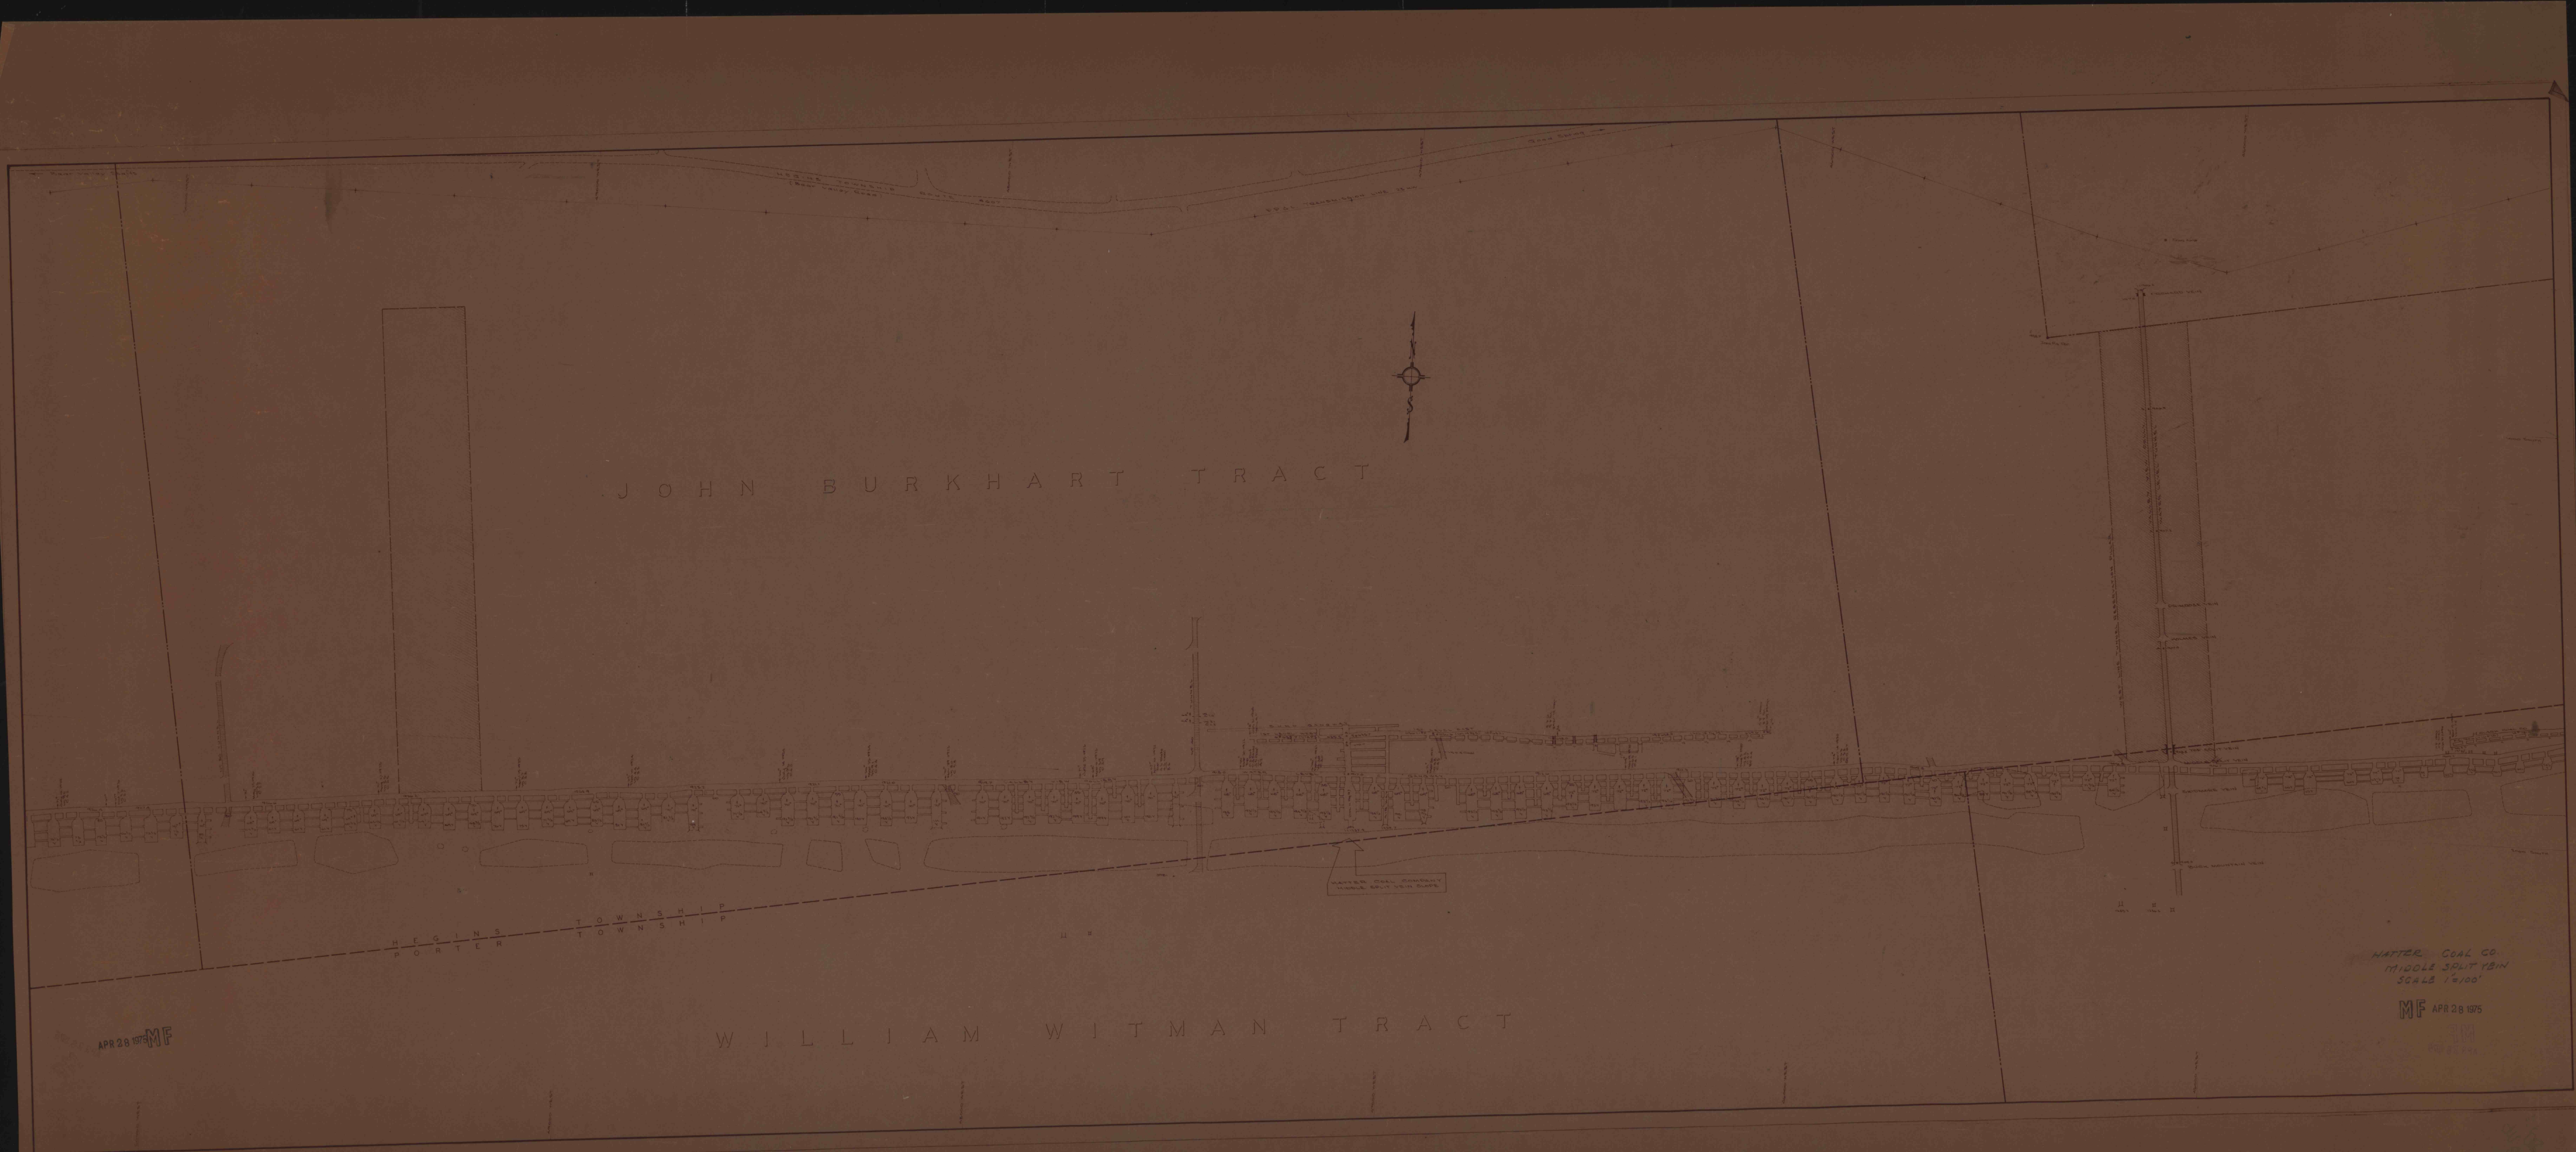

JOHN BURKHART TRACT

WILLIAM WITMAN TRACT

APR 28 1975 MF

WATER COAL CO.
MIDDLE SPLIT YBIN
SCALE 1"=100'

MF APR 28 1975

WILLIAM WITMAN TRACT
MF APR 28 1975
(10)