


EASTON 100LB
HAZLETON #6
MAMMOTH STRIPPERS-DISTED
MAR 10 1972 MF
I-SEPIA

CONCORD COAL CO.
4-14-58

MF MAR 10 1972
SHEET 1 OF 2

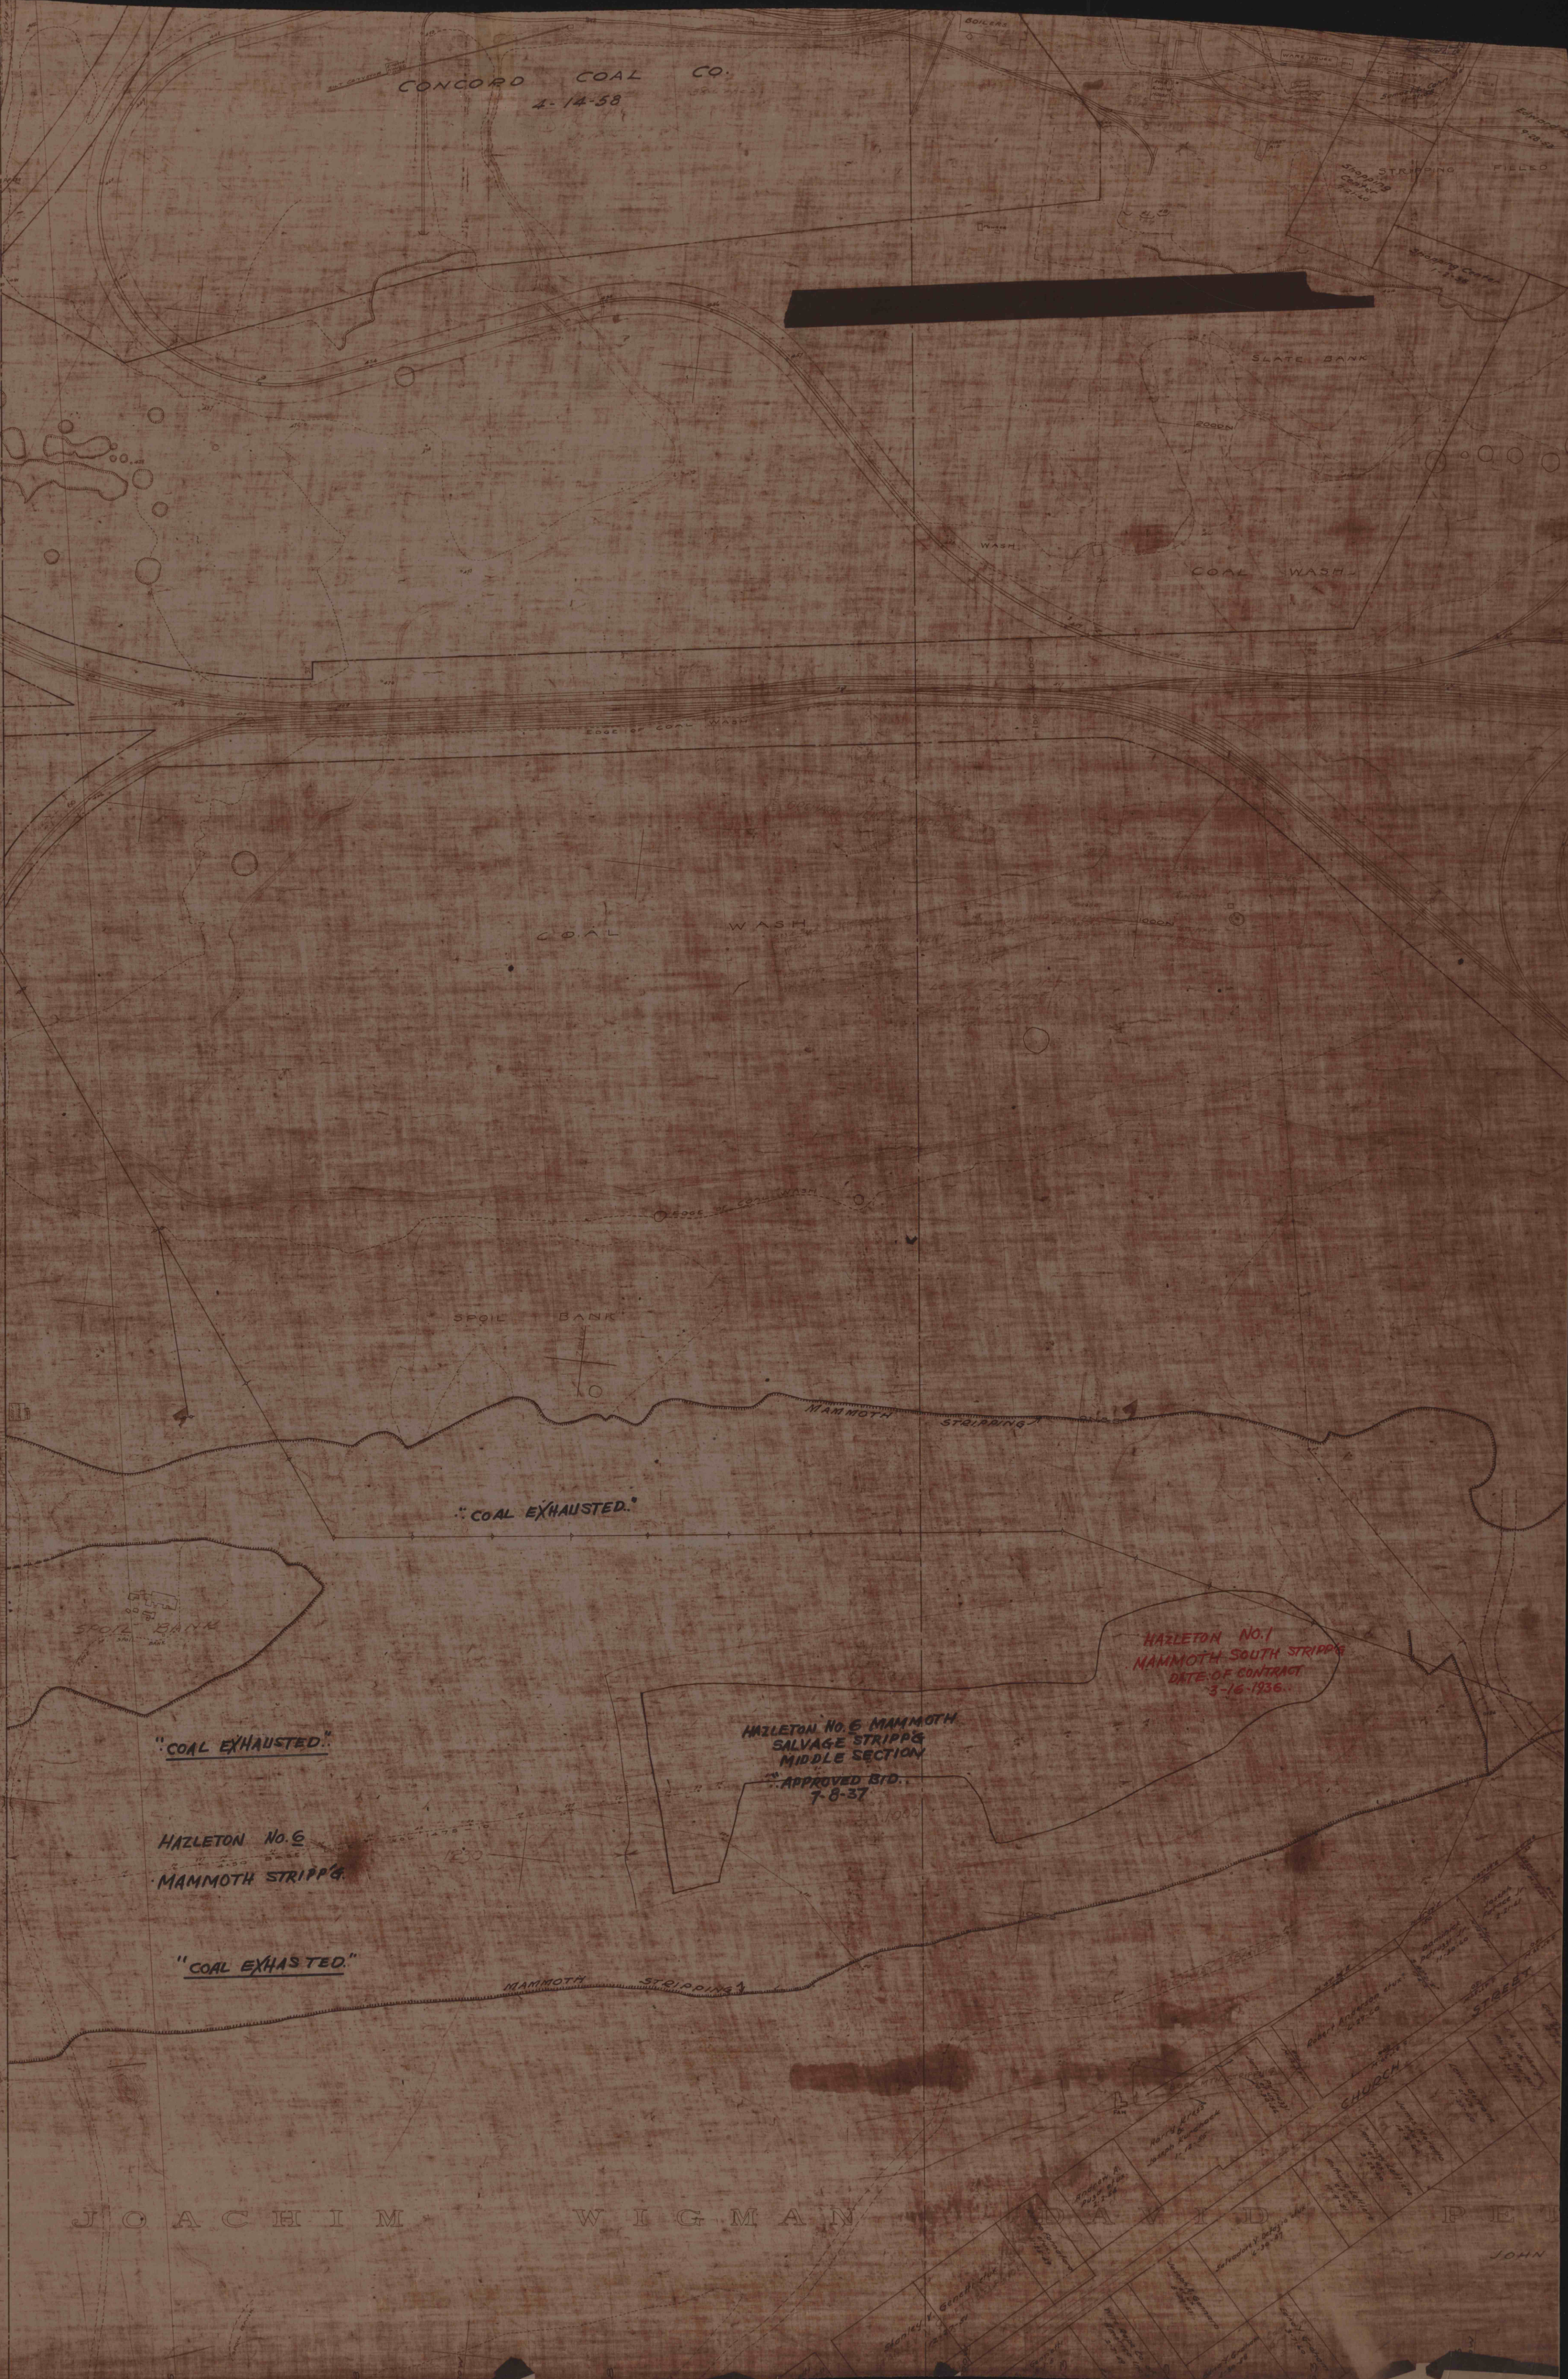

JOACHIM WIGMAN DAVID PET