


O'BRIEN #7 VIEW

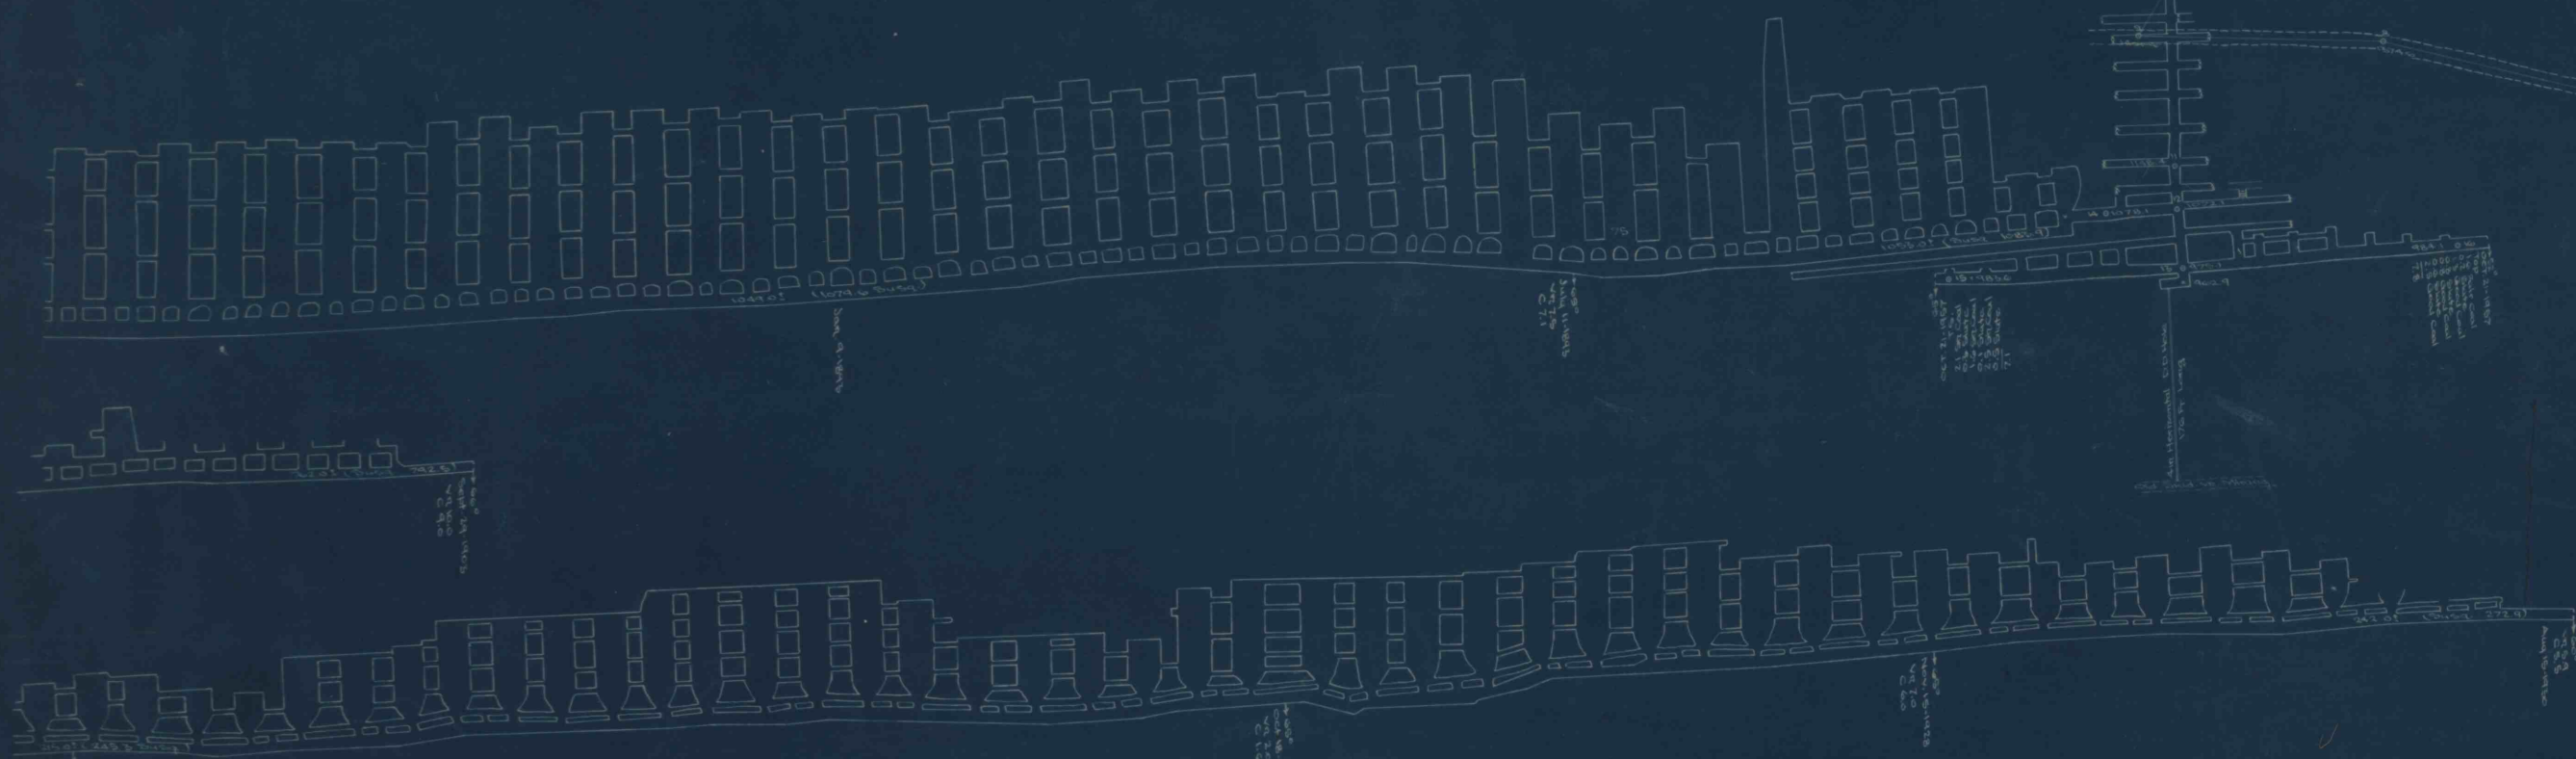

R A N D A L L I N T.

W I L S O N C O A L C O.