


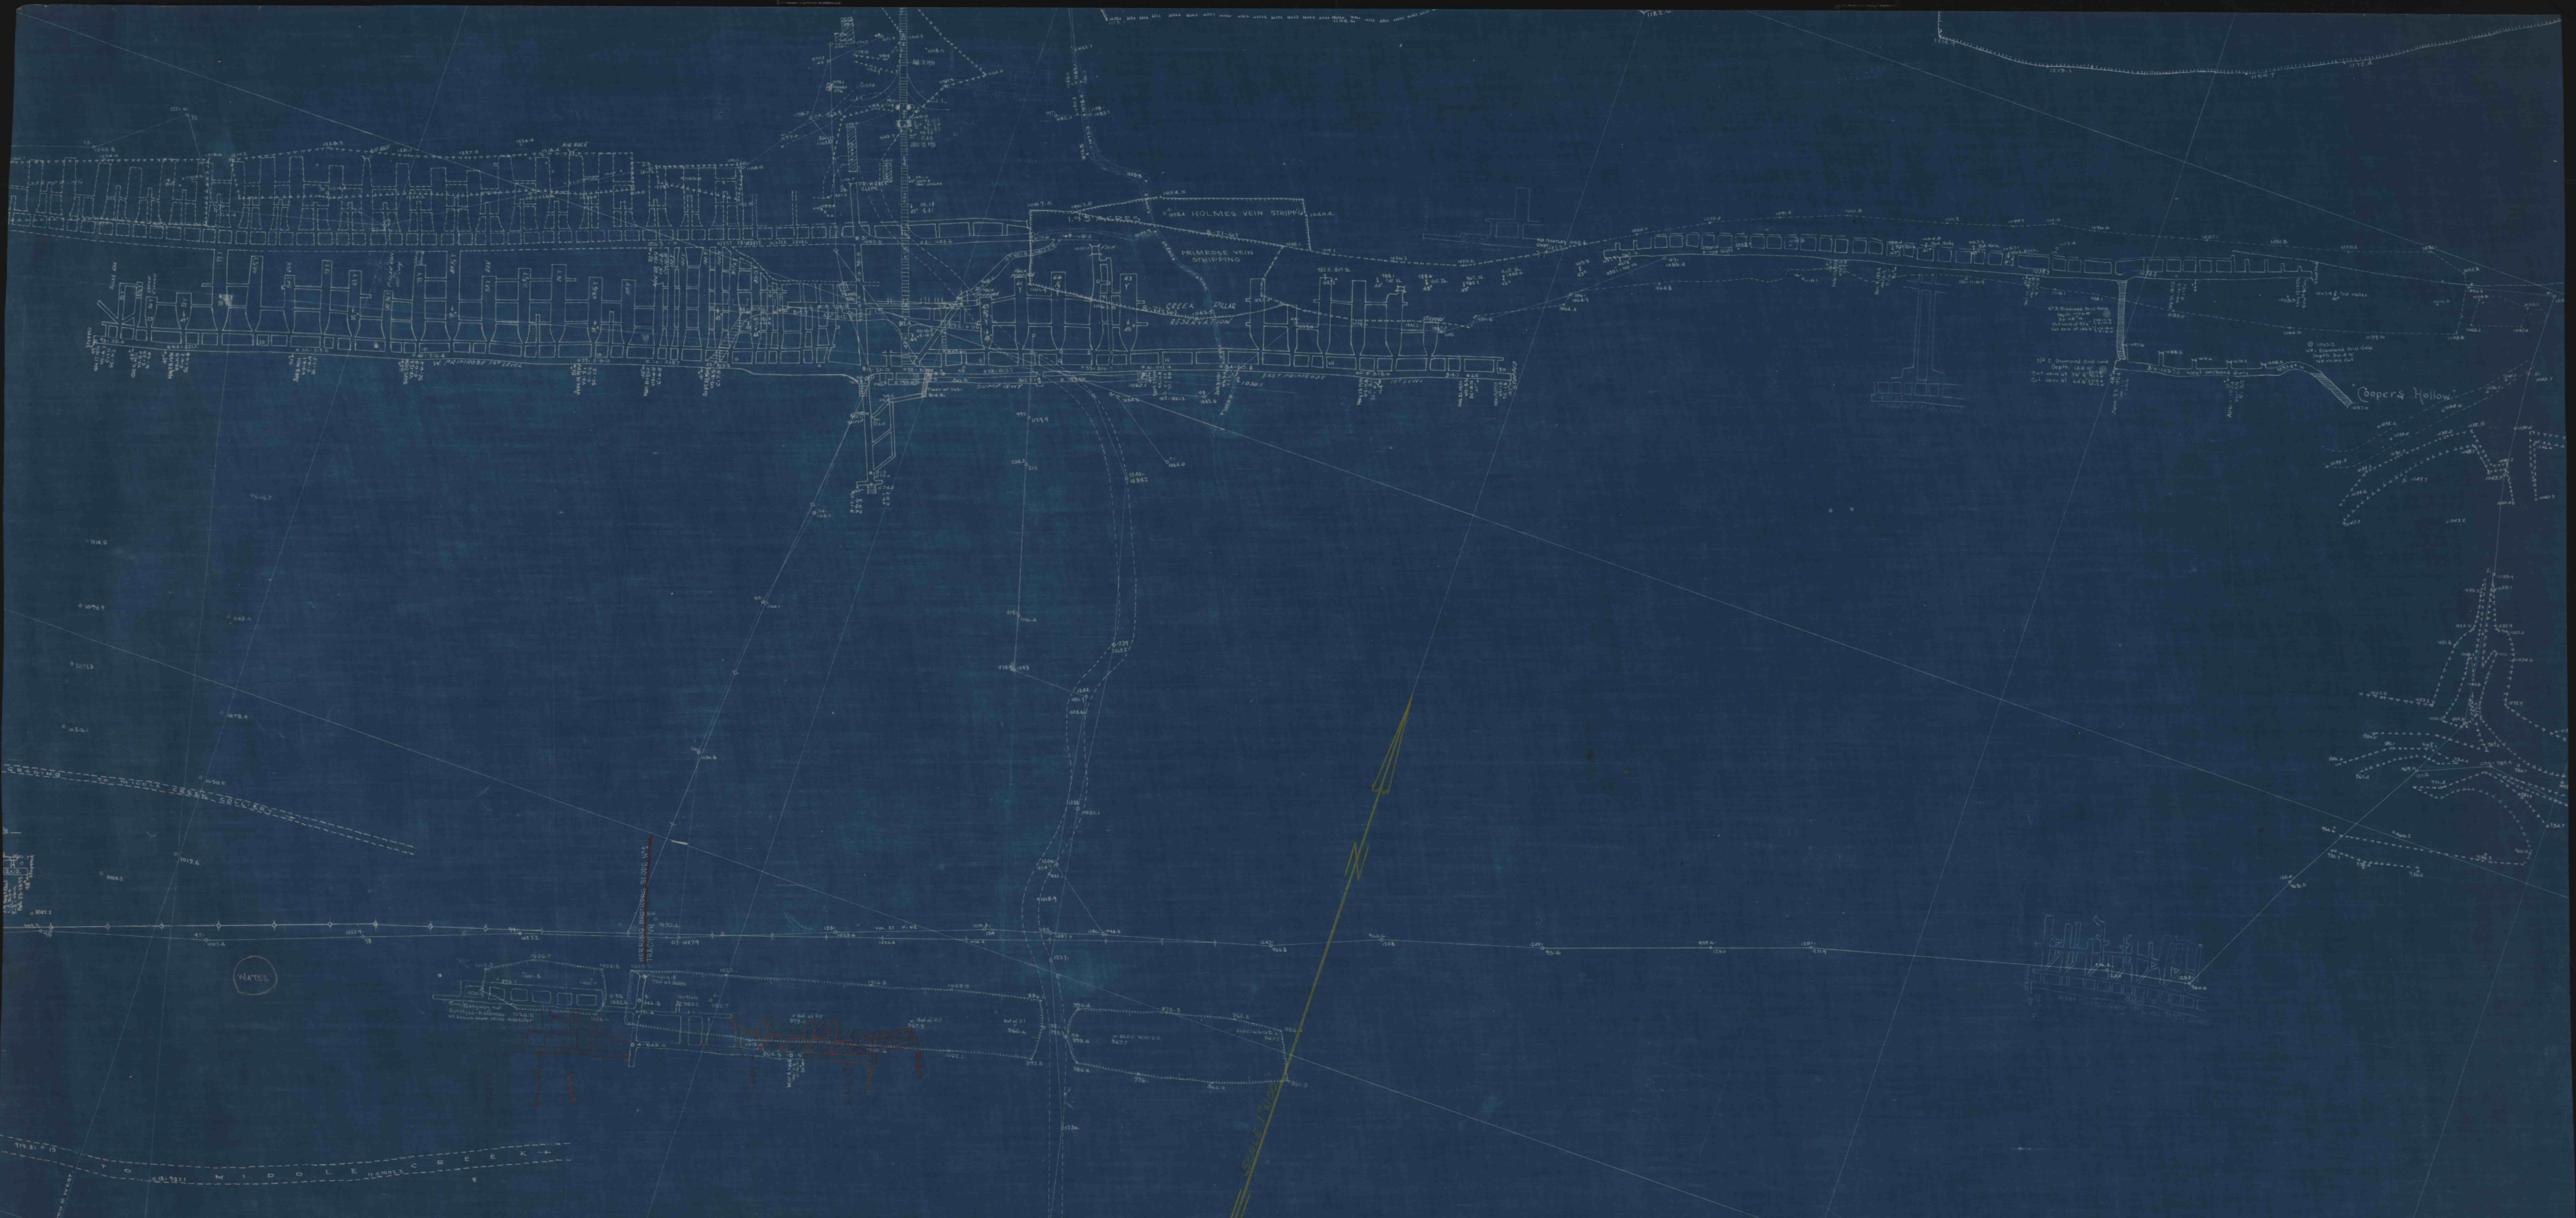

—MAP—
SHOWING HERRING BROTHERS SLOPE
ON THE RACE VEIN, SOUTH DIP.
SCALE 1"=100' MAR. 8, 1968.
G. GURKAN, ENGR.

