


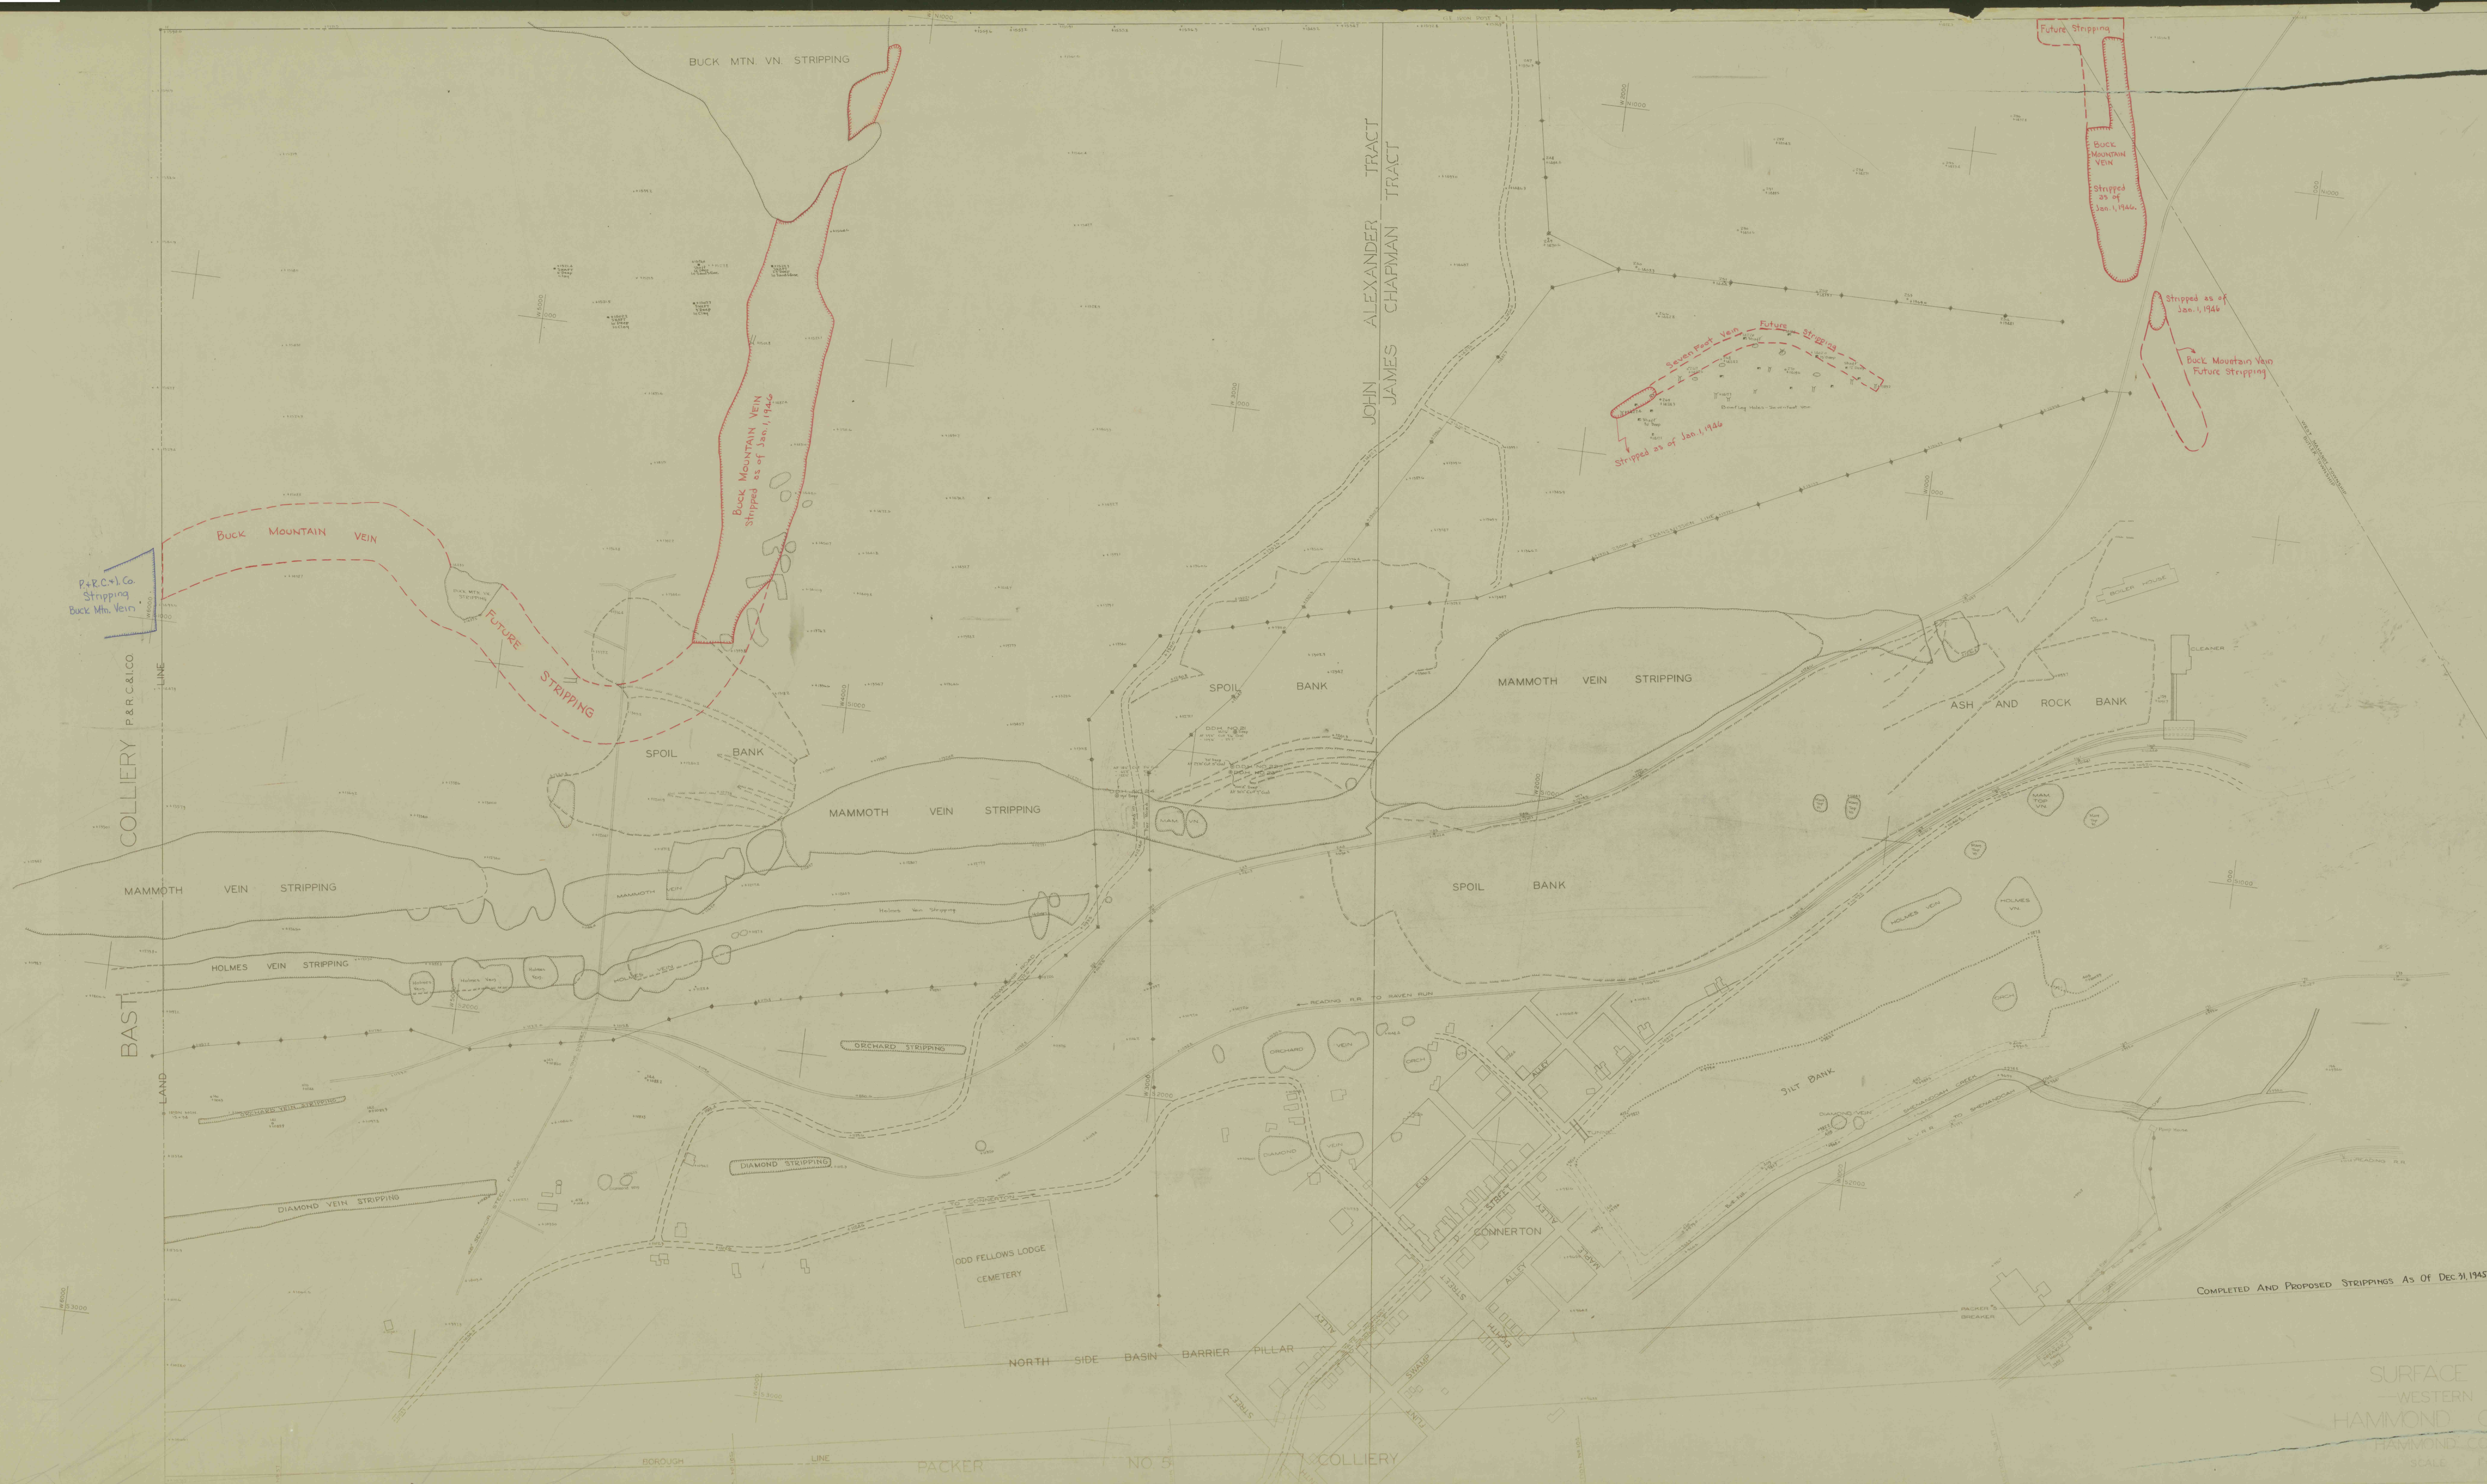

Hammond Colliery
Hammond Coal Co.

SURFACE MAP
-WESTERN END-
HAMMOND COLLIERY
HAMMOND COAL CO.
SCALE 1" = 100'