


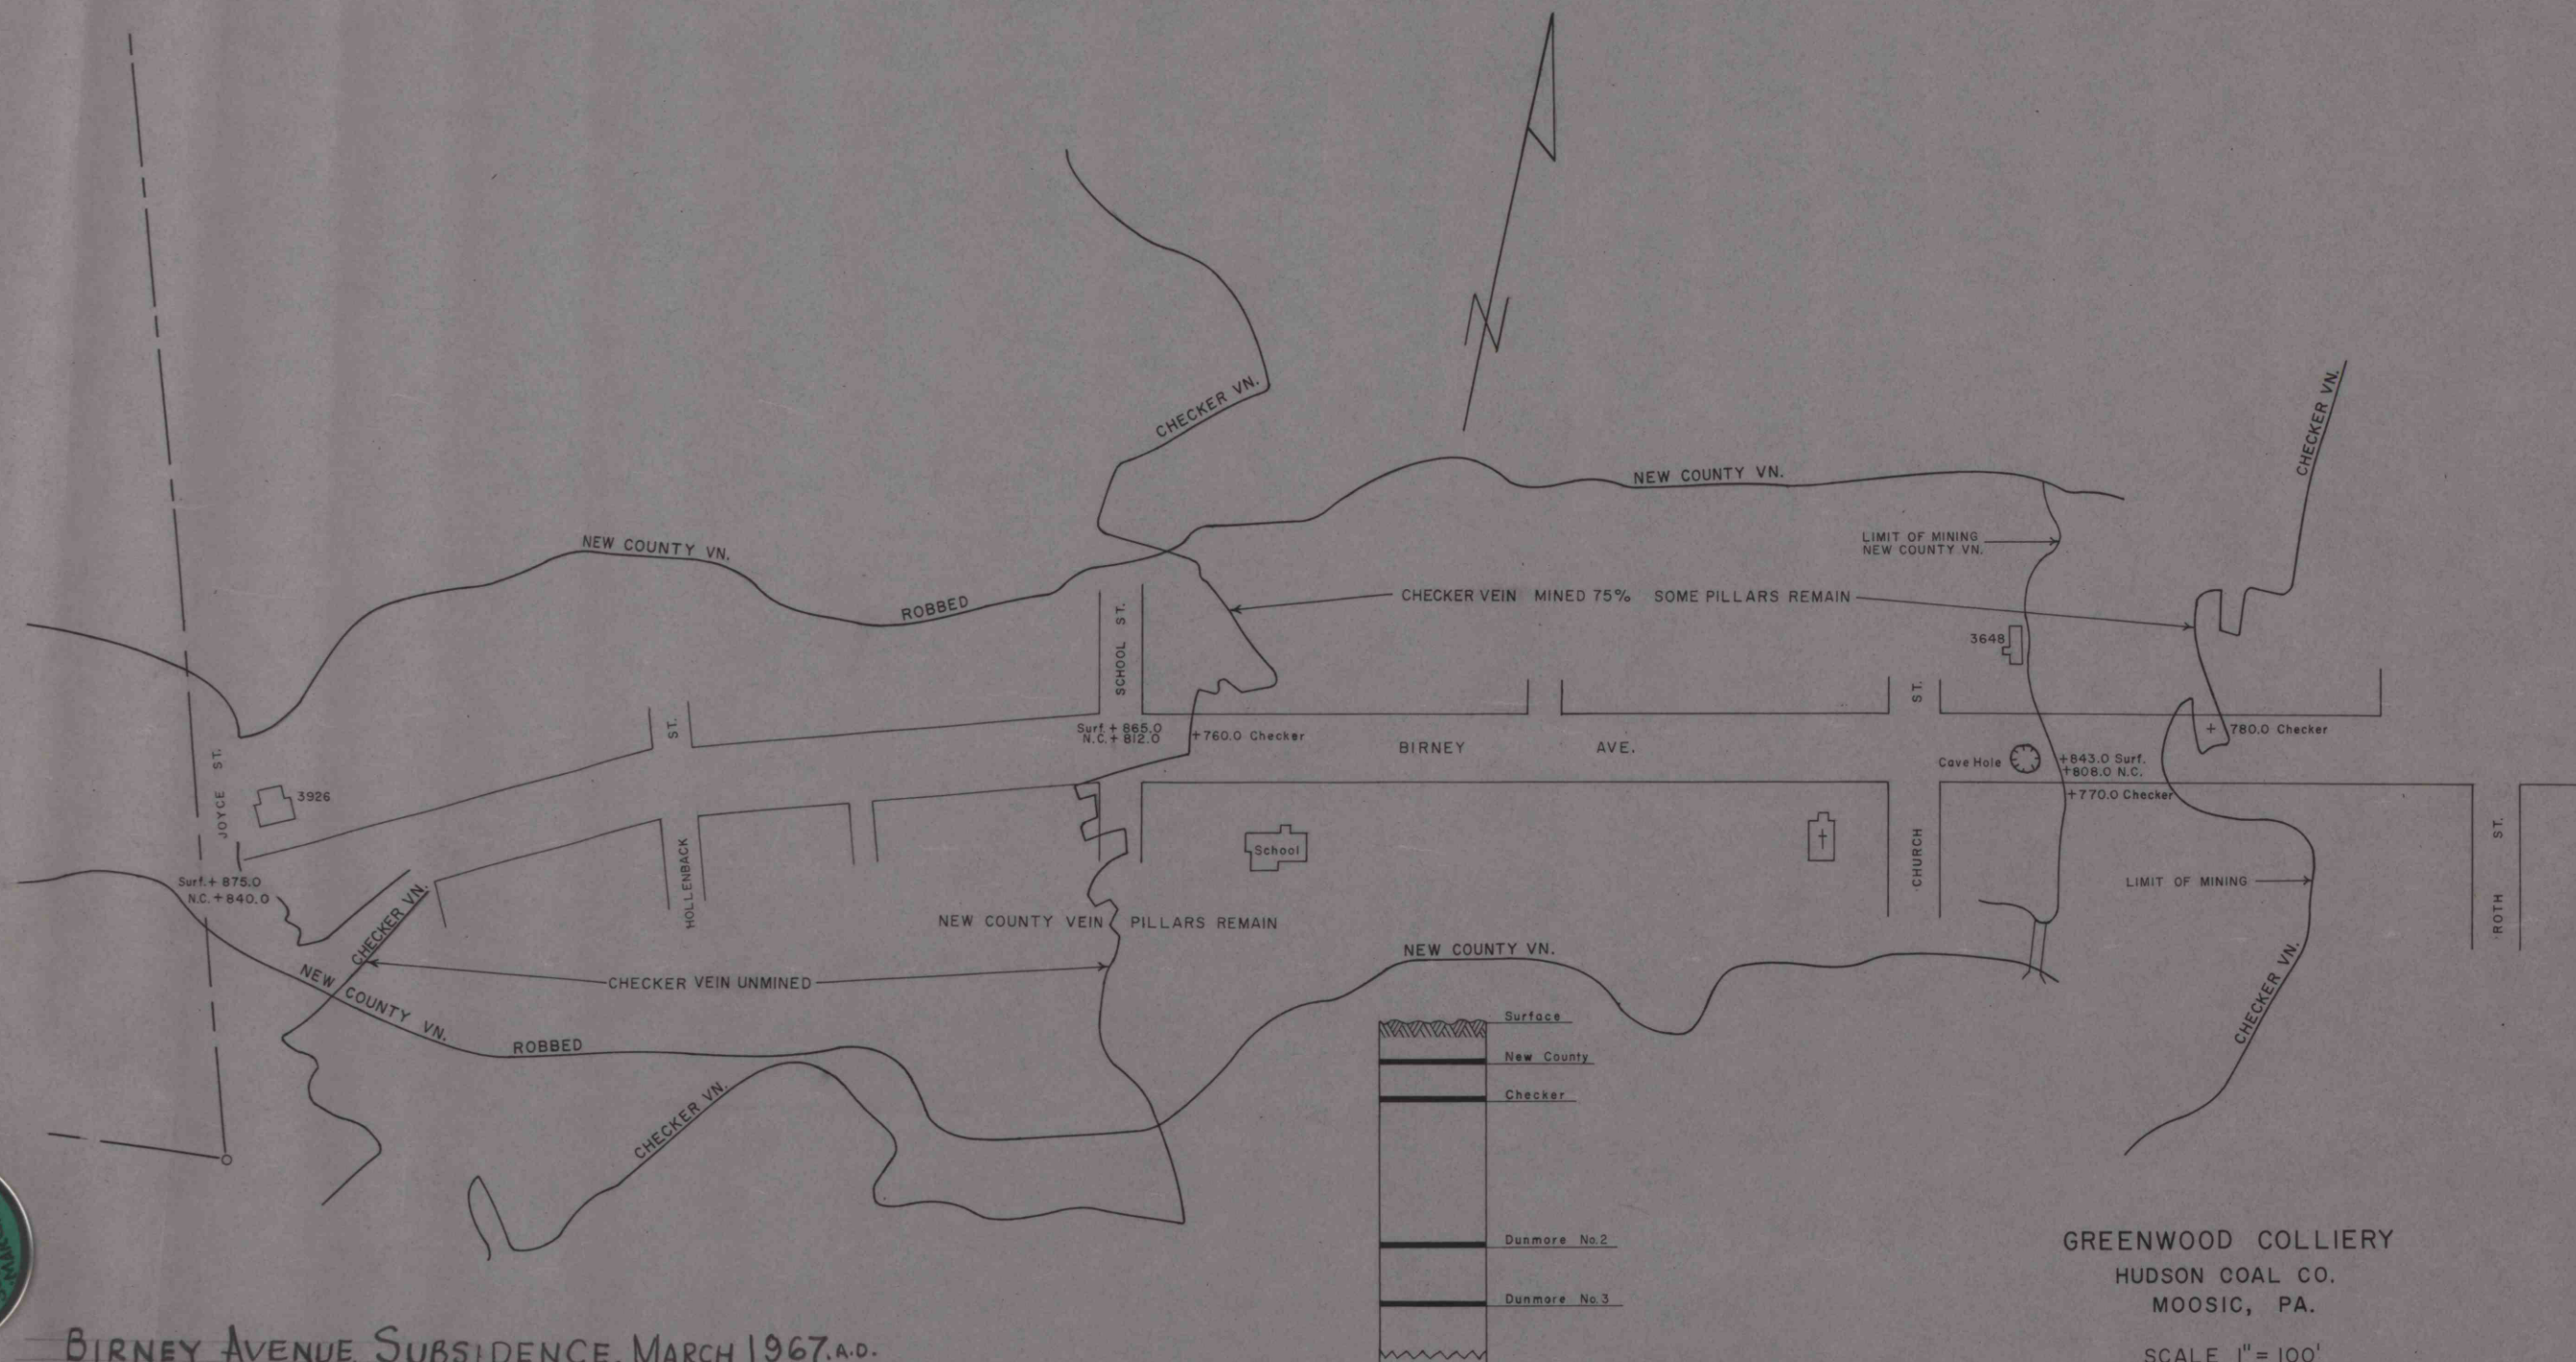

BIRNEY AVENUE, SUBSIDENCE. MARCH 1967. A.D.

ME
MAR 19 1975

GREENWOOD COLLIERY
HUDSON COAL CO.
MOOSIC, PA.

SCALE 1" = 100'

MAR 19 1975