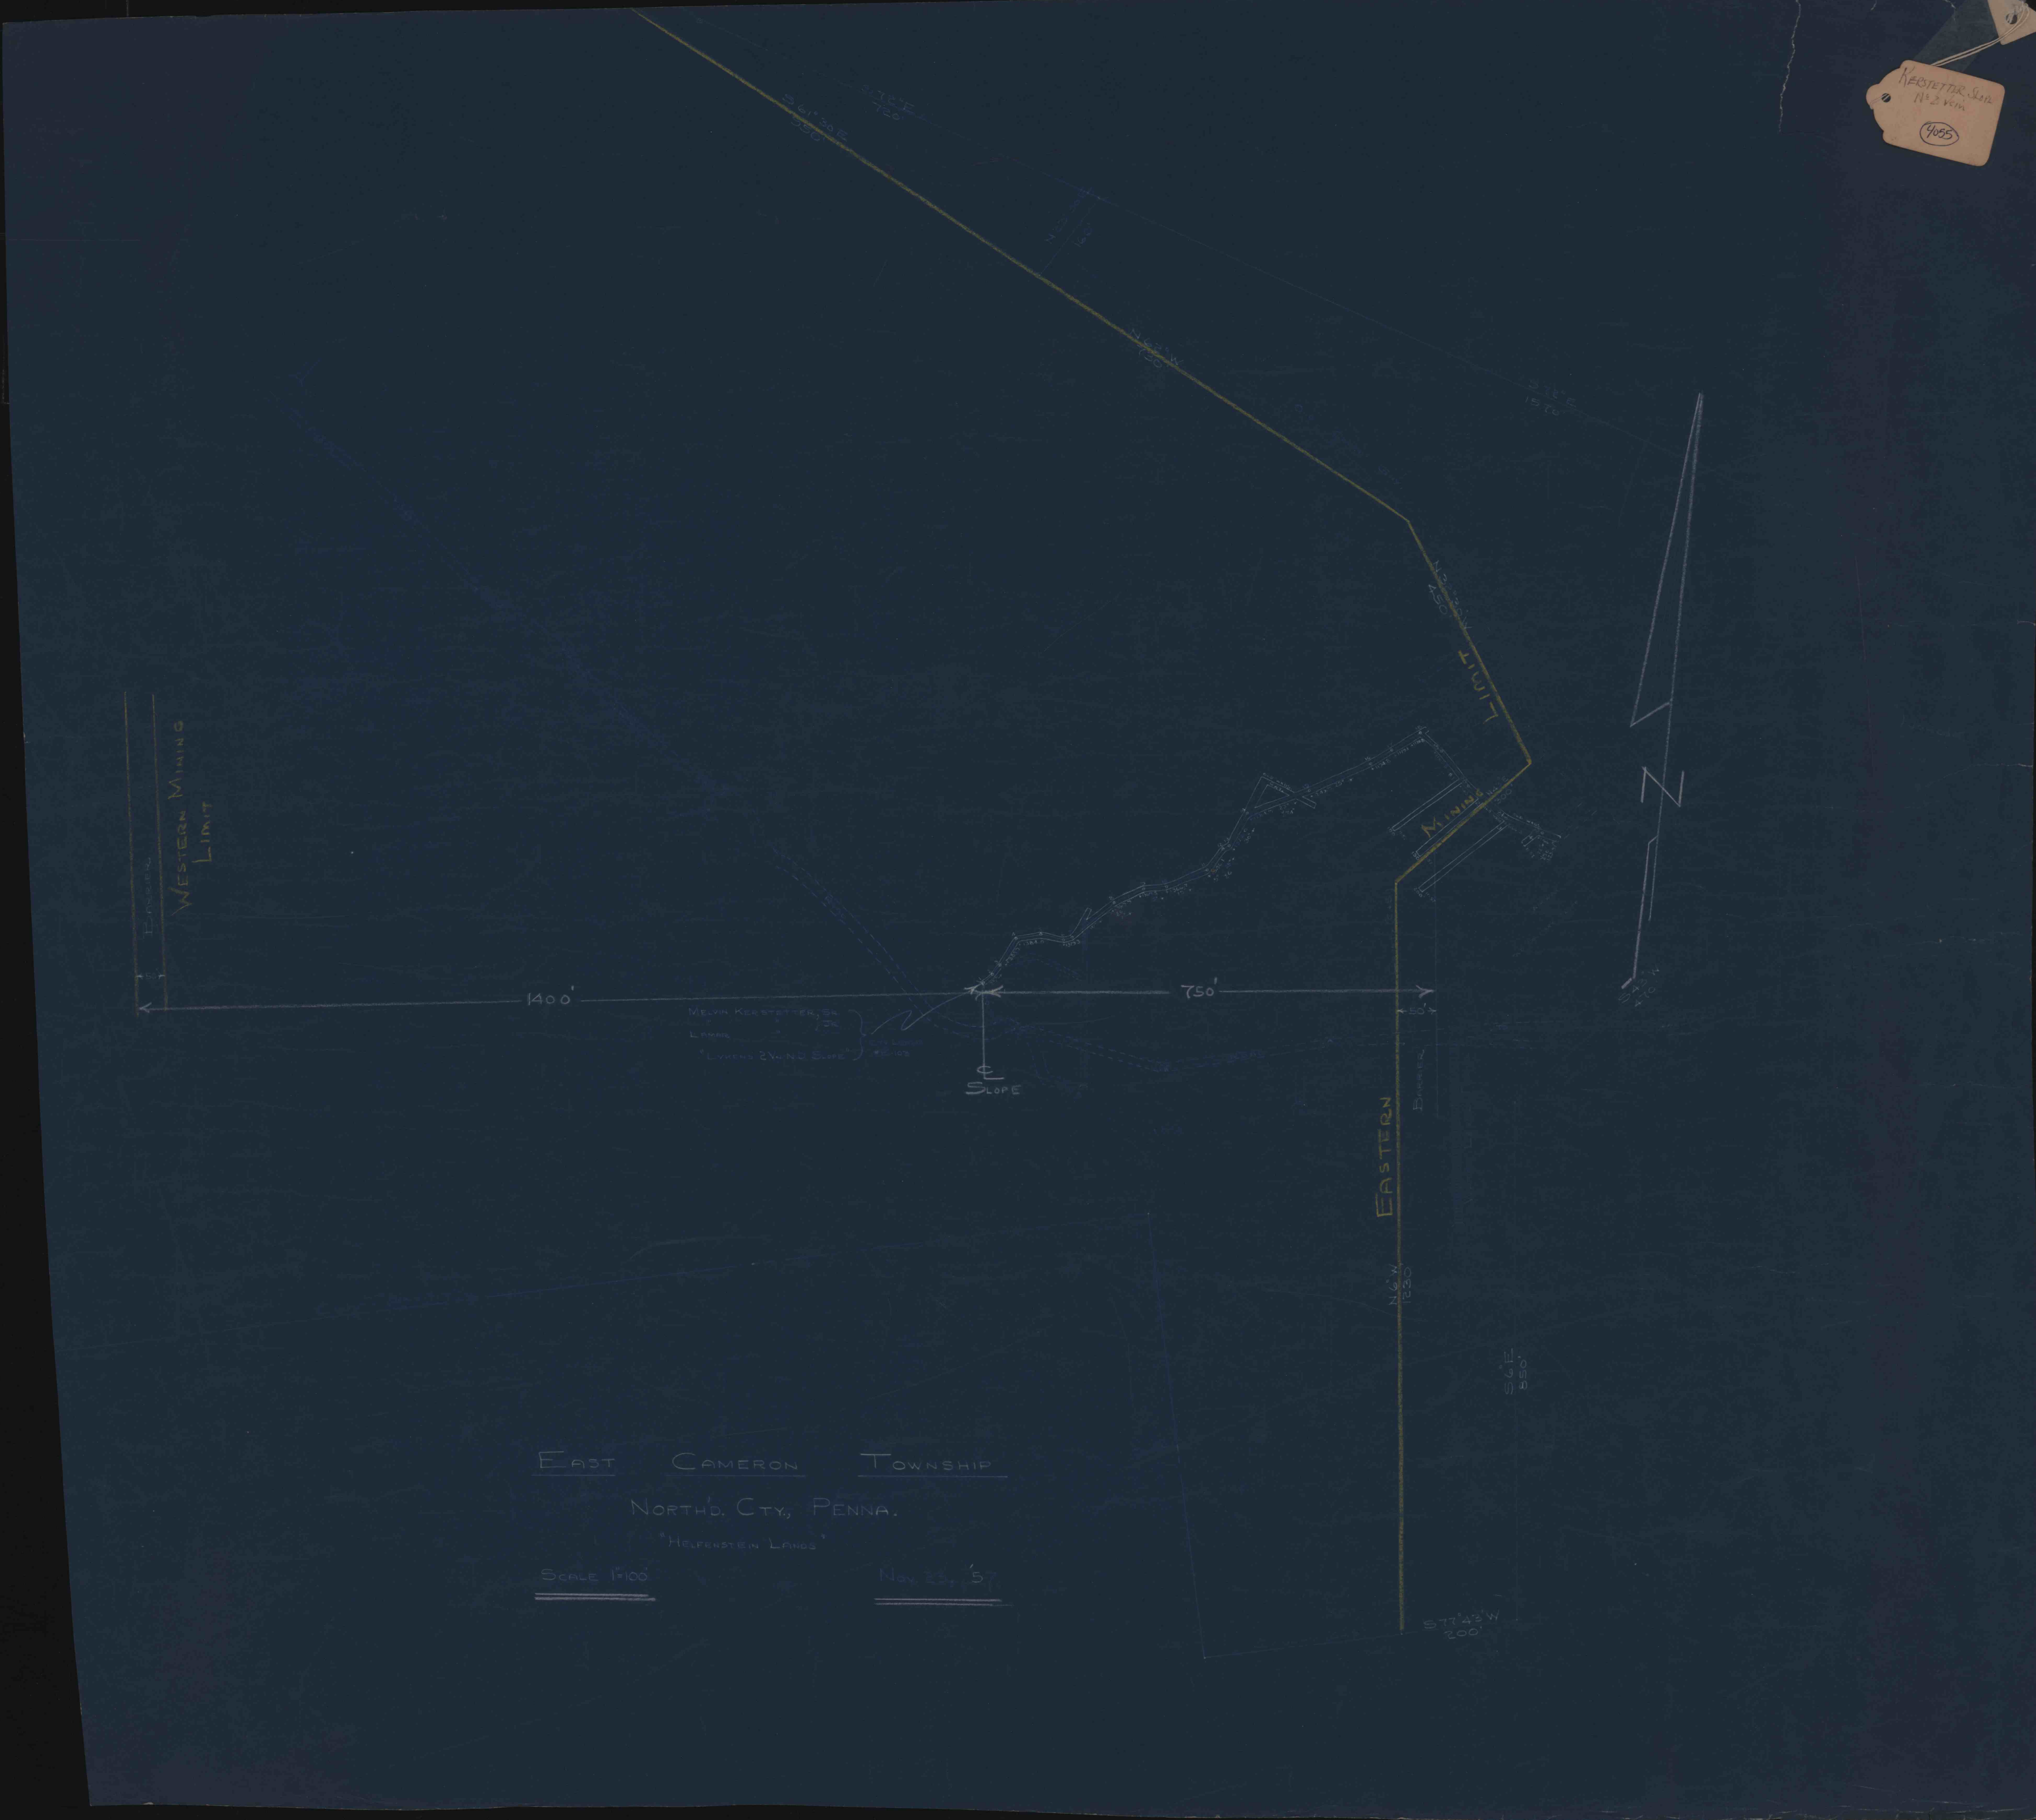
Western Mining Limit
Eastern Mining Limit
1400'
750'
Slope
East Cameron Township
North'd. Cty., Penna.
"Helfenstein Lands"
Scale 1"=100'
Nov. 23, '57
Kerstetter Slope
No 2 Vein
4055