



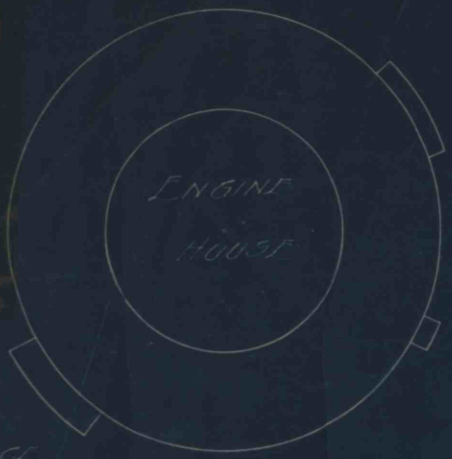

P&R C & I. Co.
1100 As Surface
Non Eastern Realty Co.

southern file # 1"=100'
George Kripas..Ind. workings-
Peach Mt., South-dip, west
of Schoentown, Schuylkill
county pa. 20 sept. 1954.
reprint small.
4056

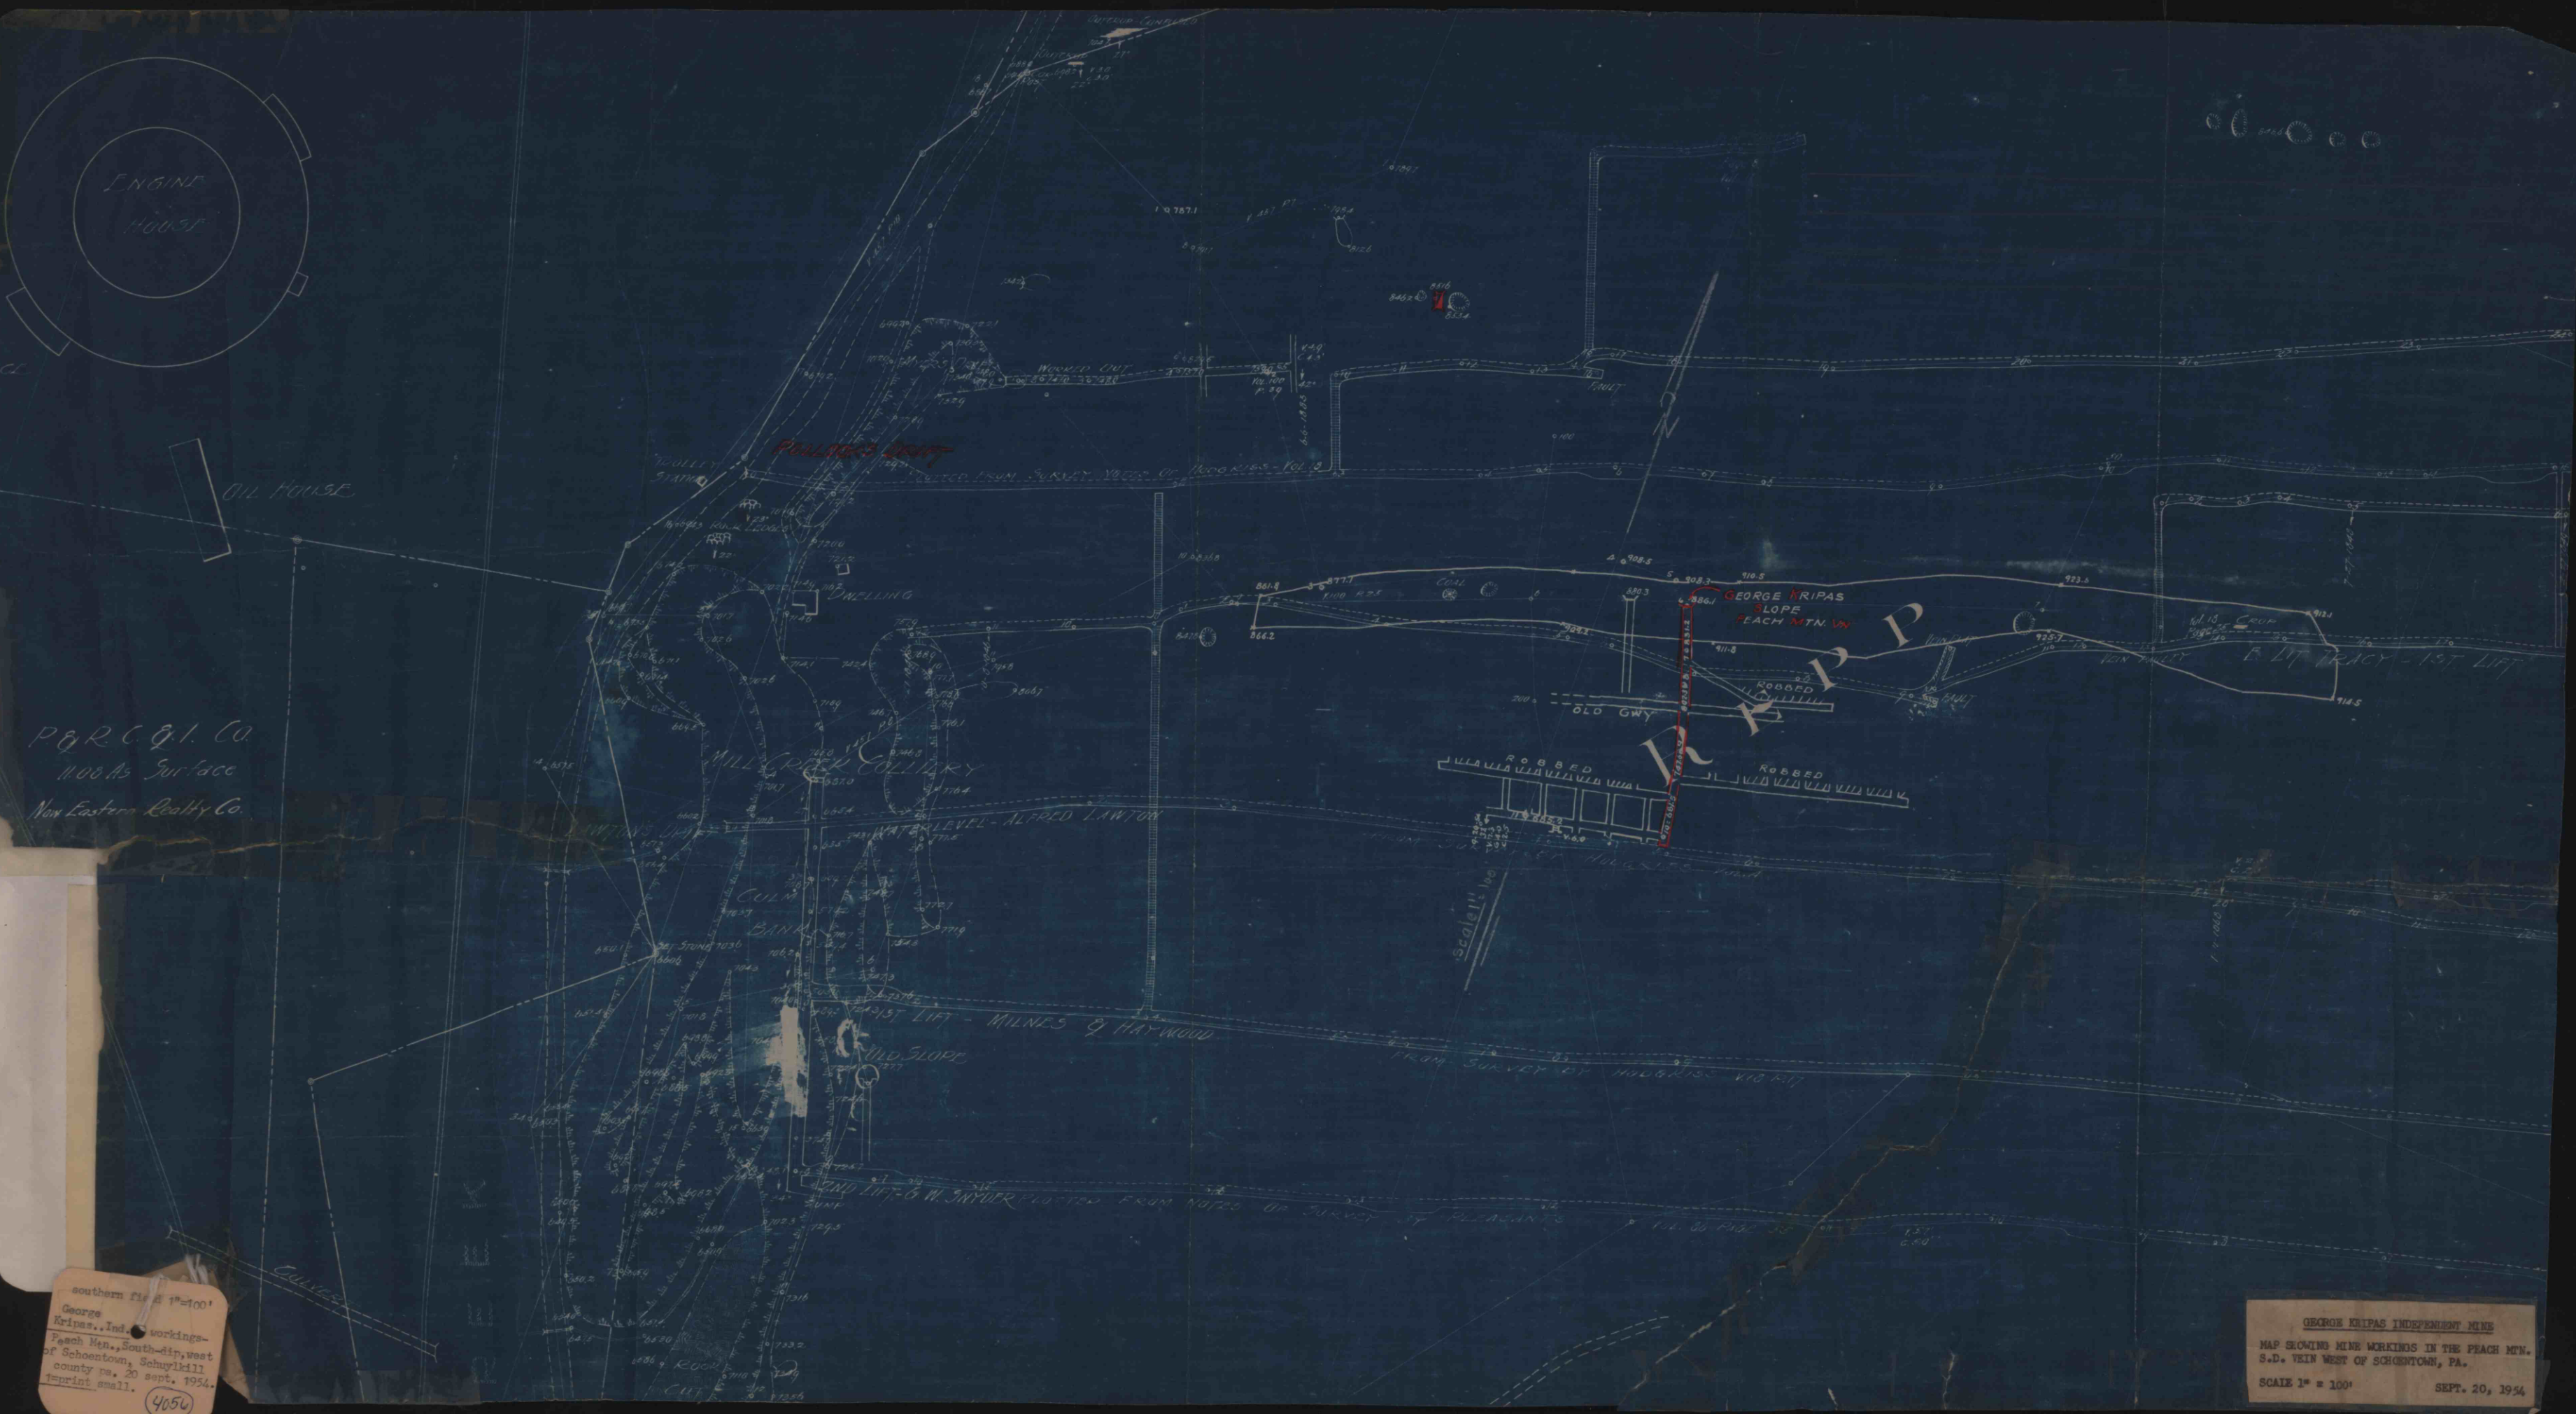

GEORGE KRIPAS INDEPENDENT MINE
MAP SHOWING MINE WORKINGS IN THE PEACH MTN.
S.D. VEIN WEST OF SCHOENTOWN, PA.
SCALE 1" = 100' SEPT. 20, 1954