


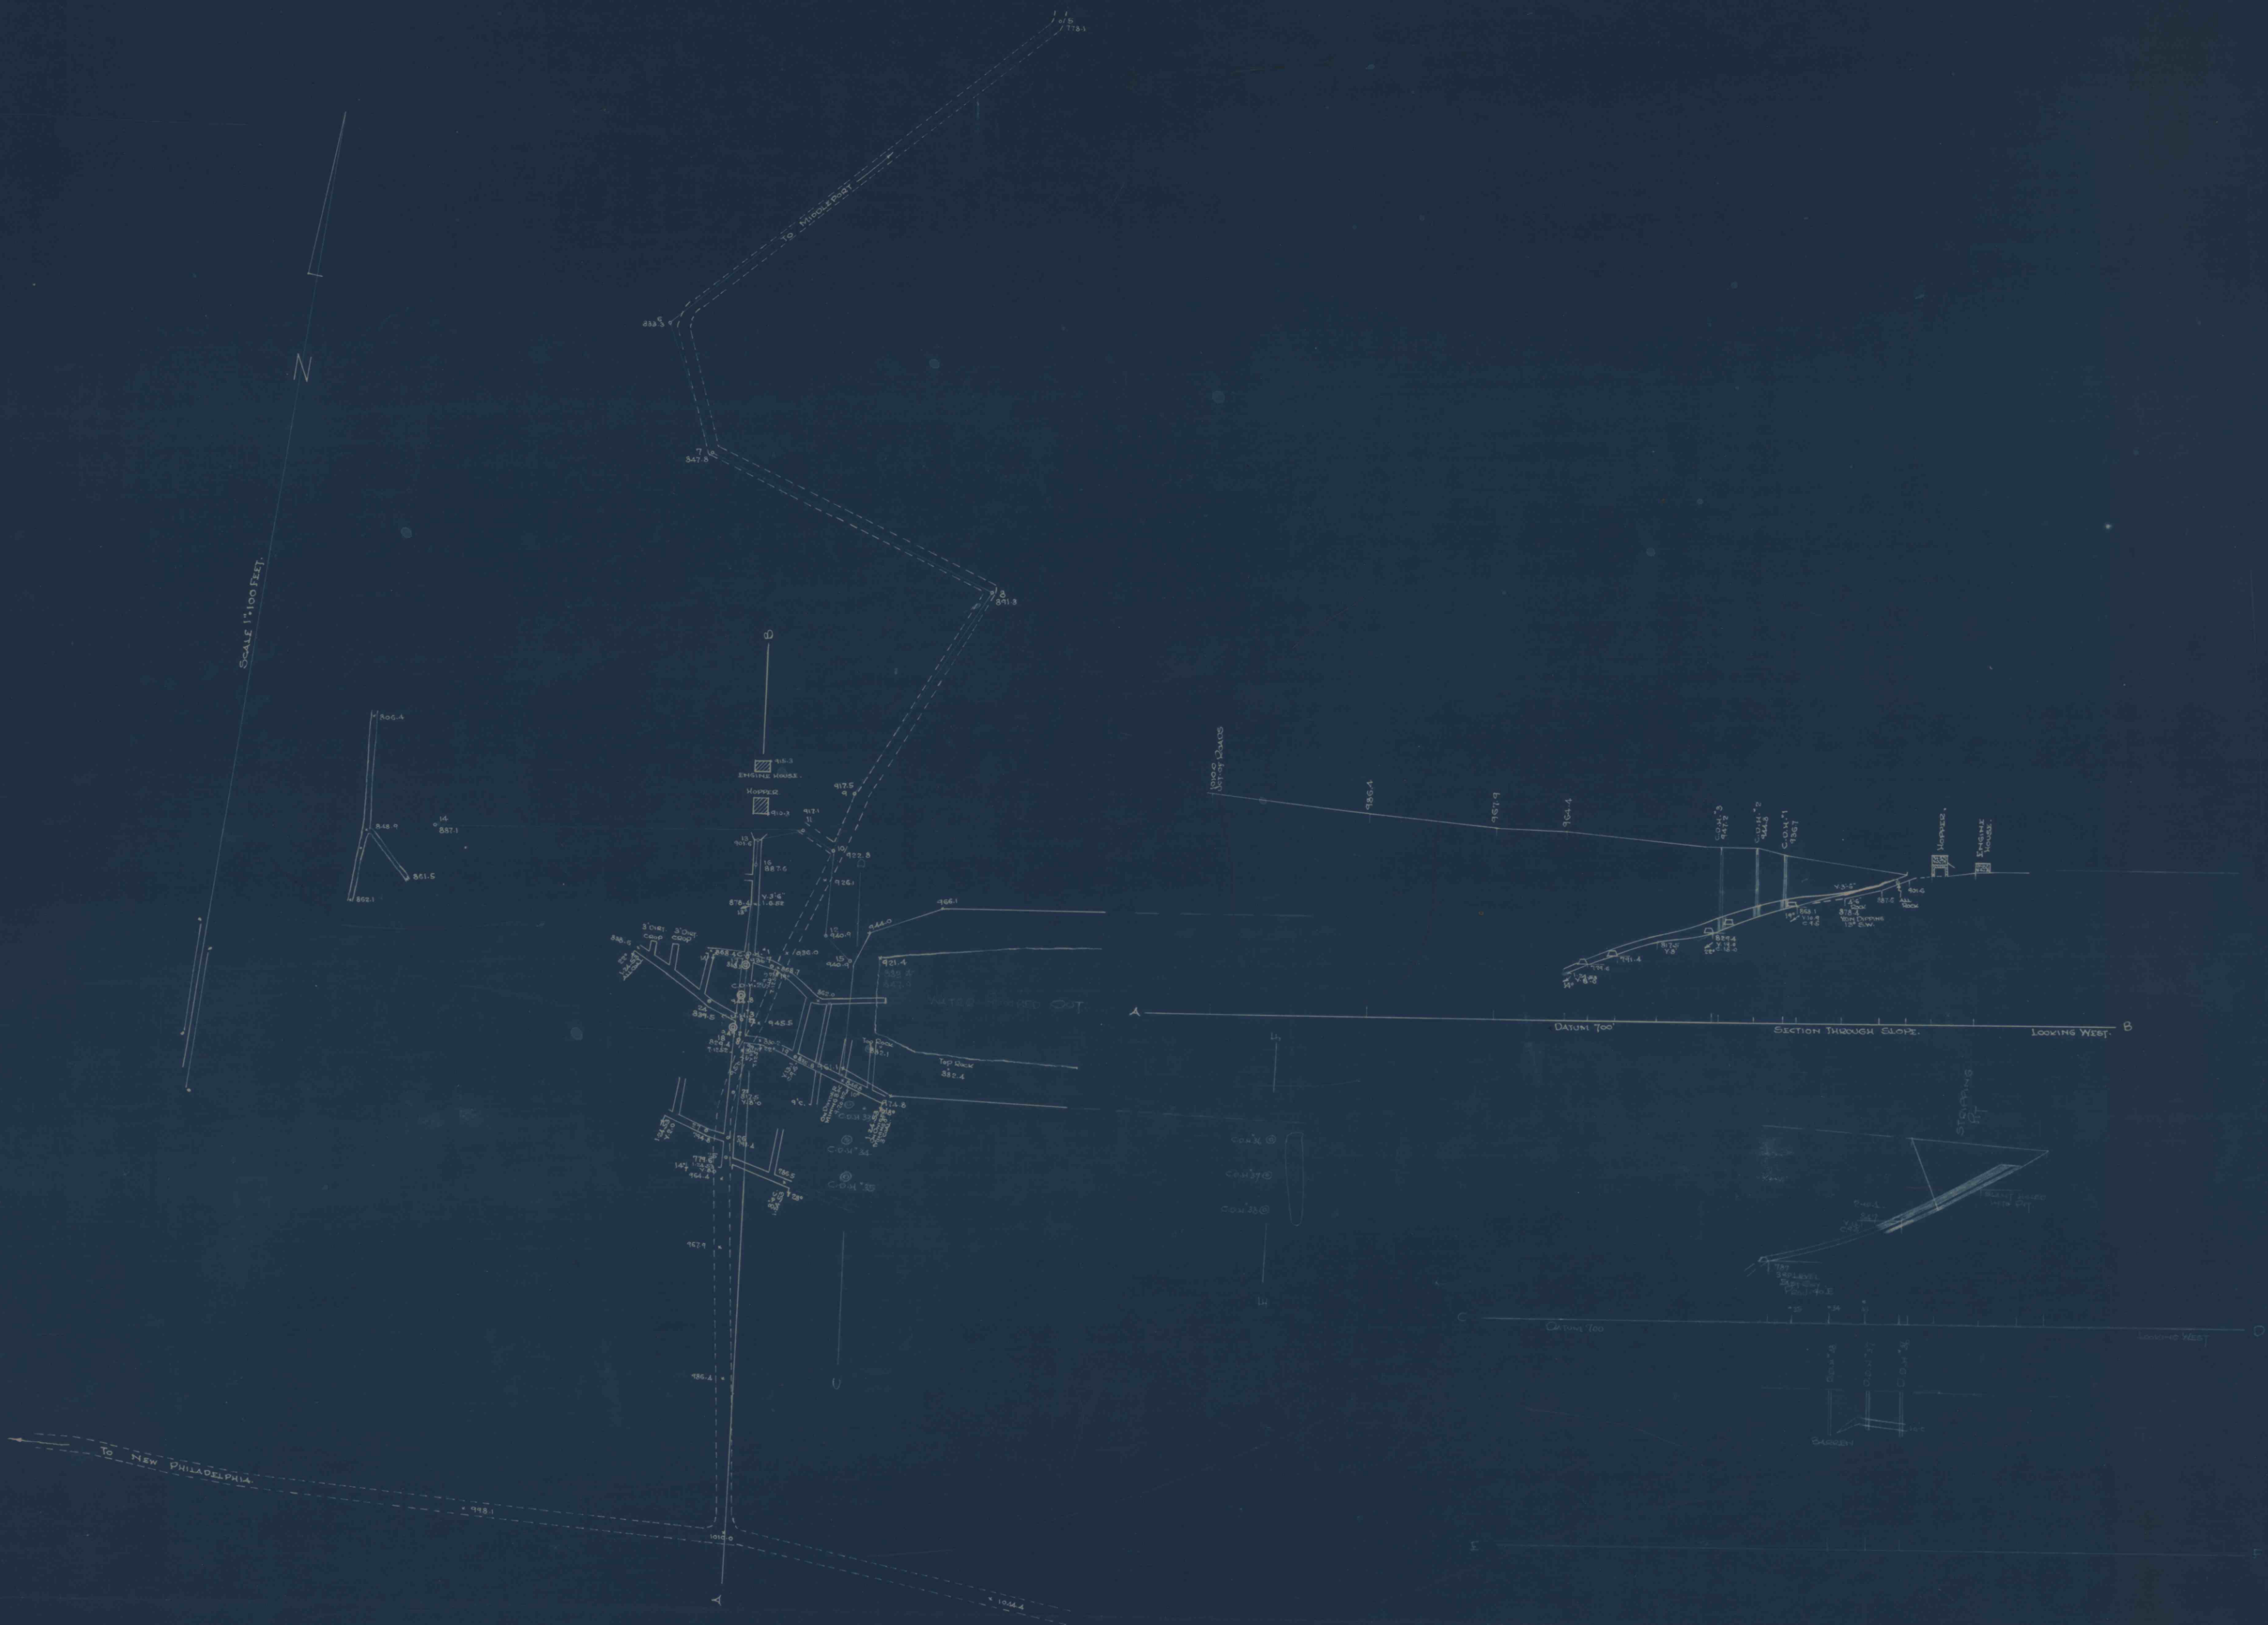

..SOUTHERN FIELD..
BLYTHE Twp., SCHUYLKILL Co.,
14 E. SCHUYLKILL DISTRICT.

PLAN AND SECTION SHOWING MINE WORKINGS OF SLOPE,
AND SURFACE FEATURES OF SAME (OWNED BY STEVE
AND ANDY CUTLER) LOCATED SOUTH OF MIDDLEPORT,
SCHUYLKILL COUNTY, PENNSYLVANIA.

JANUARY 6, 1952. SCALE 1"=100 FEET.
JULY 15, 1952.
SEP. 20, 1955.
JUN. 24, 1958.

southern field 1"=100'
CUTLER, Jan. 6, 1952.
Cutler, Steve plan & section
mine workings-surface-
features-of same-Blythe
tp., schuylkill county pa.
1:print.
(406)