


...SOUTHERN FIELD...
 DILAZZARO INDEPENDENT MINE
 MAP SHOWING MINE WORKINGS IN RELATION
 TO LAND-LINE
 JULY-1951 SCALE 1"=50'
 ELEVATION ASSUMED
 DEC. 13, 1955
 SCHUYLKILL COUNTY, PA.,
 DUTCH HOLLOW COAL
 MINERSVILLE BORO.,
 PEACH MTN.,

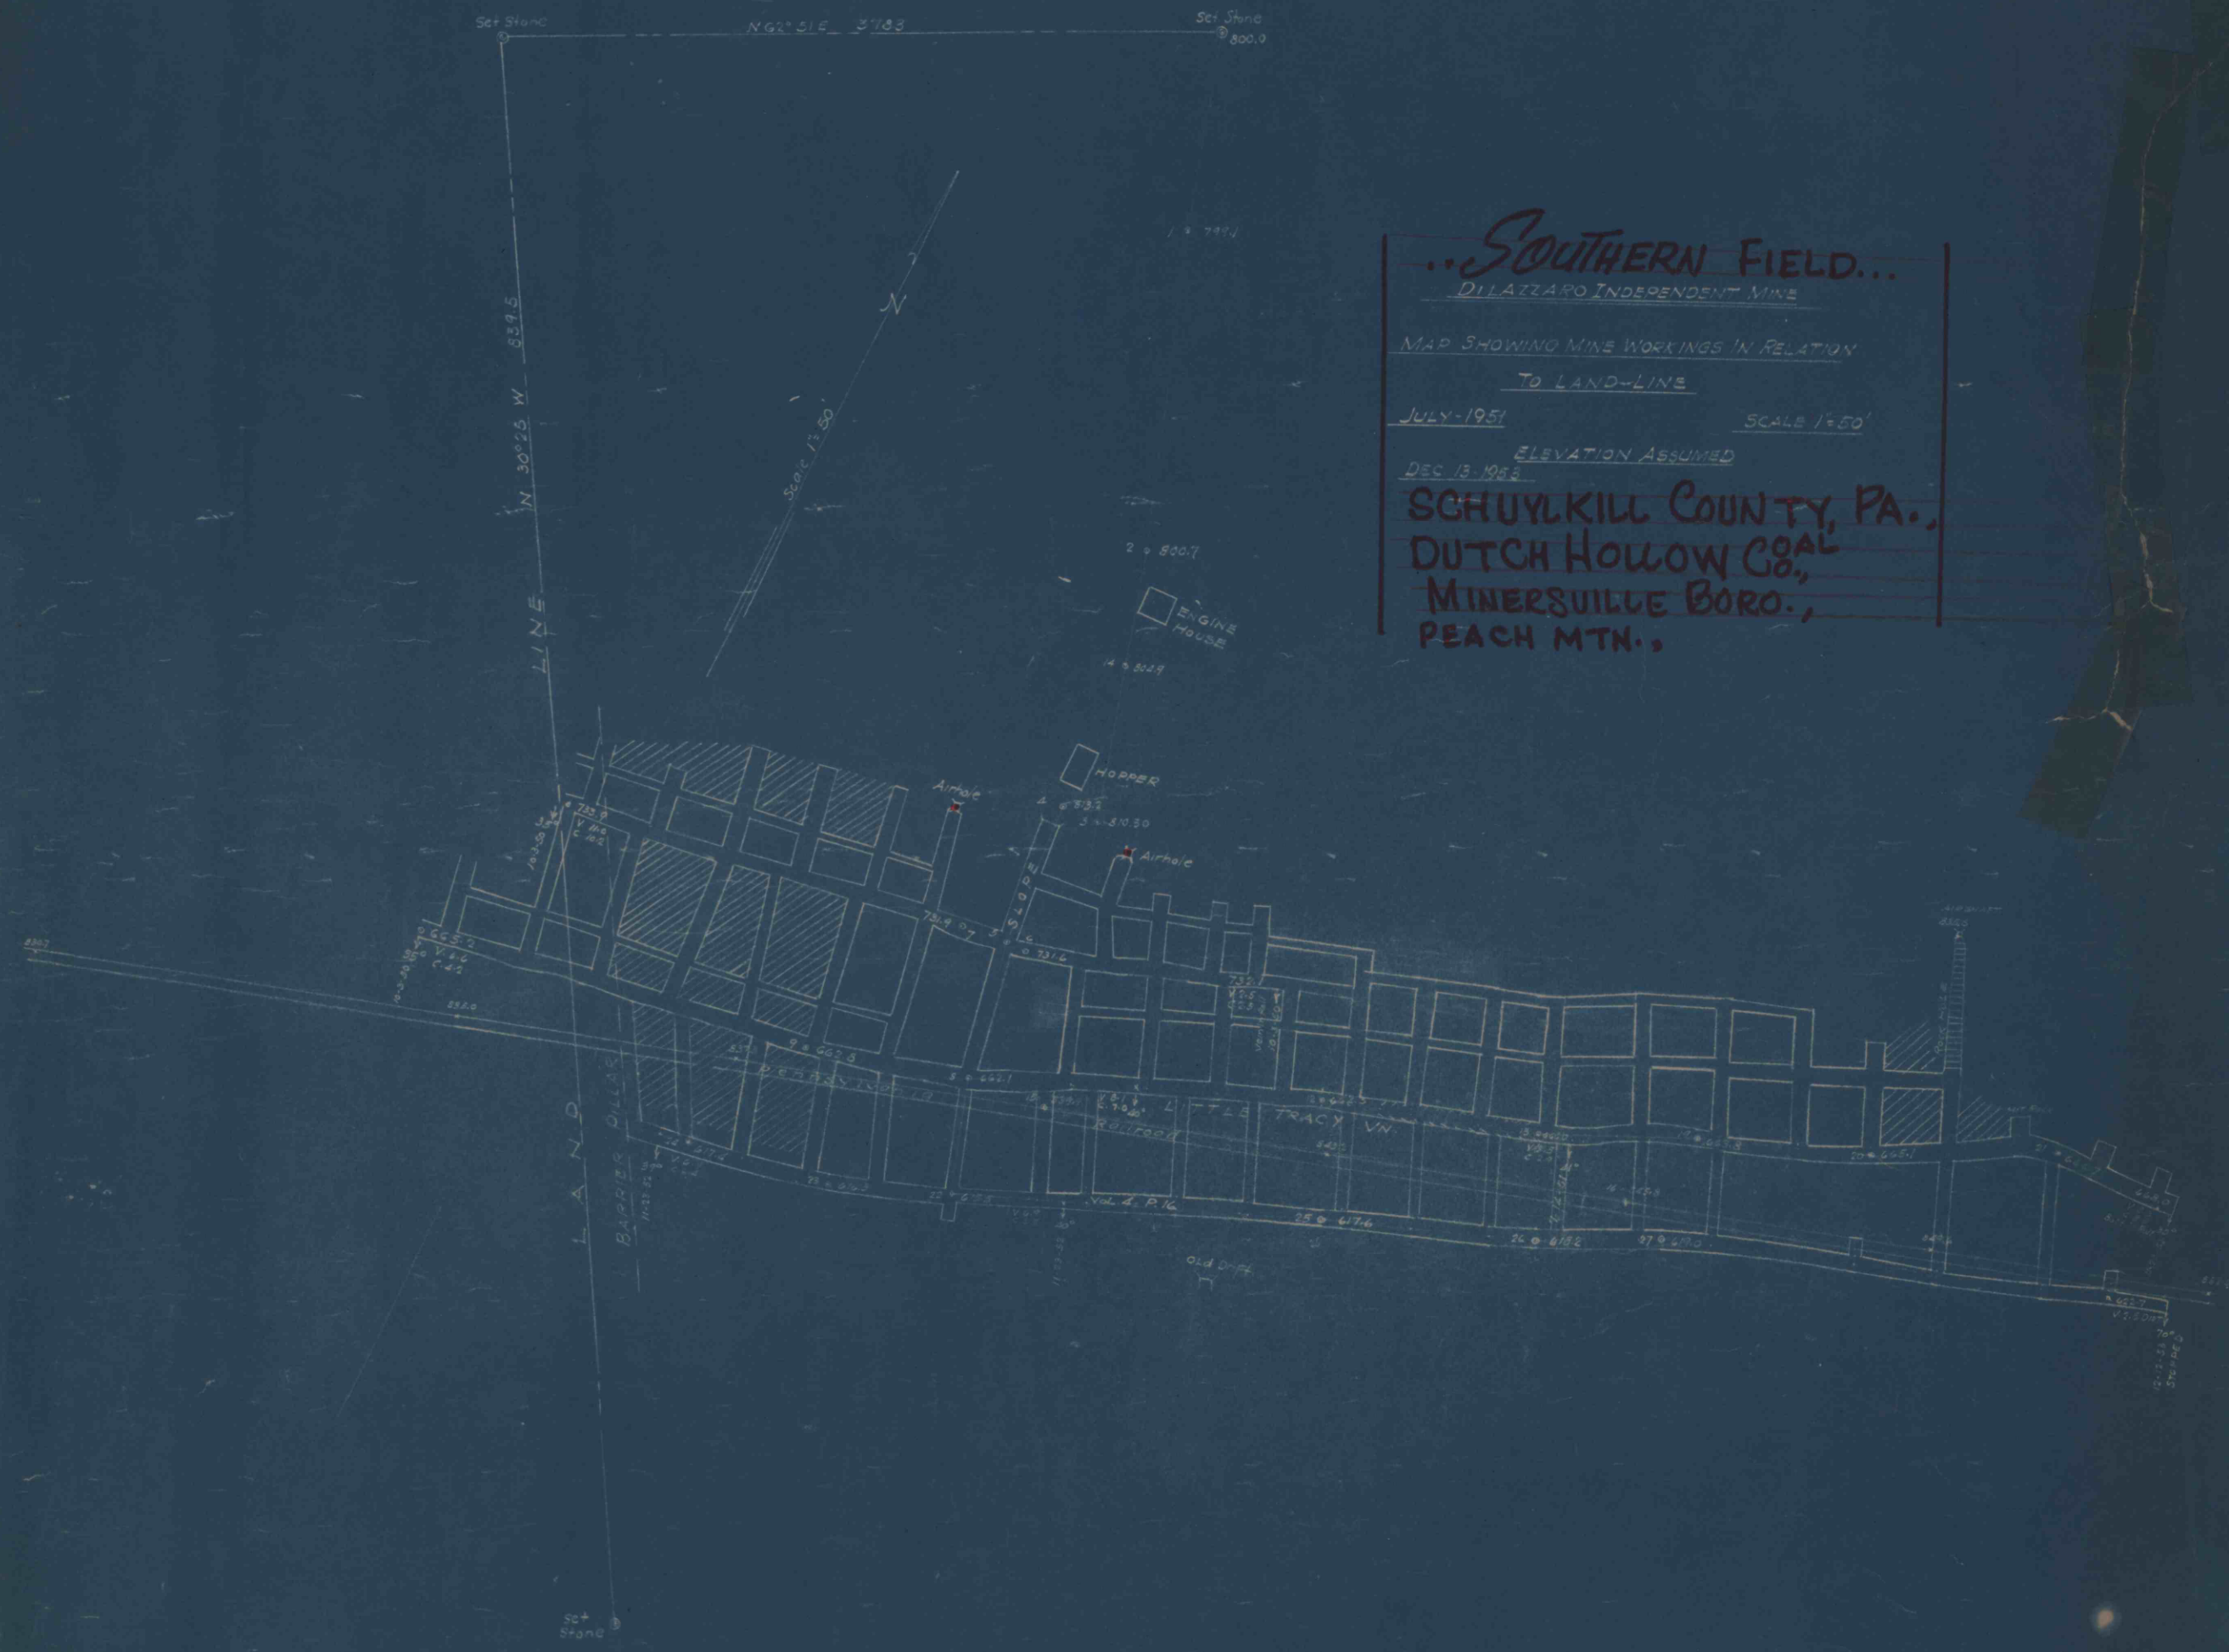

SOUTH FIELD
 1"=50'
 DILAZZARO
 INDEP. MINE
 JULY 1951
 LITTLE TRACY
 V. SCHUYLK. CO.
 PA. DUTCH HOLLOW
 COAL CO.
 T-PRINT