


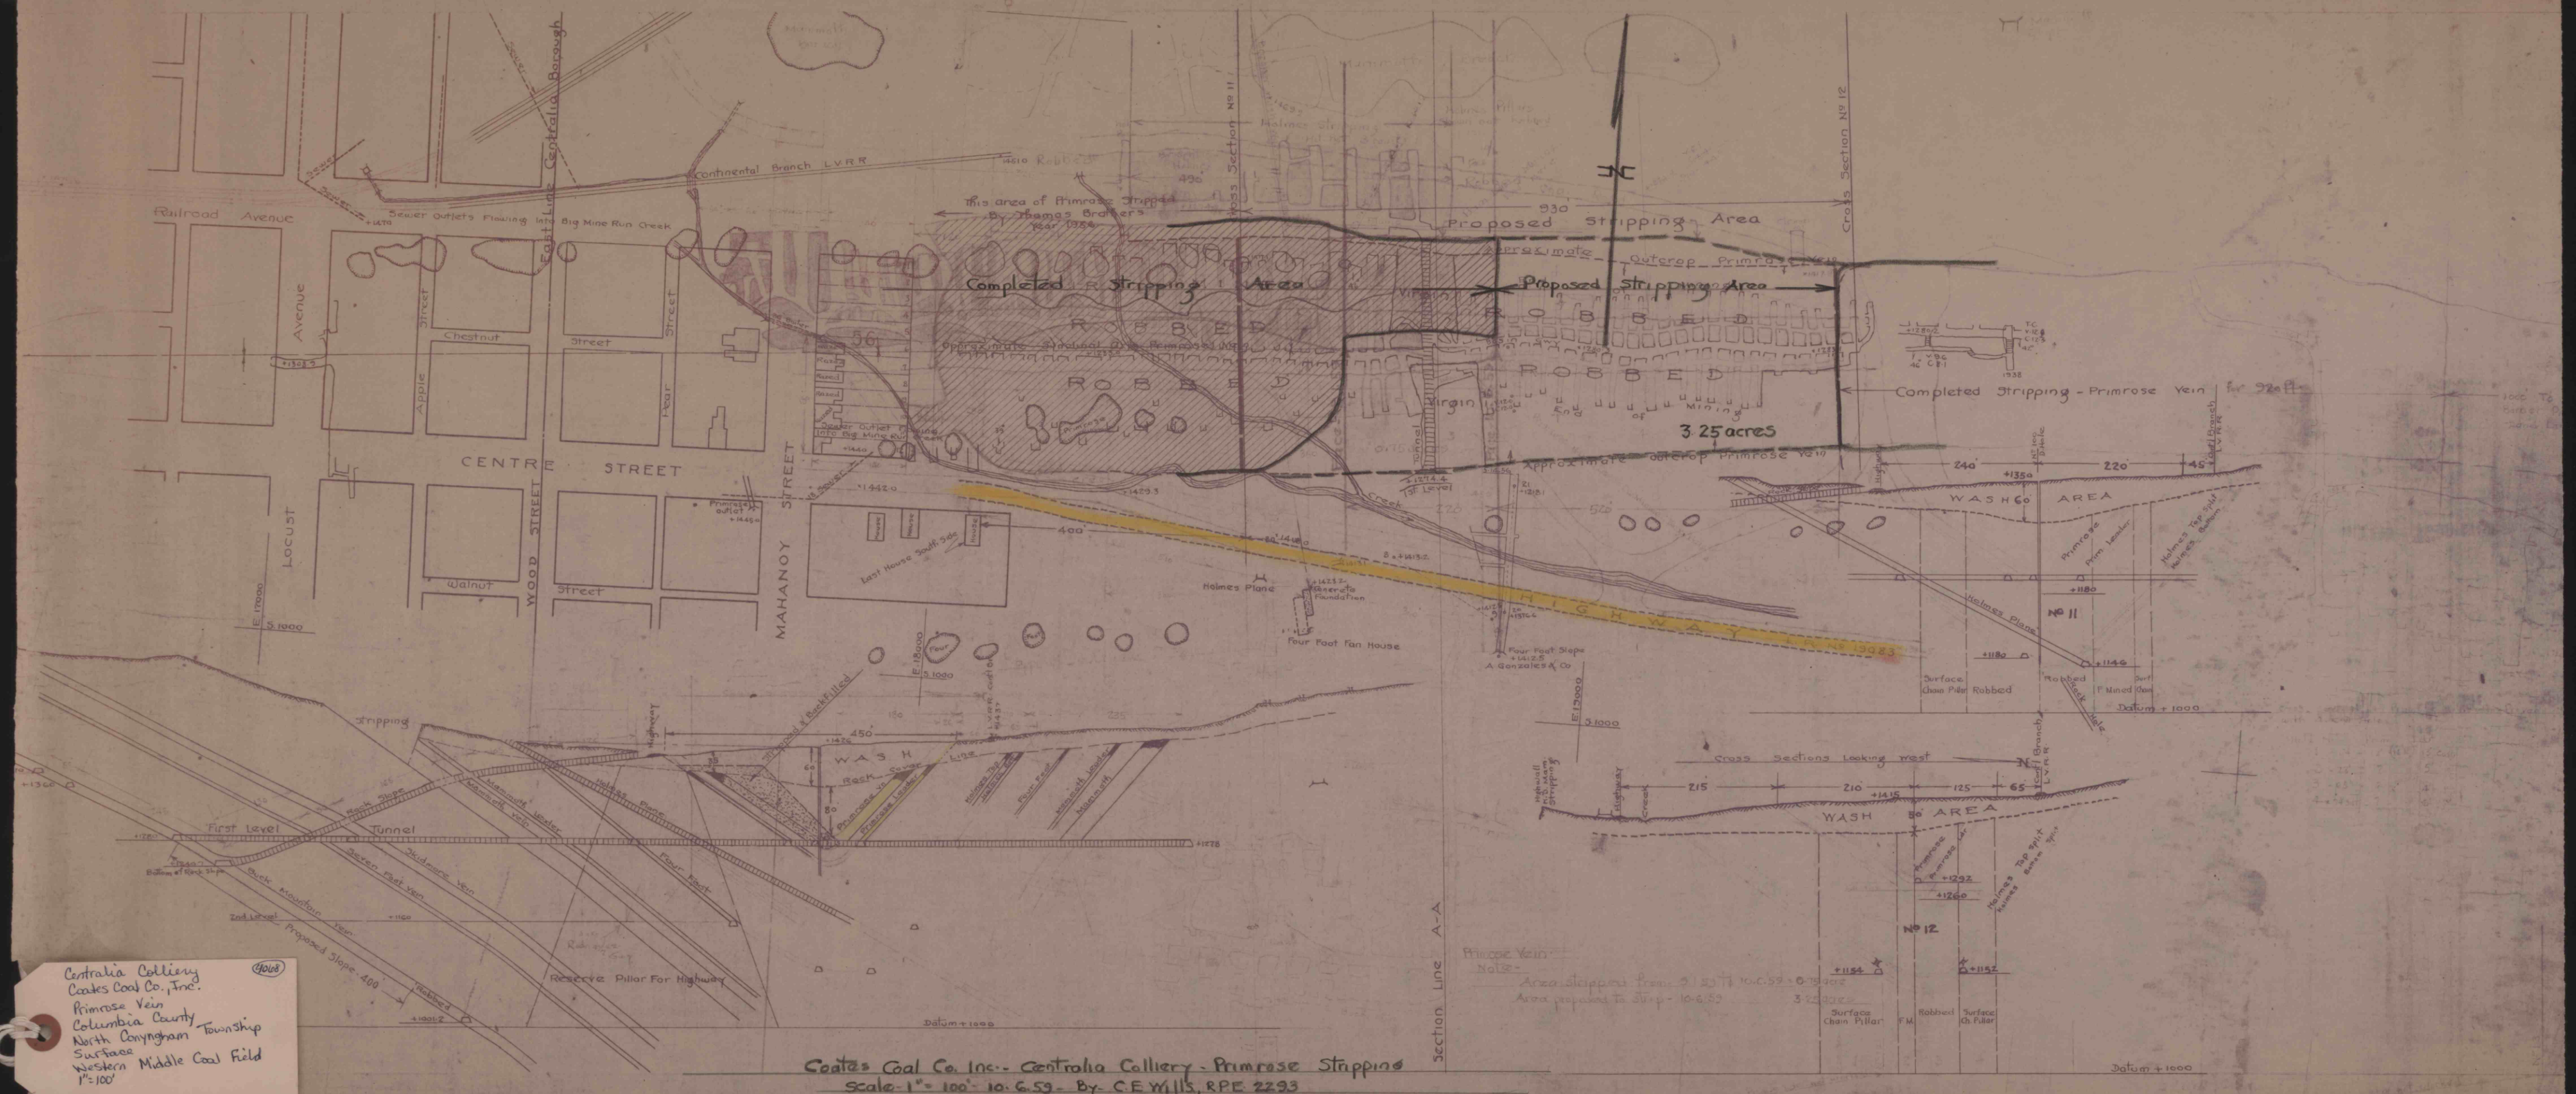

Centralia Colliery
Coates Coal Co., Inc.
Primrose Vein
Columbia County Township
North Conyngham
Surface
Western Middle Coal Field
1"=100'

Coates Coal Co. Inc. - Centralia Colliery - Primrose Stripping
Scale - 1" = 100' 10-6-59 - By C.E. Mills, RPE 2293