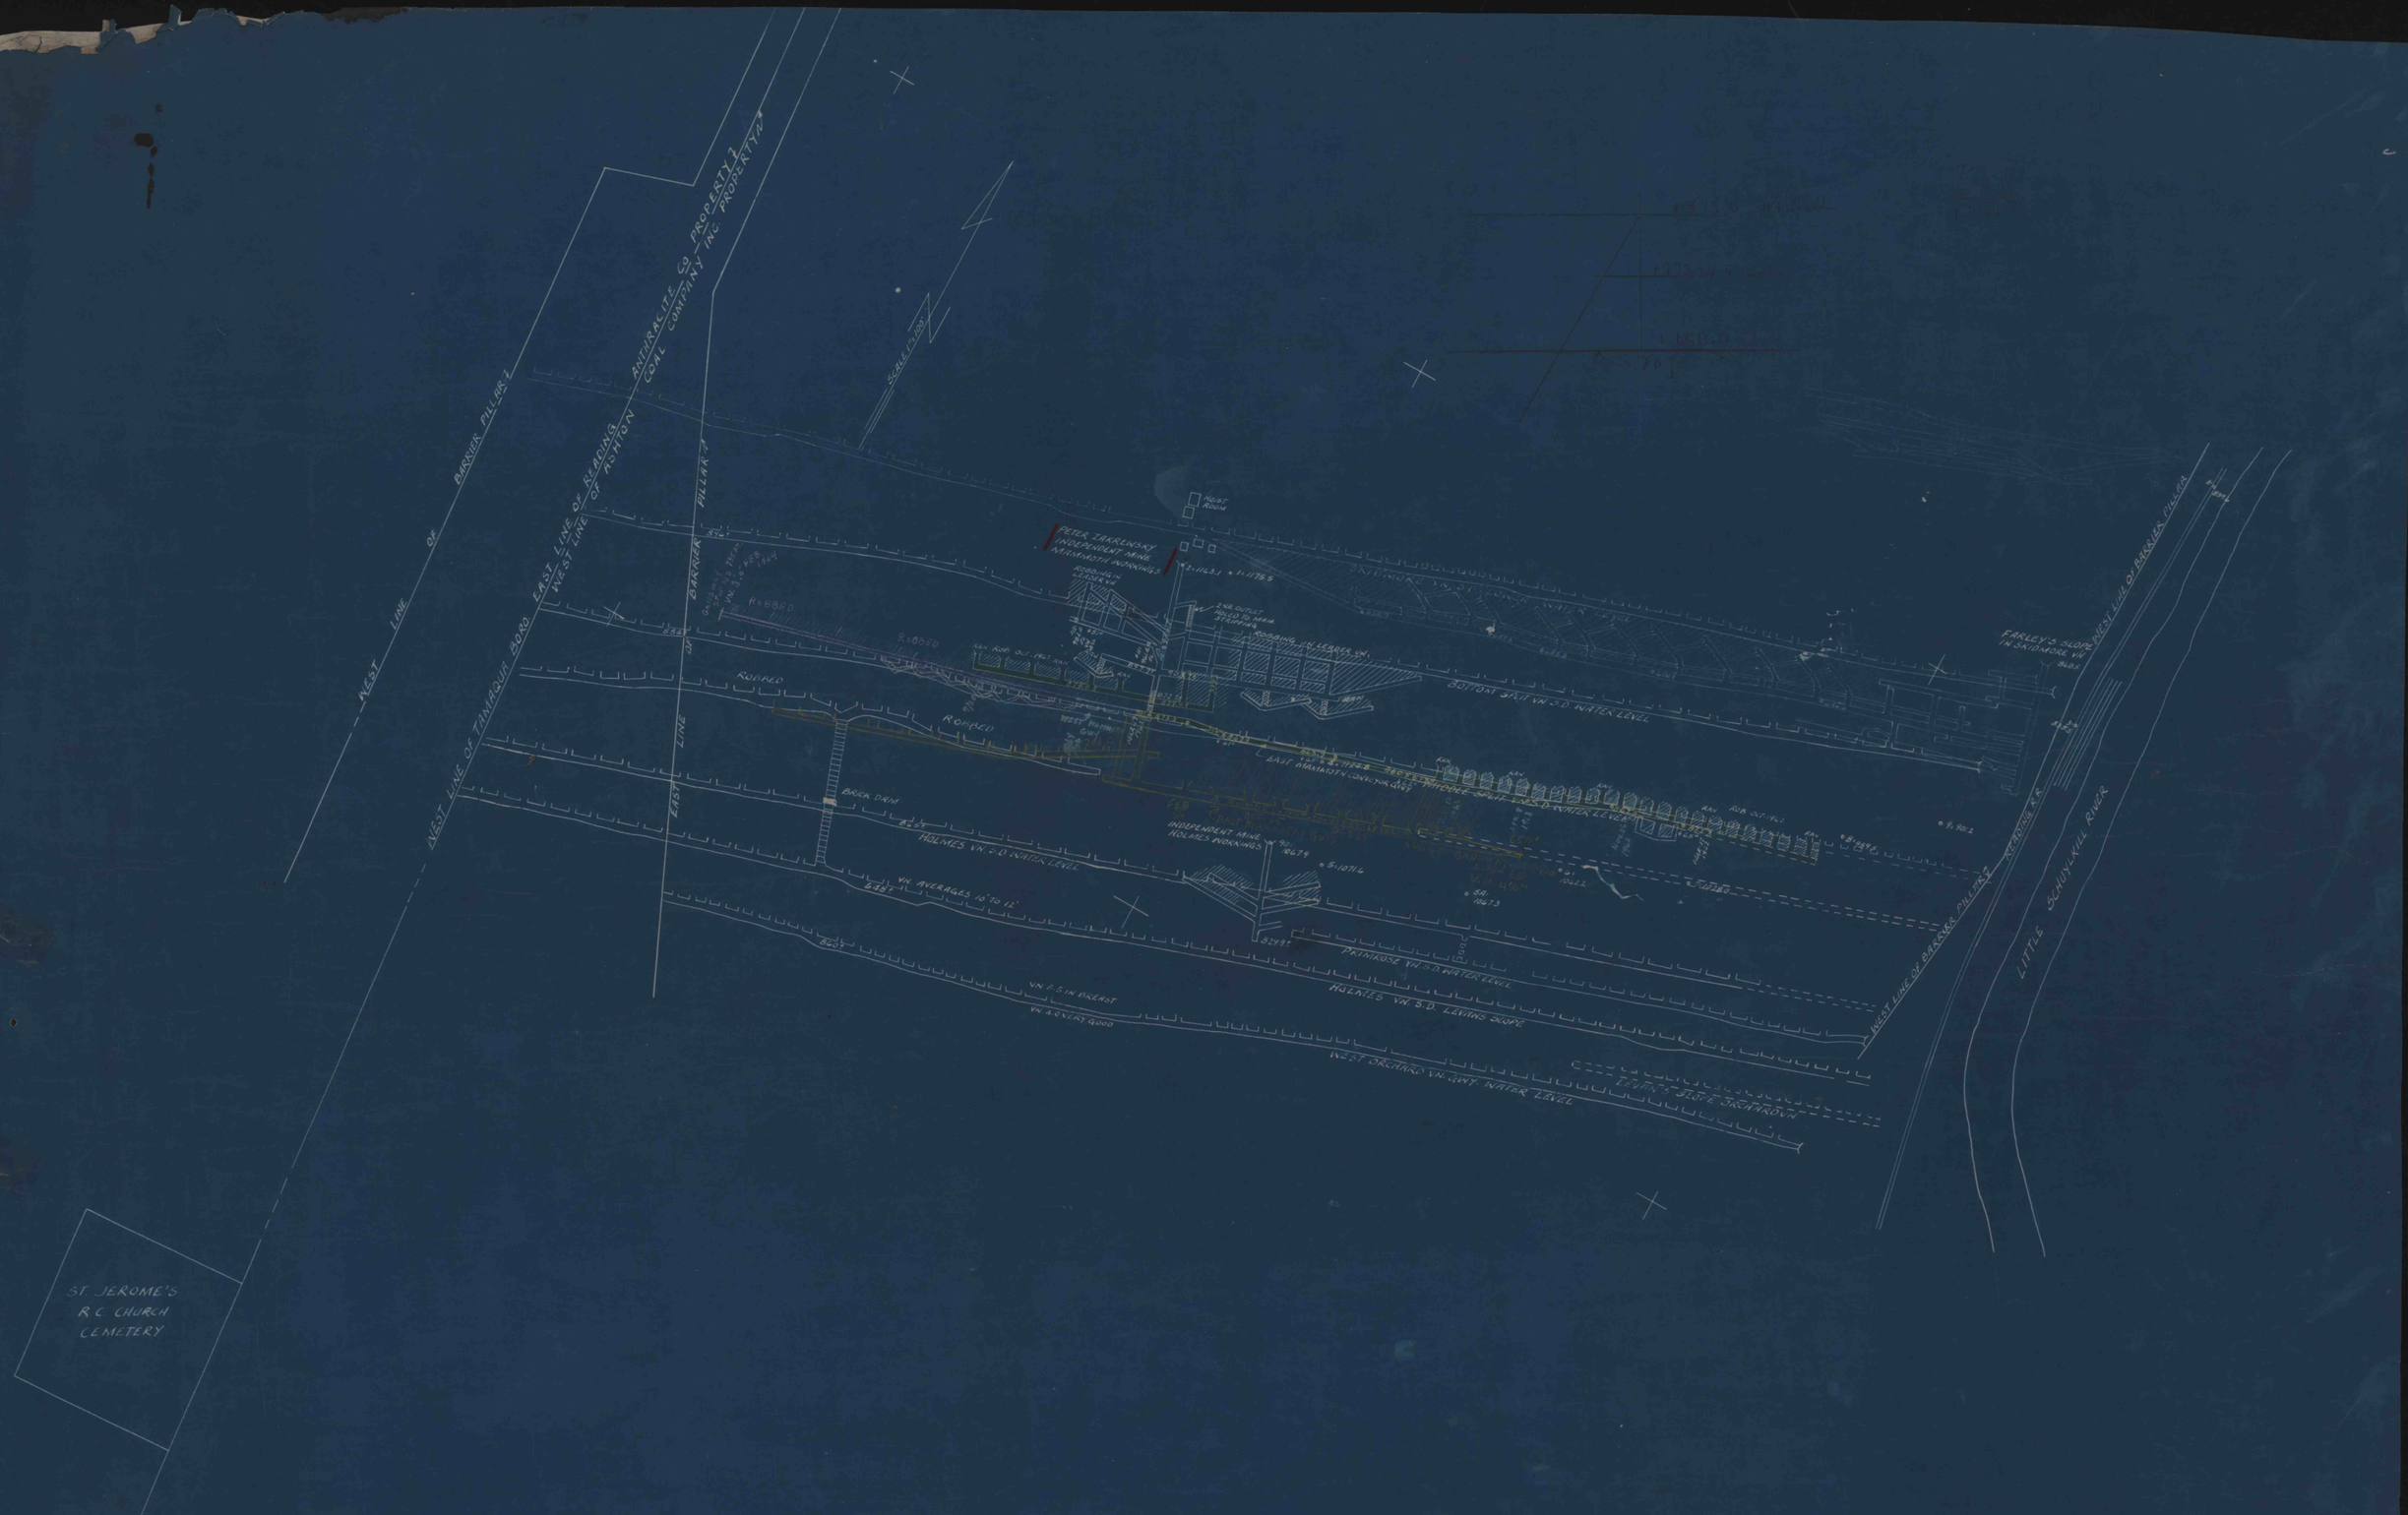
WEST LINE OF BARNER PILLAR
WEST LINE OF TINKIQUE BORD
EAST LINE OF READING ANTHRACITE CO PROPERTY
WEST LINE OF ASHTON COAL COMPANY INC. PROPERTY
EAST LINE OF PILLAR
SCALE 1:100
PETER TARKOWSKI INDEPENDENT MINE MAMMOTH WORKINGS
ROBBING
ROBBED
BREAK DAM
INDEPENDENT MINE HOLMES WORKINGS
HOLMES VN. S.D. WATER LEVEL
VN. AVERAGES 18" TO 12"
BOTTOM SPLIT VN. S.D. WATER LEVEL
EAST MAMMOTH VN. S.D. WATER LEVEL
PRIMROSE VN. S.D. WATER LEVEL
HOLMES VN. S.D. LEVINS SLOPE
WEST ORCHARD VN. GNY. WATER LEVEL
LEVINS SLOPE SHOVELROOM
FARLEY'S SLOPE IN SKIDMORE MINE
WEST LINE OF BARNER PILLAR
LITTLE SCHUYLKILL RIVER
ST. JEROME'S R.C. CHURCH CEMETERY