


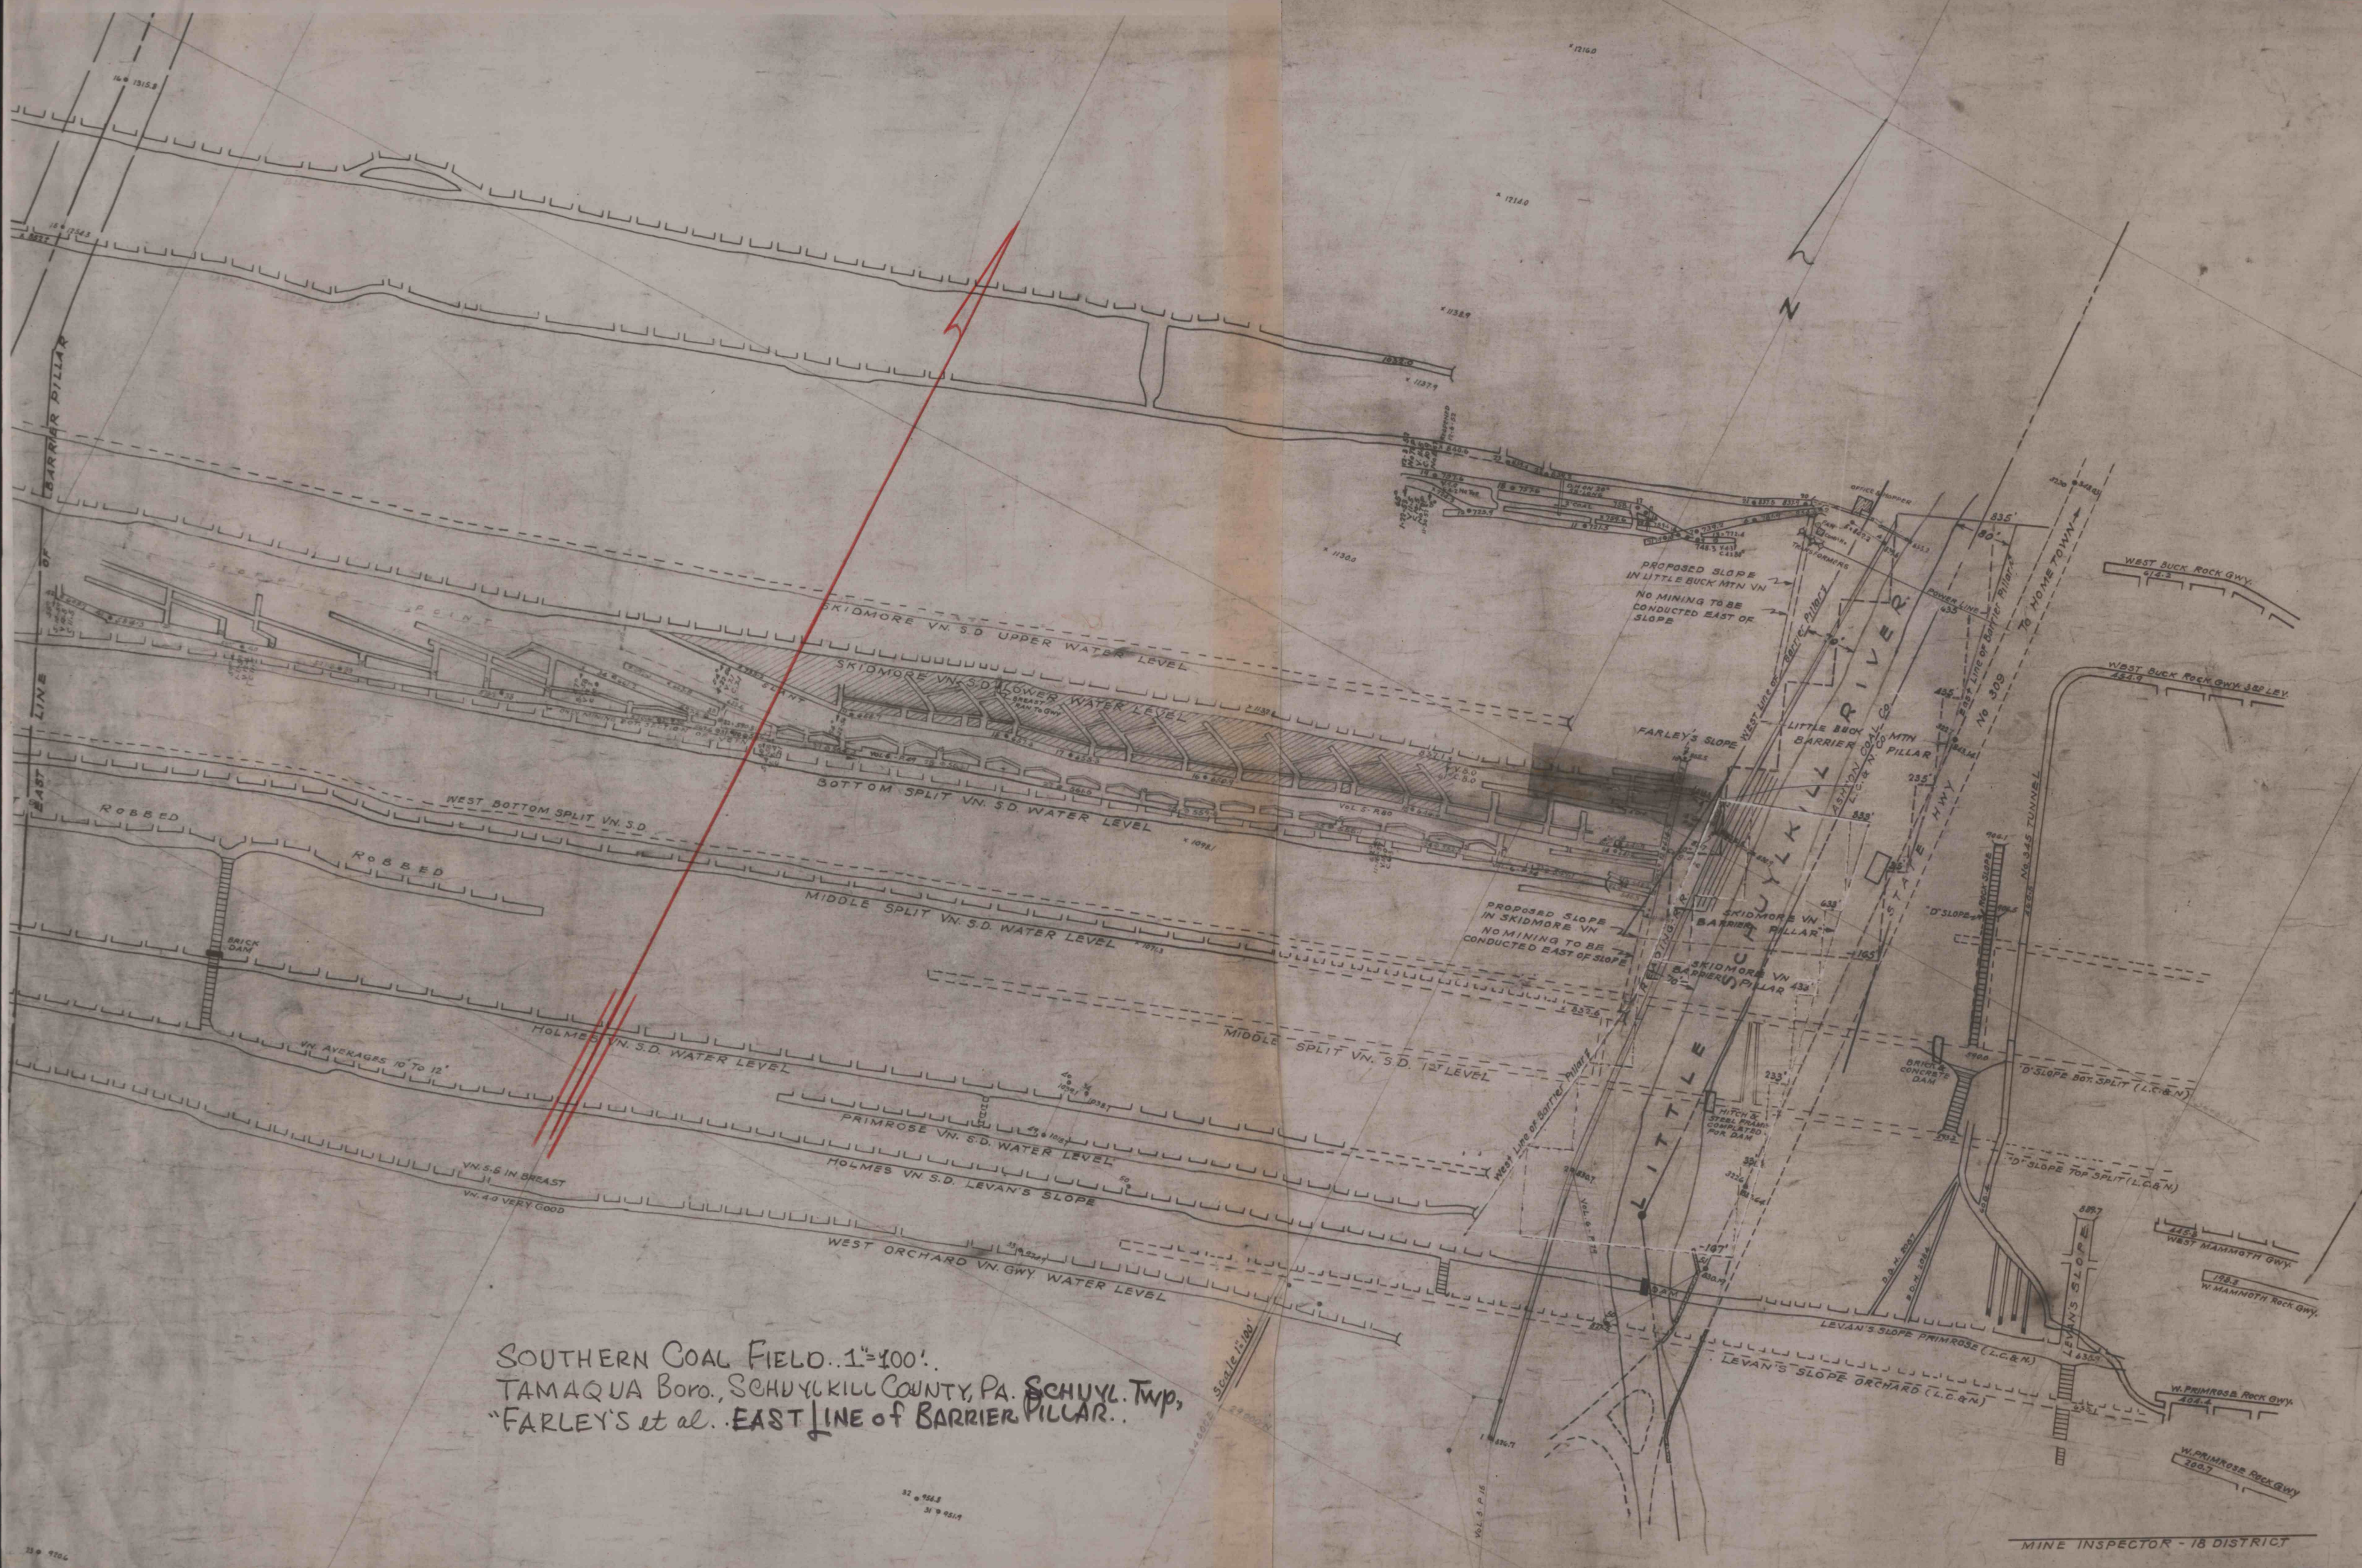

SOUTHERN COAL FIELD..1"=100'.
TAMAQUA Boro., SCHUYLKILL COUNTY, PA. SCHUYLK. Twp.,
"FARLEY'S et al. EAST LINE OF BARRIER PILLAR."