


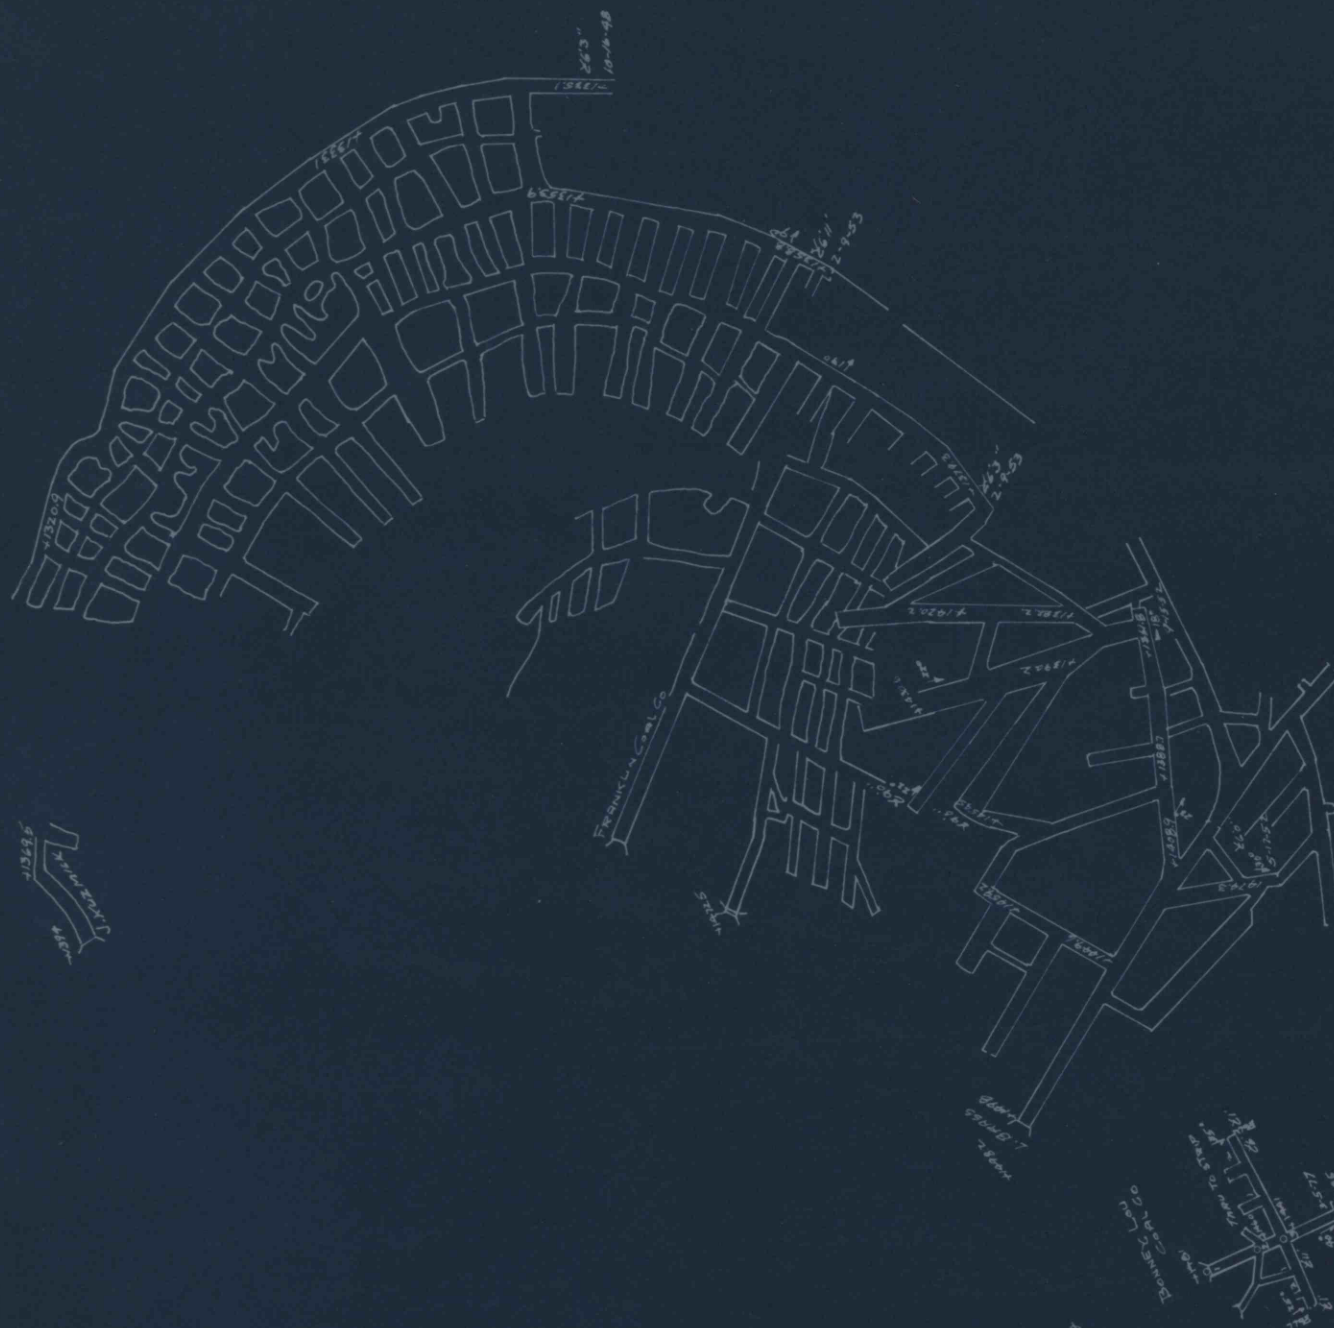

WESTERN MIDDLE COAL FIELD.
 FRANKLIN COAL CO., LYKENS VEIN, 1"=100'-
 COAL TWP, NORTHUMBERLAND COUNTY PA.
 WORKINGS - BONNIE LOU COAL CO. J. KUZMICK,
 F. MOTTO.
 MARCH 5, 1977.

western middle field
 1"=100'
 Franklin Coal co., other
 workings=Bonnie Lou Coal
 co., F. Motto, J. Kuzmick.
 Lykens vein., 1=print.
 Coal twp. Northumberland
 county pa.
 4071

LYKENS VEIN
 1977