


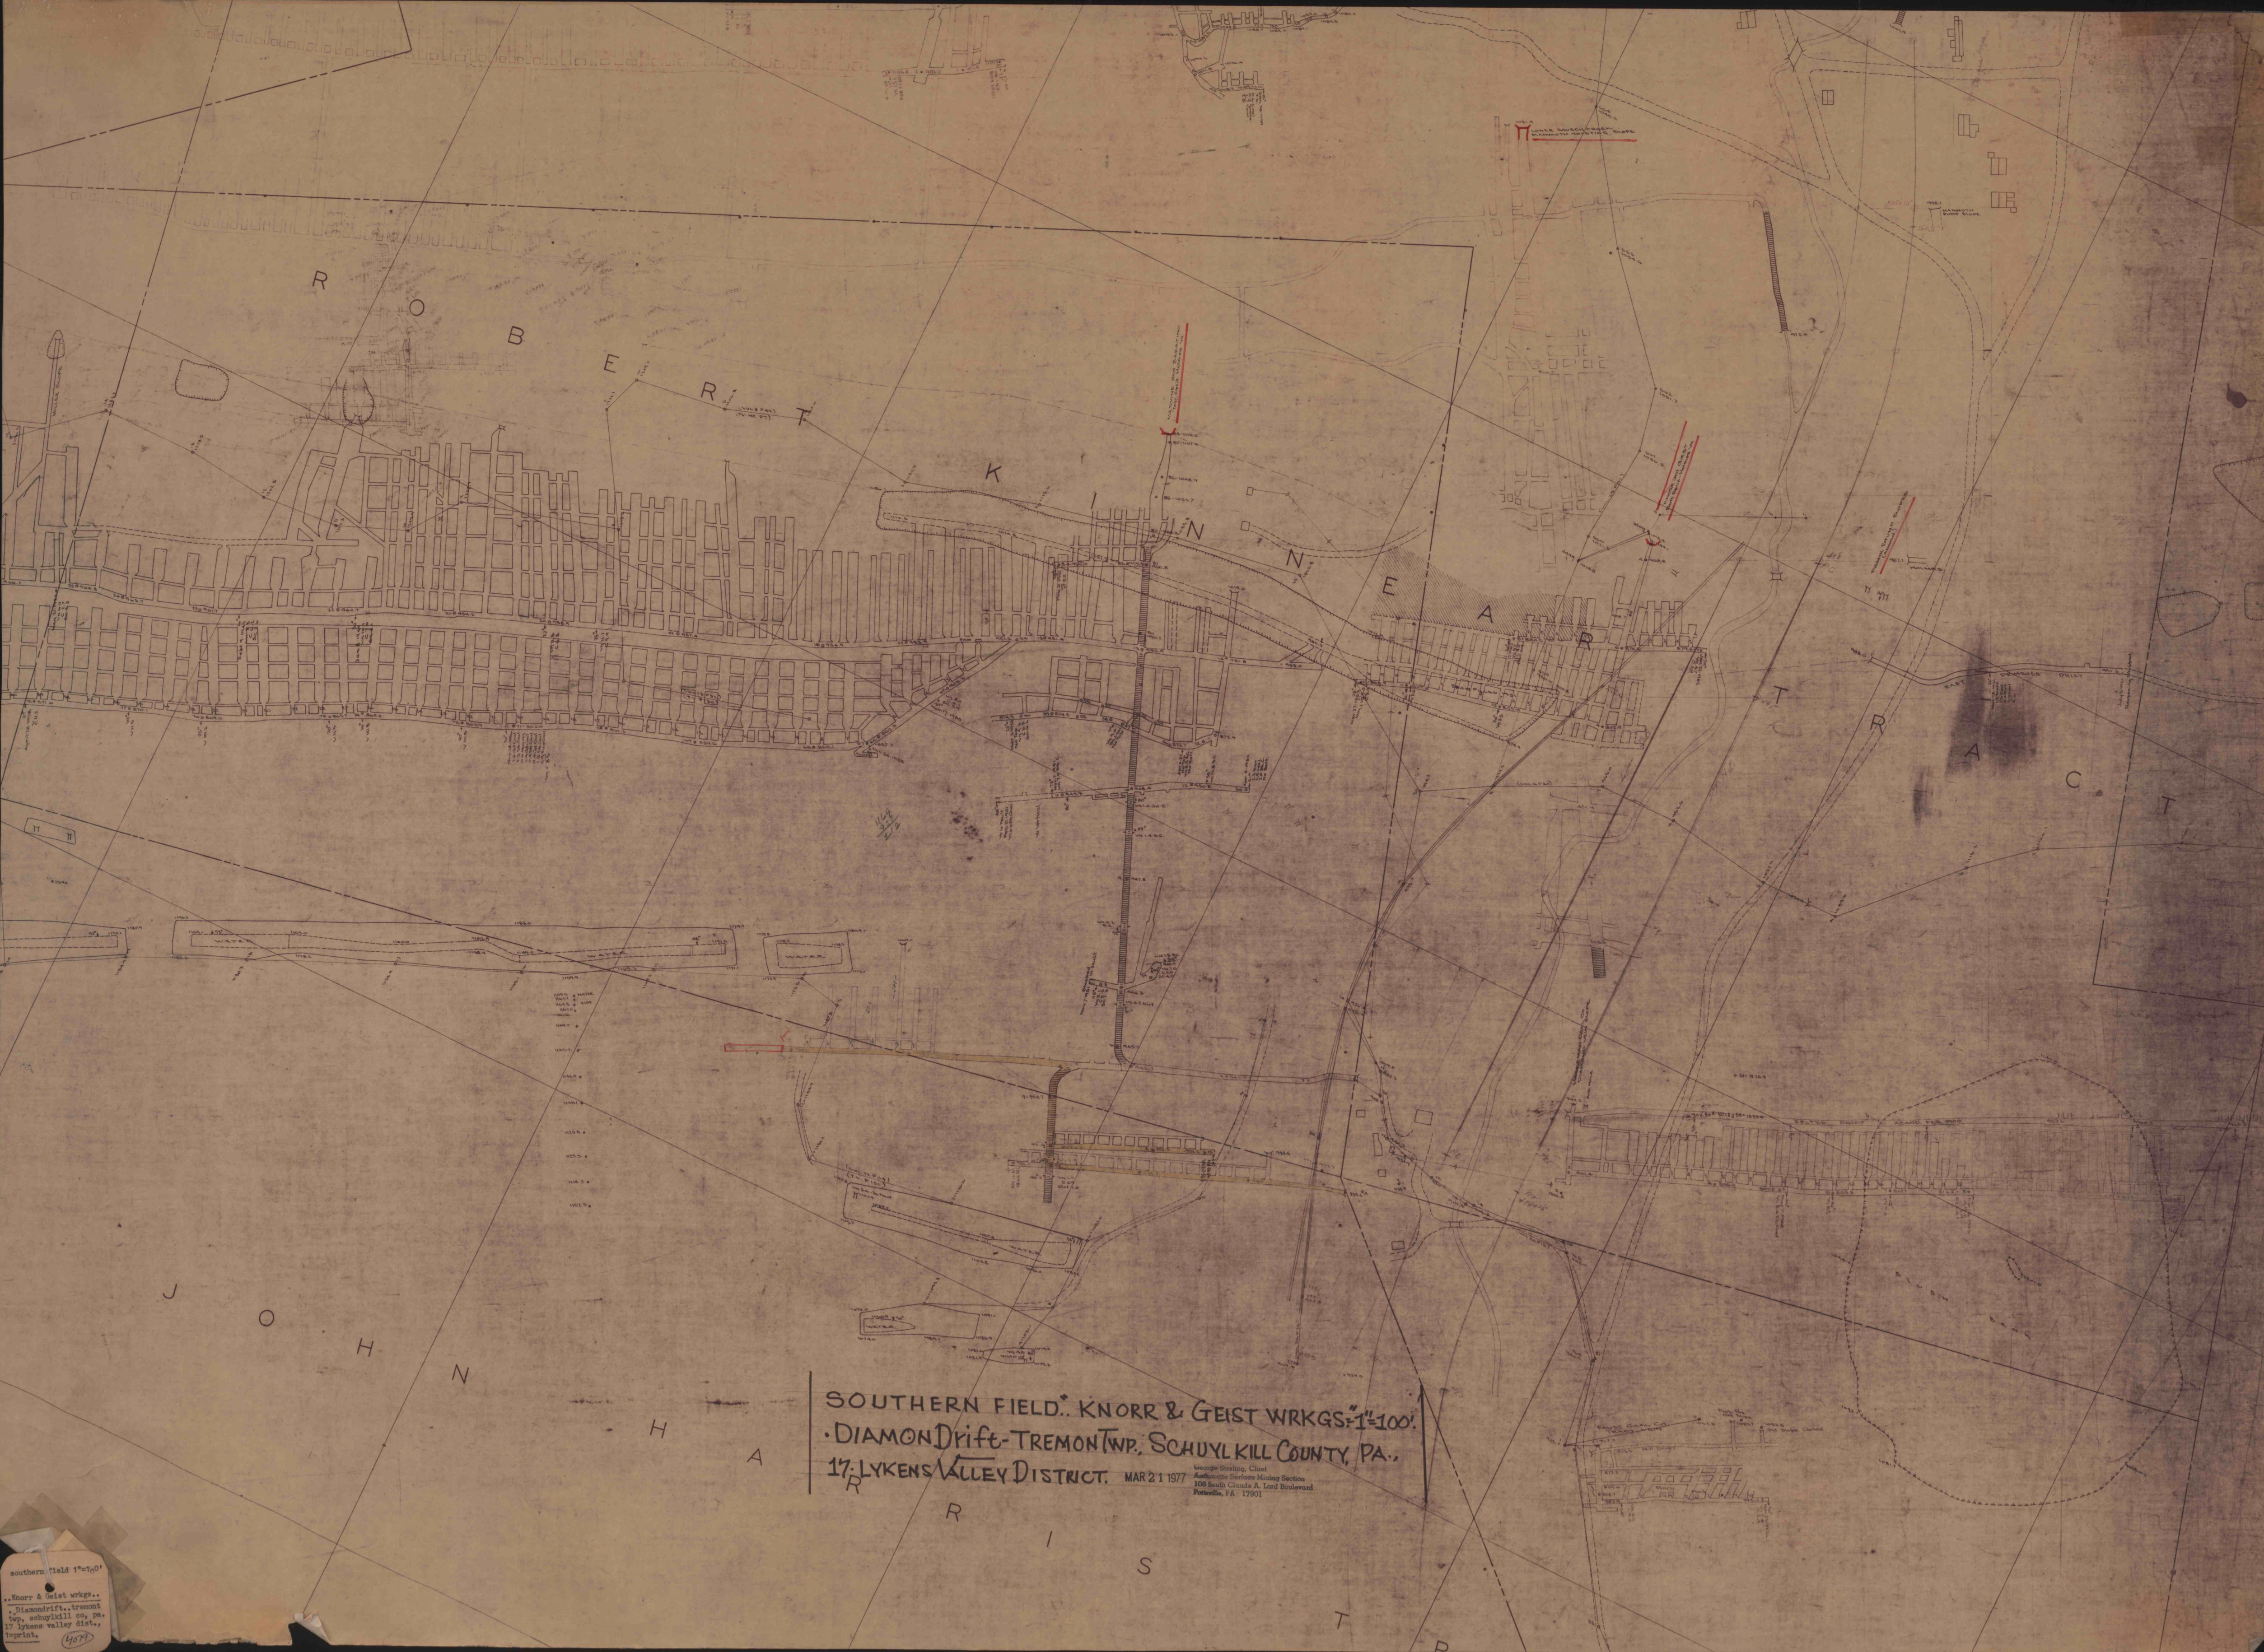

SOUTHERN FIELD. KNORR & GEIST WRKGS. 1:100.
DIAMOND DRIFT-TREMON TWP. SCHUYLKILL COUNTY, PA.
17 LYKENS VALLEY DISTRICT. MAR 21 1977

George Staring, Chief
Katharine Surface Mining Section
108 South Claude A. Lord Boulevard
Pottsville, PA 17801

southern field 1:100
Knorr & Geist wrkgs.
Diamond Drift, Tremont
Twp. Schuylkill Co. Pa.
17 Lykens Valley Dist.
1:100 print.
4/8/77