


PENN. COAL COLLEGE

BROADWELL
BOTTOM SPLIT
Scale 1" = 100' Datum Tide

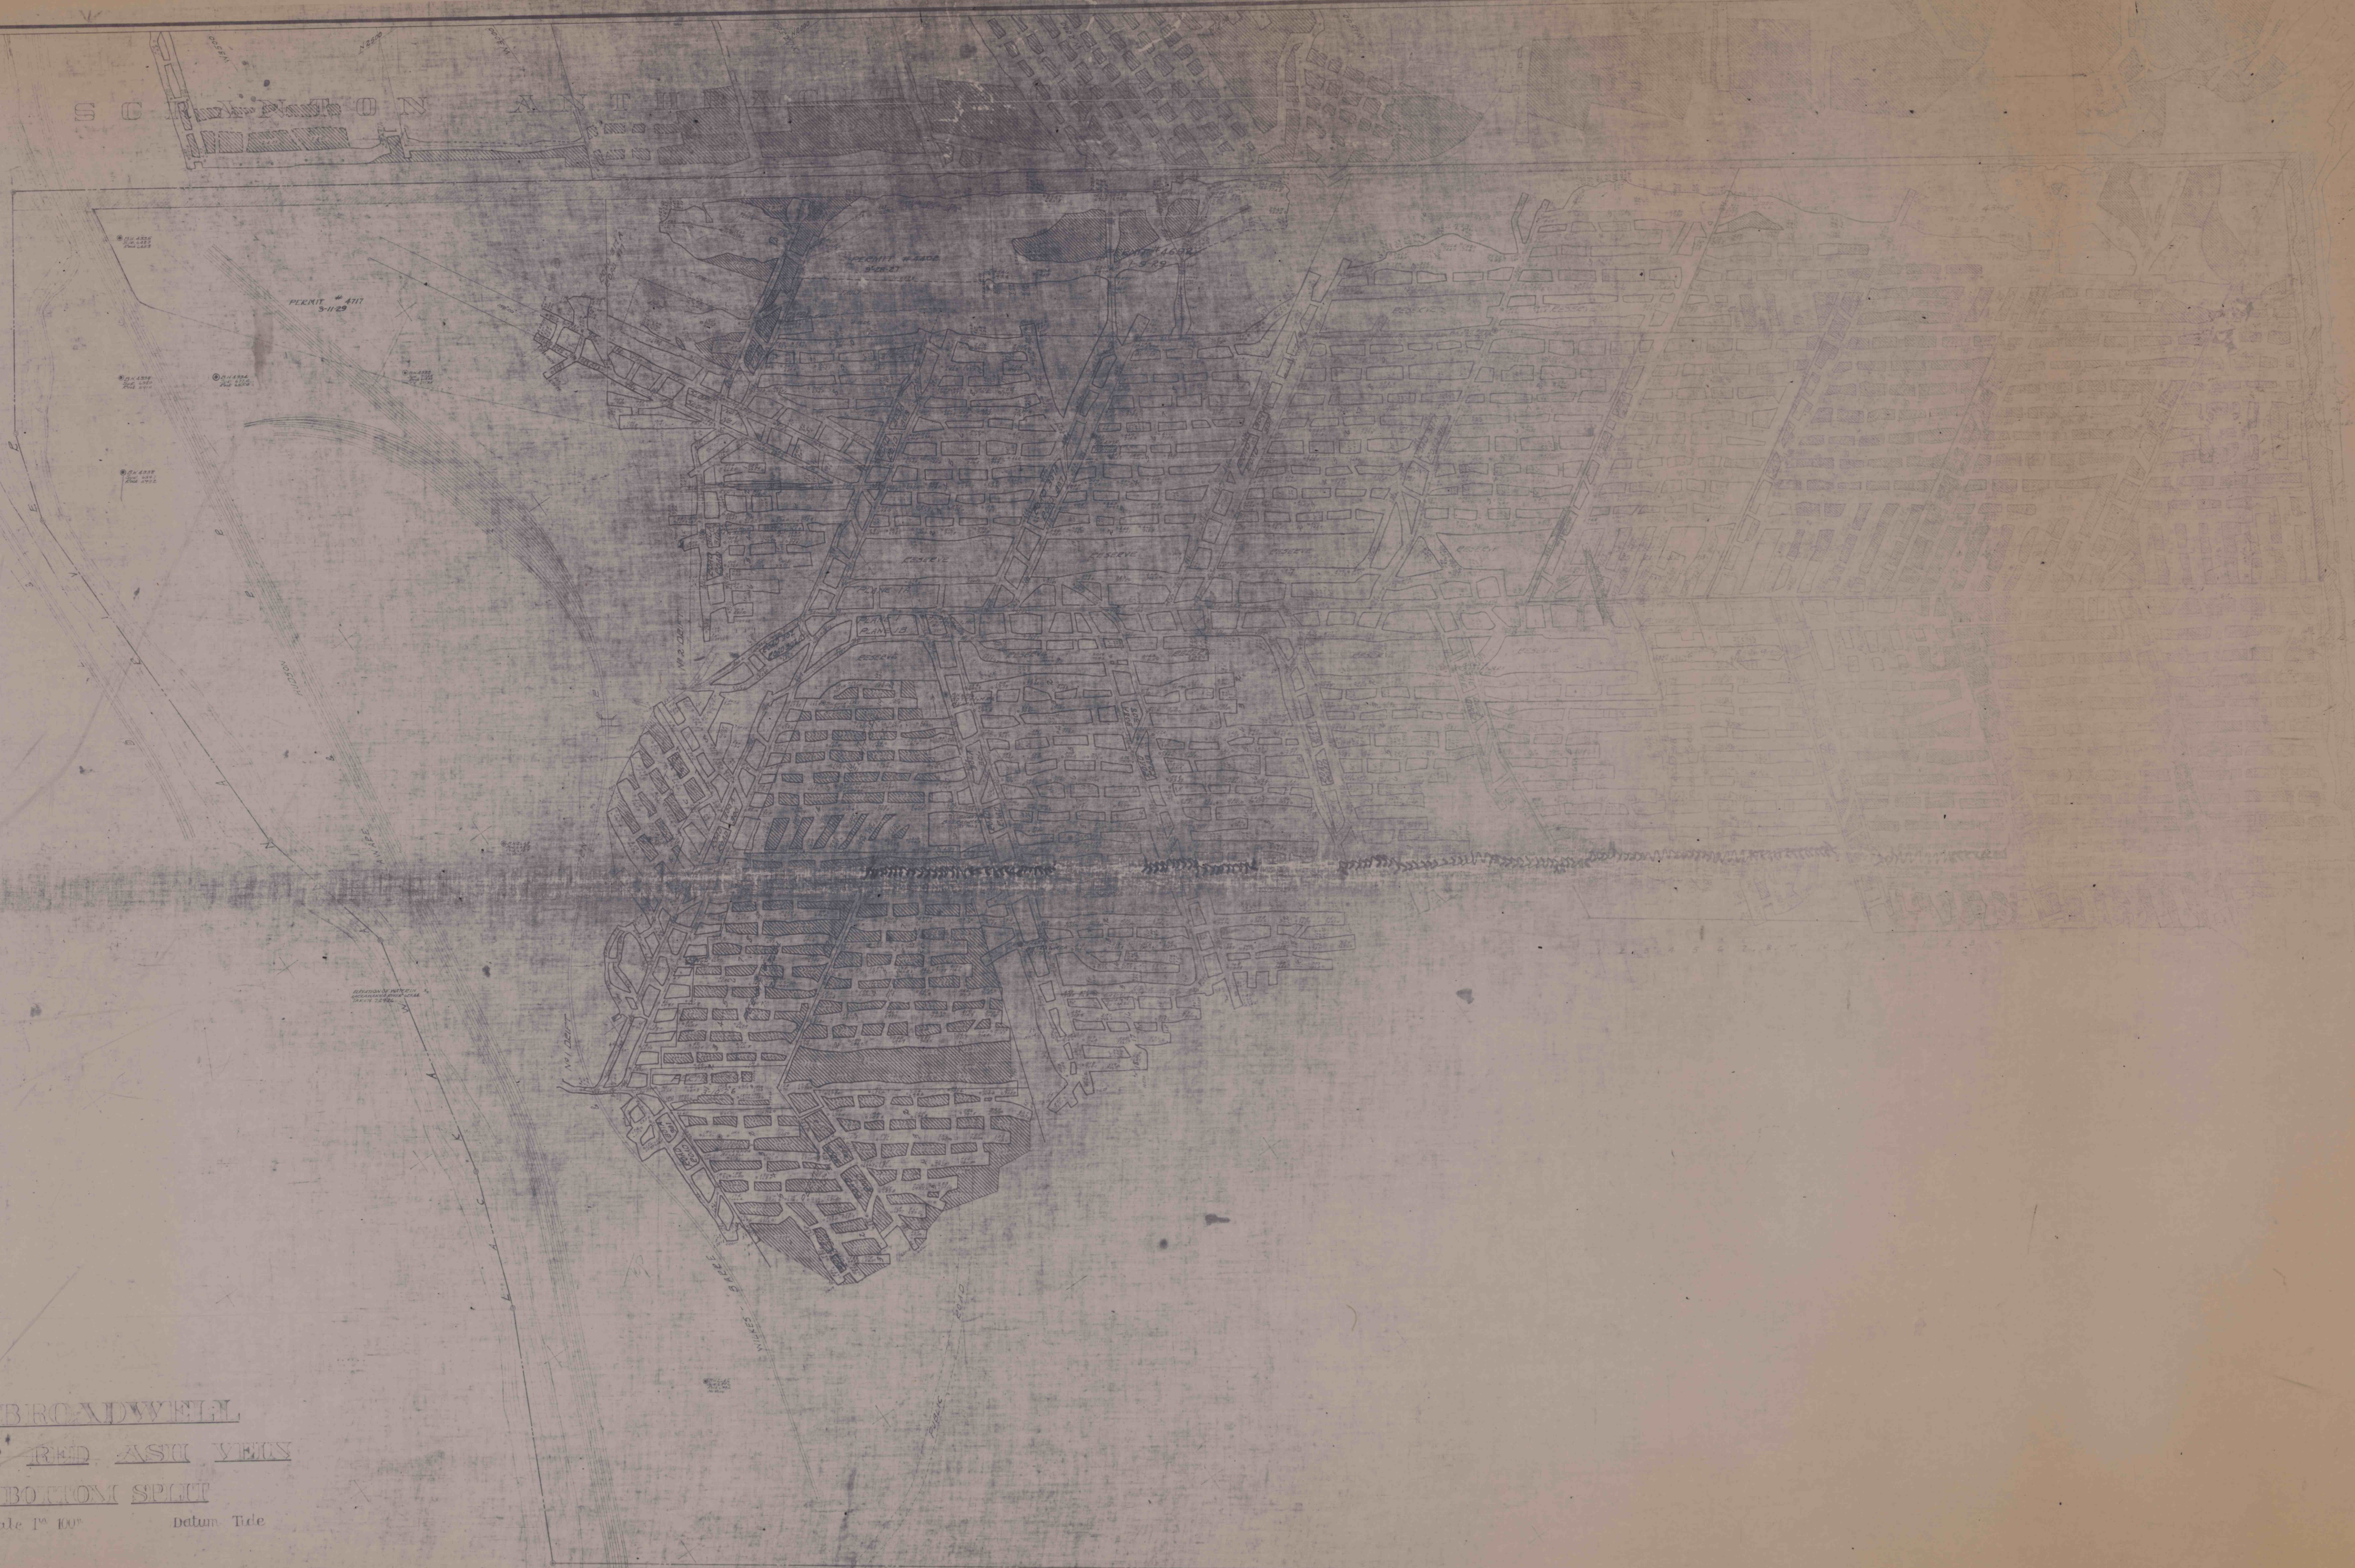

Bottom Split