


Eastern Middle Field:
CLIFF COAL COMPANY
BEAVER TWP.
SCOTCH VALLEY, COLUMBIA COUNTY
JANUARY 6 1925
OCT 11 1972
MF - 4-OF-4
SCALE 1" = 100'

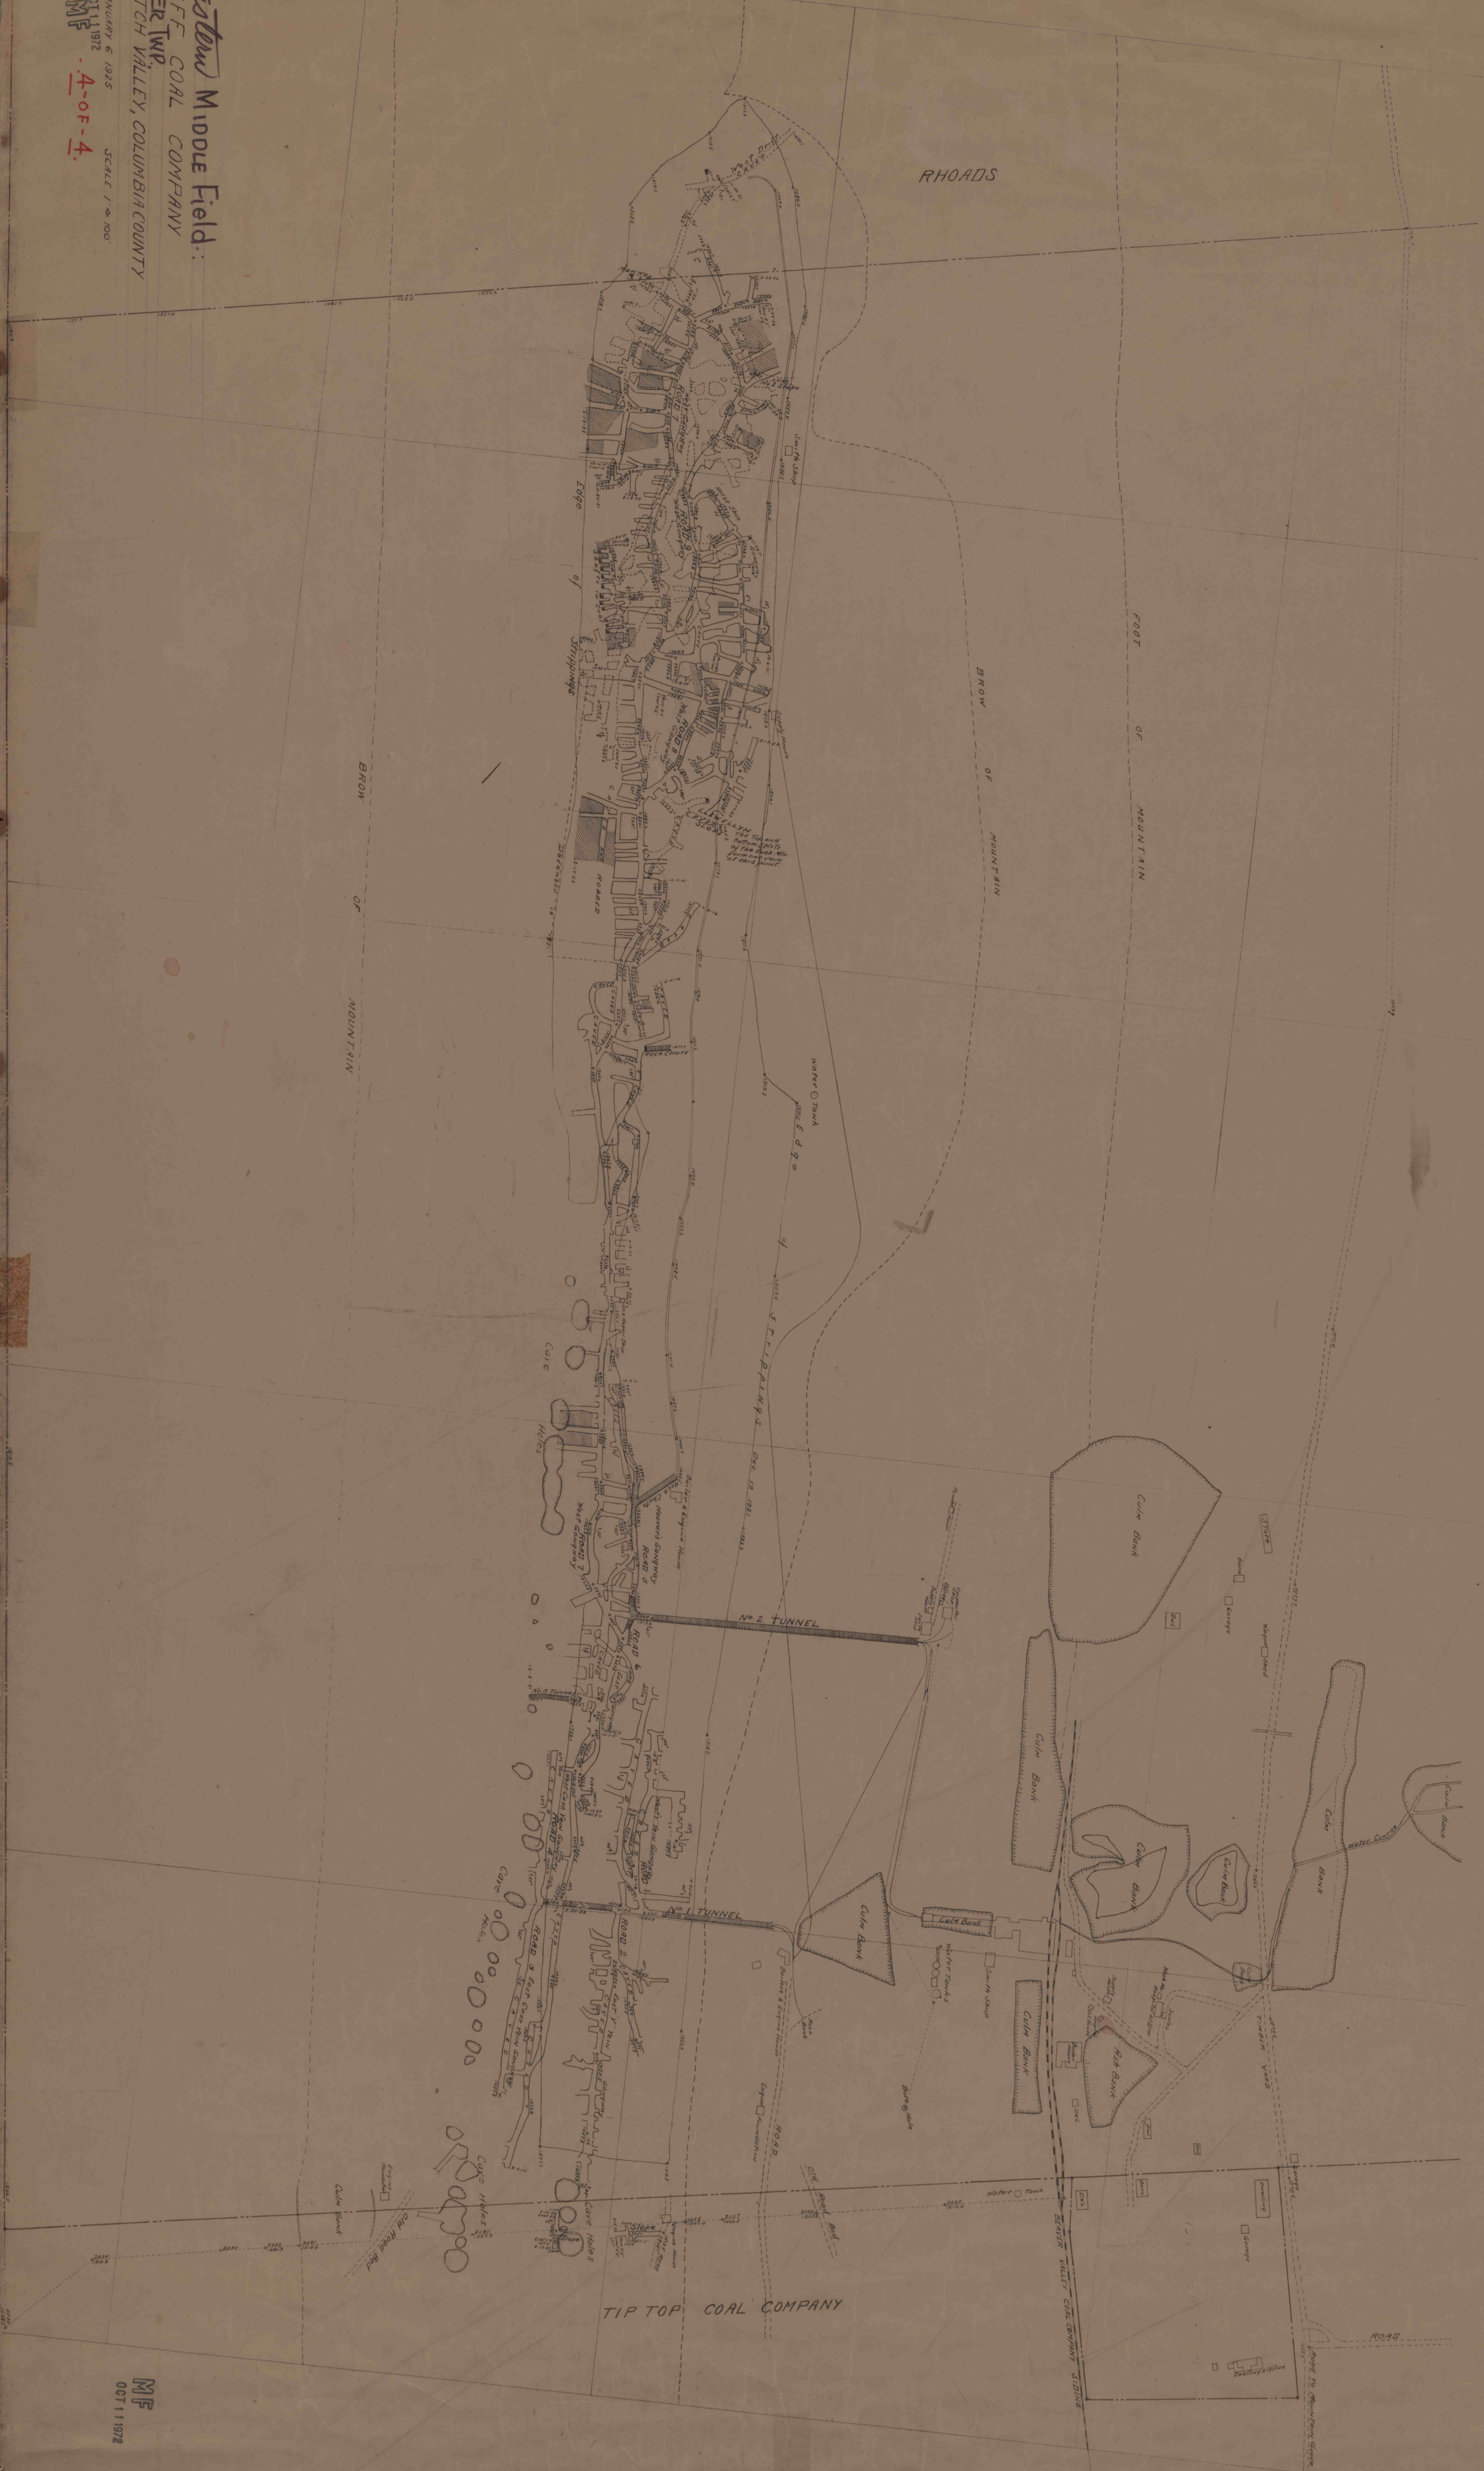

MF
OCT 11 1972