


Eastern Middle Field
 MAP SHOWING
 THE ACCESSIBLE MINE WORKINGS AND OUTSIDE IMPROVEMENTS
 BEAVER VALLEY COAL COMPANY MINES
 ON MCGAULEY MOUNTAIN NEAR SCOTCH VALLEY STATION
 COLUMBIA COUNTY - PENNSYLVANIA
 Scale 1 inch = 100 feet
 Beaver Township

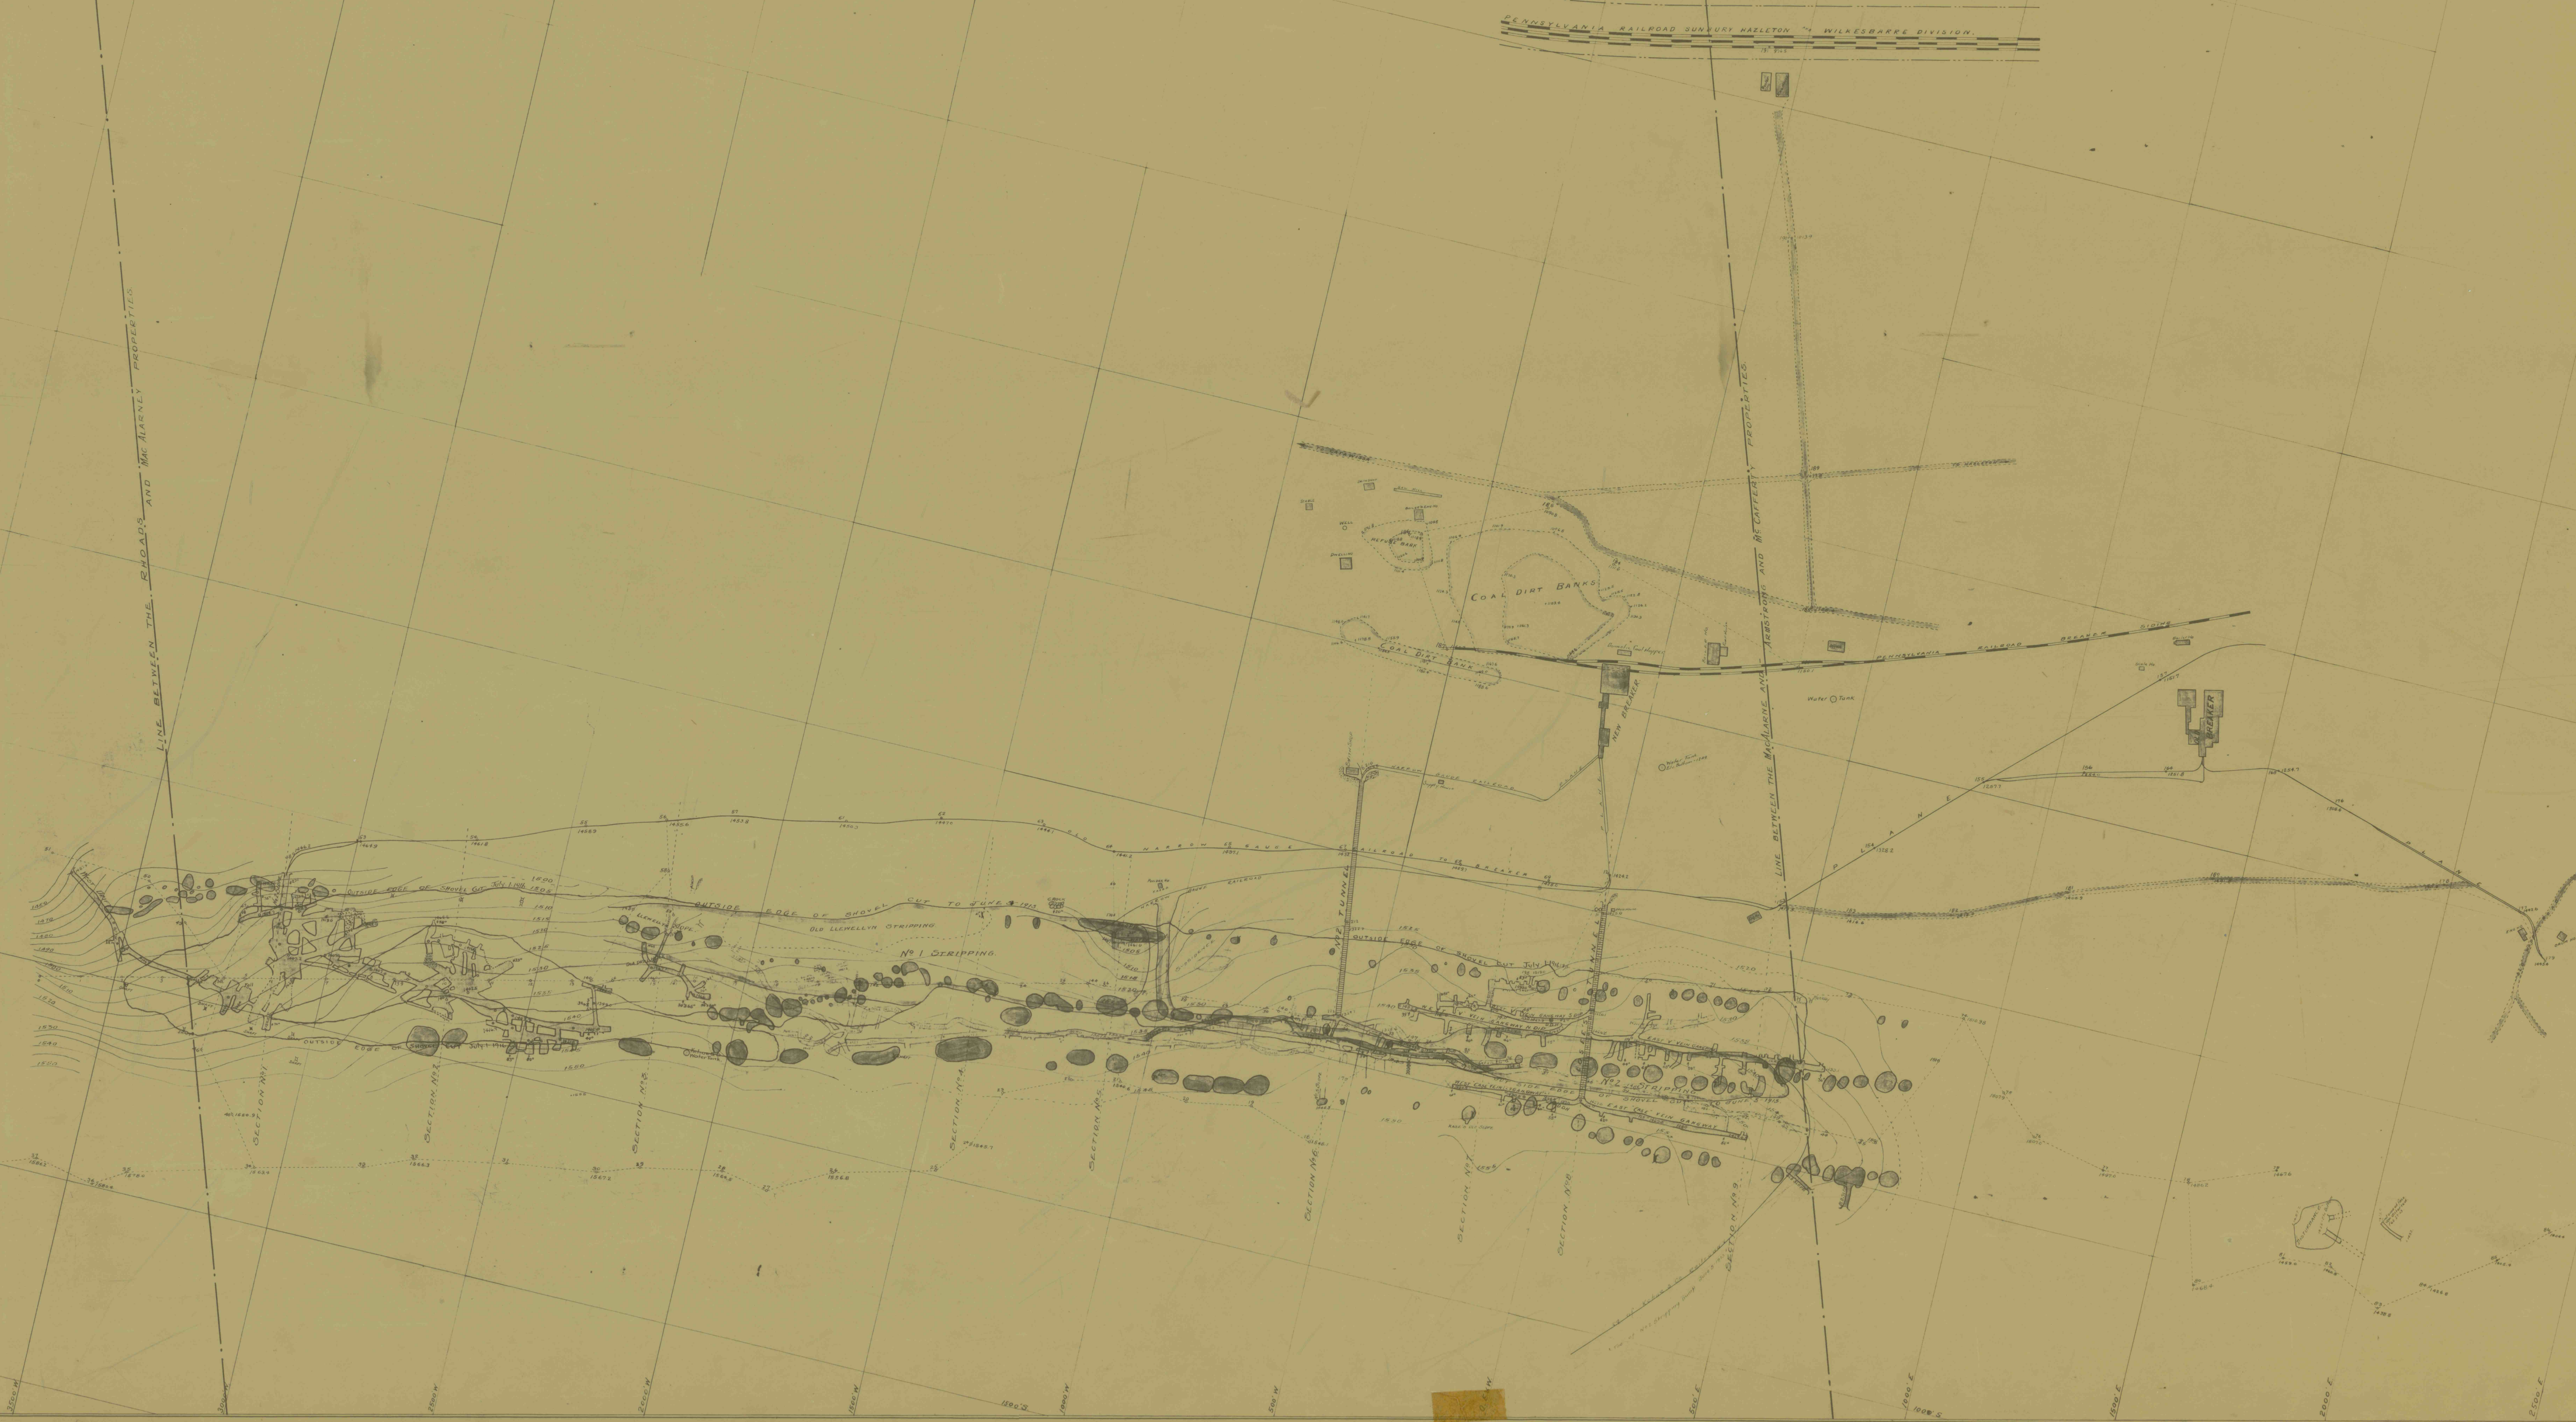

ME
 OCT 11 1872

2-OF-4

Beaver Valley Coal Co.
 Beaver Township, Columbia County
 Pa.
 Oct. 11, 1872

ME
 OCT 11 1872